

FORM U-1 MANUFACTURERS' DATA REPORT FOR UNFIRED PRESSURE VESSELS

As required by the Provisions of the ASME Code Rules and the National Board

B3-3603

1. Manufactured by Arthur F. Smith, Inc. 201 S. W. 12th Avenue-Pomp. Bch, Florida
(Name and address of Manufacturer) Pos.#
2. Manufactured for Hoffmann-La Roche, Nutley, New Jersey 07110 B3 3600 #99695
(Name and address of Purchaser)
3. Type Vert. Kind Jacketed Vessel No. (7650) (Fla.) Nat'l Bd. No. 9 Yr. Built 1971
(Horiz. or Vert.) (Tank, Jacketed, Heat Exch.) (Mfrs.' Serial) (State & State No.)

Items 4-9 incl. to be completed for single wall vessels (such as air tanks), jackets of jacketed vessels, or shells of Heat Exchangers

4. SHELL: Material SA 285 C T.S. 55,000 Nominal Thickness 1/2 in. Corrosion Allowance in. Diam. 3 ft. 5 in. Length 10 ft. 1 1/4 in.
(Kind and Spec. No.) (Plg. or F. B. & Spec. Min. T.S.)
5. SEAMS: Long Dbl. Wld. Butt H.T. No X.R. No Sectioned No Efficiency 70 %
(Welded, Dbl., Single, Lap, Butt) (Yes or No)¹

If riveted describe seams fully on reverse side of form

6. HEADS: (a) Material SA 285 C T.S. 55,000 (b) Material T.S.
Location (Top, bottom, ends) Thickness Crown Radius Knuckle Radius Elliptical Ratio Conical Apex angle Hemispherical Radius Flat Diameter Side to Pressure (Convex or Concave)

- (a)
 (b)
 If removable, bolts used (Material, Spec. No., T.S., Size, Number) Other fastening (Describe or Attach Sketch)

7. STAYBOLTS: None If hollow Attachment Pitch X Diam.
(Material) (Size of Hole) (Threaded, Welded) (Horiz.) (Vert.) (Nominal)

8. JACKET CLOSURE: Jacket End Rings: SA 285 C; 55,000 psi; 1/2 Nom. Thk.; 1" I.R. Str. Flange
(Describe as ogee & weld, bar, etc. If bar give dimensions, if bolted, describe or sketch)

9. Constructed for max. allowable working press. 225 psi. at max. temp. 700 °F Min. temp. (when less than -20°) °F. Hydrostatic Test Press. 350 psi. Pneumatic Combination

Items 10 and 11 to be completed for tube sections.

10. TUBE SHEETS: Stationary. Material (Kind & Spec. No.) Diam. in. Thickness in. Attachment (Welded, Bolted)
 Floating. Material (Kind & Spec. No.) Diam. in. Thickness in. Attachment

11. TUBES: Material O.D. in. Thickness inches or gage. Number Type (Straight or U)

Items 12-15 incl. to be completed for inner chambers of jacketed vessels, or channels of heat exchangers.

12. SHELL: Material SA 264 T.S. 55,000 Nominal Thickness 15/16 in. Corrosion Allowance in. Diam. 3 ft. 7/8 in. Length 10 ft. 8 in.
(Kind and Spec. No.) (Plg. or F. B. & Spec. Min. T.S.)

13. SEAMS: Long Dbl. Wld. Butt H.T. No X.R. No Sectioned No Efficiency 70 %
(Welded, Dbl., Single, Lap, Butt) (Yes or No)¹ (Spot or Complete) (Yes or No)
- Girth 304 ELC H.T. X.R. 304 ELC Sectioned No. of courses

If riveted describe seams fully on reverse side of form

14. Heads (a) Material SA 240 T.S. 70,000 (b) Material SA 240 T.S. 70,000 (c) Material T.S.
Location Thickness Crown Radius Knuckle Radius Elliptical Ratio Conical Apex angle Hemispherical Radius Flat Diameter Side to Pressure (Convex or Concave)
- (a) Top, ~~XXXX~~ 3/8 36 2 1/4 Convex
 (b) ~~XXXX~~ Bottom 3/8 38 3 Convex
 (c) Floating

- If removable, bolts used (a) 304 s/s; 20,000; 1" - 12 (Material, Spec. No., T.S., Size, Number) (b) 304 s/s; 20,000 - 1" - 8
 (c) Other fastening (Describe or Attach Sketch)

15. Constructed for max. allowable working press. psi. at max. temp. °F Min. temp. (when less than -20°) °F. Hydrostatic Test Press. psi. Pneumatic Combination

Items below to be completed for all Vessels where applicable.

16. SAFETY VALVE OUTLETS: Number 1 Size 1 1/2" Location Upper End of Shell

Purpose (Inlet, Outlet, Drain)	Number	Diam. or Size	Type	Material	Thickness	Reinforcement Material	How Attached
Inlet	1	1 1/2"-Sch. 40	Flgd. Pipe	SA-53	.145	None	Welded
Outlet	1	1 1/2"-Sch. 40	Flgd. Pipe	SA-53	.145	None	Welded
Drain	1	3/4"-3000 lbs	coupling	SA-53	.1625	None	Welded

18. INSPECTION Manholes, No. Size Location
 OPENINGS: Handholes, No. Size Location
 Threaded, No. Size Location
19. SUPPORTS: Skirt (Yes or No) Lugs 4 (Number) Legs None (Number) Other None (Describe) Attached Welded (Where & How)

20. REMARKS: Molecular Distillation Unit with Steam Pressure Jacket. Internal pressure varies from atmosphere to 10 microns (15 psi).

(Brief description of purpose of the vessel, as Air Tank, After Cooler, Jacketed Cooker, etc. State contents of each part.)
¹ If Postweld Heat-Treated
² List other internal or external pressures with coincident temperature when applicable.

EVR 152

99695

We certify that the statements made in this report are correct and that all details of design, material, construction, and workmanship of this unfired pressure vessel conform to the ASME Code for Unfired Pressure Vessels.

Date. **April 23**, 19**71**. Signed.... **Arthur F. Smith, Inc.**..... By **James La Valley**
Manufacturer

Certificate of Authorization Expires..... **November 12, 1971**.....

CERTIFICATE OF SHOP INSPECTION

VESSEL MADE BY ... **Arthur F. Smith, Inc.**..... at **Pompano Beach, Florida**

I, the undersigned, holding a valid commission issued by the National Board of Boiler and Pressure Vessel Inspectors and/or the State of **Florida** and employed by **Maryland Casualty Company** of **Baltimore, Md.** have inspected the pressure vessel described in this manufacturer's data report on **April 23**.....19**71**.., and state that to the best of my knowledge and belief, the manufacturer has constructed this pressure vessel in accordance with the applicable sections of the ASME Boiler and Pressure Vessel Code.

By signing this certificate neither the Inspector nor his employer makes any warranty, expressed or implied, concerning the pressure vessel described in this manufacturer's data report. Furthermore, neither the Inspector nor his employer shall be liable in any manner for any personal injury or property damage or a loss of any kind arising from or connected with this inspection.

Date. **April 23**..... 19**71**..
..... **John P. Howard**..... Commissions **5579**.....
Inspectors Signature Nat'l Board or State and No.


CERTIFICATE OF FIELD ASSEMBLY INSPECTION

I, the undersigned, holding a valid commission issued by the National Board of Boiler and Pressure Vessel Inspectors and/or the State of..... and employed by..... of..... have compared the statements in this manufacturer's data report with the described pressure vessel and state that parts referred to as data items..... not included in the certificate of shop inspection have been inspected by me and that to the best of my knowledge and belief the manufacturer has constructed and assembled this pressure vessel in accordance with the applicable sections of the ASME Boiler and Pressure Vessel Code. The described vessel was inspected and subjected to a hydrostatic test of.....psi.

By signing this certificate neither the Inspector nor his employer makes any warranty, expressed or implied, concerning the pressure vessel described in this manufacturer's data report. Furthermore, neither the Inspector nor his employer shall be liable in any manner for any personal injury or property damage or a loss of any kind arising from or connected with this inspection.

Date..... 19.....
..... Inspectors Signature Commissions Nat'l Board or State and No.

EVP-152

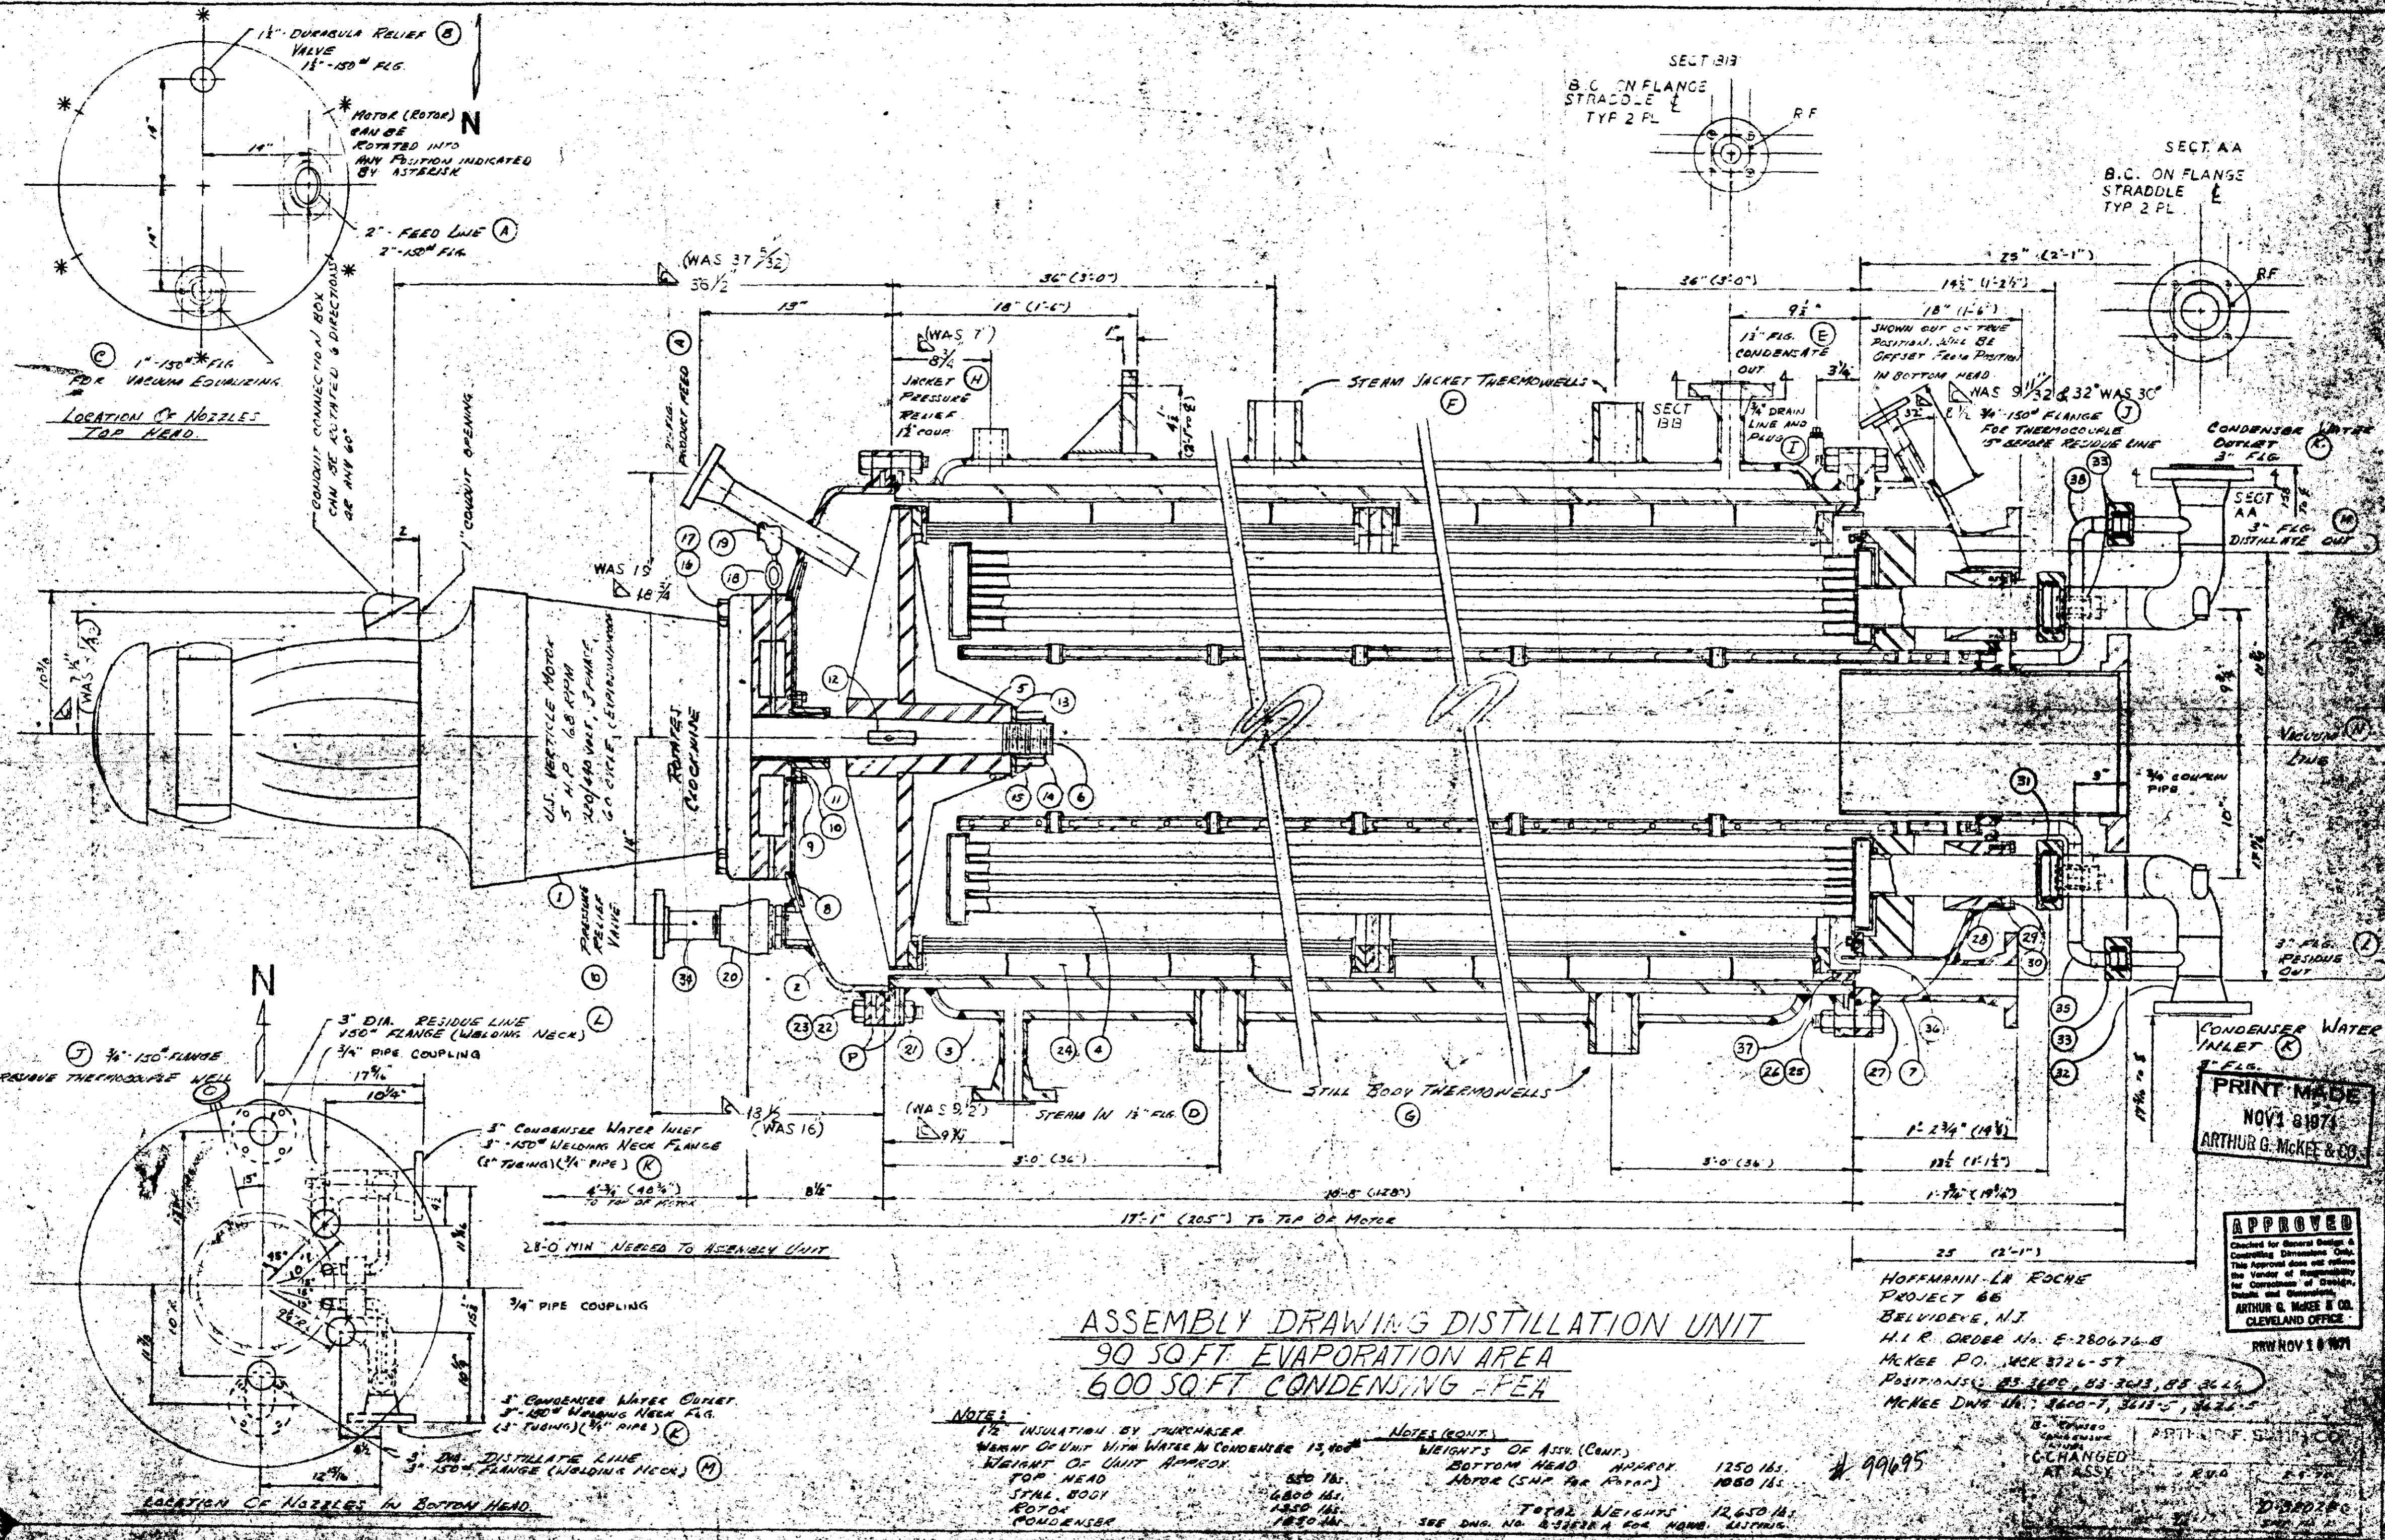

ASSEMBLY DRAWING DISTILLATION UNIT
90 SQ FT EVAPORATION AREA
600 SQ FT CONDENSING AREA

NOTES:
 1/2" INSULATION BY PURCHASER
 WEIGHT OF UNIT WITH WATER IN CONDENSER 15,100#
 WEIGHT OF UNIT READY FOR HEAD
 STILL BODY 650 LB.
 MOTOR 1,600 LB.
 CONDENSER 1,850 LB.
 TOTAL 4,100 LB.

NOTES (CONT.)
 WEIGHTS OF ASSY. (CONT.)
 BOTTOM HEAD APPROX 1250 LB.
 MOTOR (SHP FOR MOTOR) 1000 LB.
 TOTAL WEIGHTS 12,650 LB.
 SEE DNG. NO. 8-3328A FOR NAME LISTING.

HOFFMANN-LE ROCHE
PROJECT 66
BELVIDERE, N.J.
H.I.R. ORDER NO. E-280676-B
MCKEE P.O. MCK 3726-57
POSITIONS: 85 3622, 83 3623, 85 3624
MCKEE DWS. NO.: 8600-7, 3618-5, 3621-5

PRINT MADE
NOV 1 8 1974
ARTHUR G. MCKEE & CO.

APPROVED
 Checked for General Design & Controlling Dimensions Only. This Approval does not constitute a transfer of responsibility for correctness of Design, Details and Quantities.
ARTHUR G. MCKEE & CO.
CLEVELAND OFFICE
REV NOV 1 8 1974


CHANGED AT ASSY

REV	DATE	BY
1	11/8/74	99695

EVP-132
B3-3600

EMP. CODE NO. EV P 152

1	1		SH#2	ROTOR, SS316L
2	1		SH#3	RETAINER WIPER & SEPARATOR ASSY.
3	3		SH#4	RETAINER WIPER & SEPARATOR ASSY.
4	60	611588		WASHER, SPRING LOCK, SS316, 1/2" LIGHT
5	36	1602010		BOLT, HEX. HD, FIN., SS316, 1/2"-13 x 1 1/2" LG.
6	60	601819		NUT, HEX, SS316, 1/2"-13
7	1		SH#5	RING, MTG., WEAR BLOCK
8	12	1602126		BOLT, HEX. HD, FIN., SS316, 1/2"-13 x 1" LG.
9	8		SH#6	BLADE, WIPER, RULON P, 9 1/2" LG.
10	48	321408	321408	BLADE, WIPER, RULON P, 8 1/4" LG.

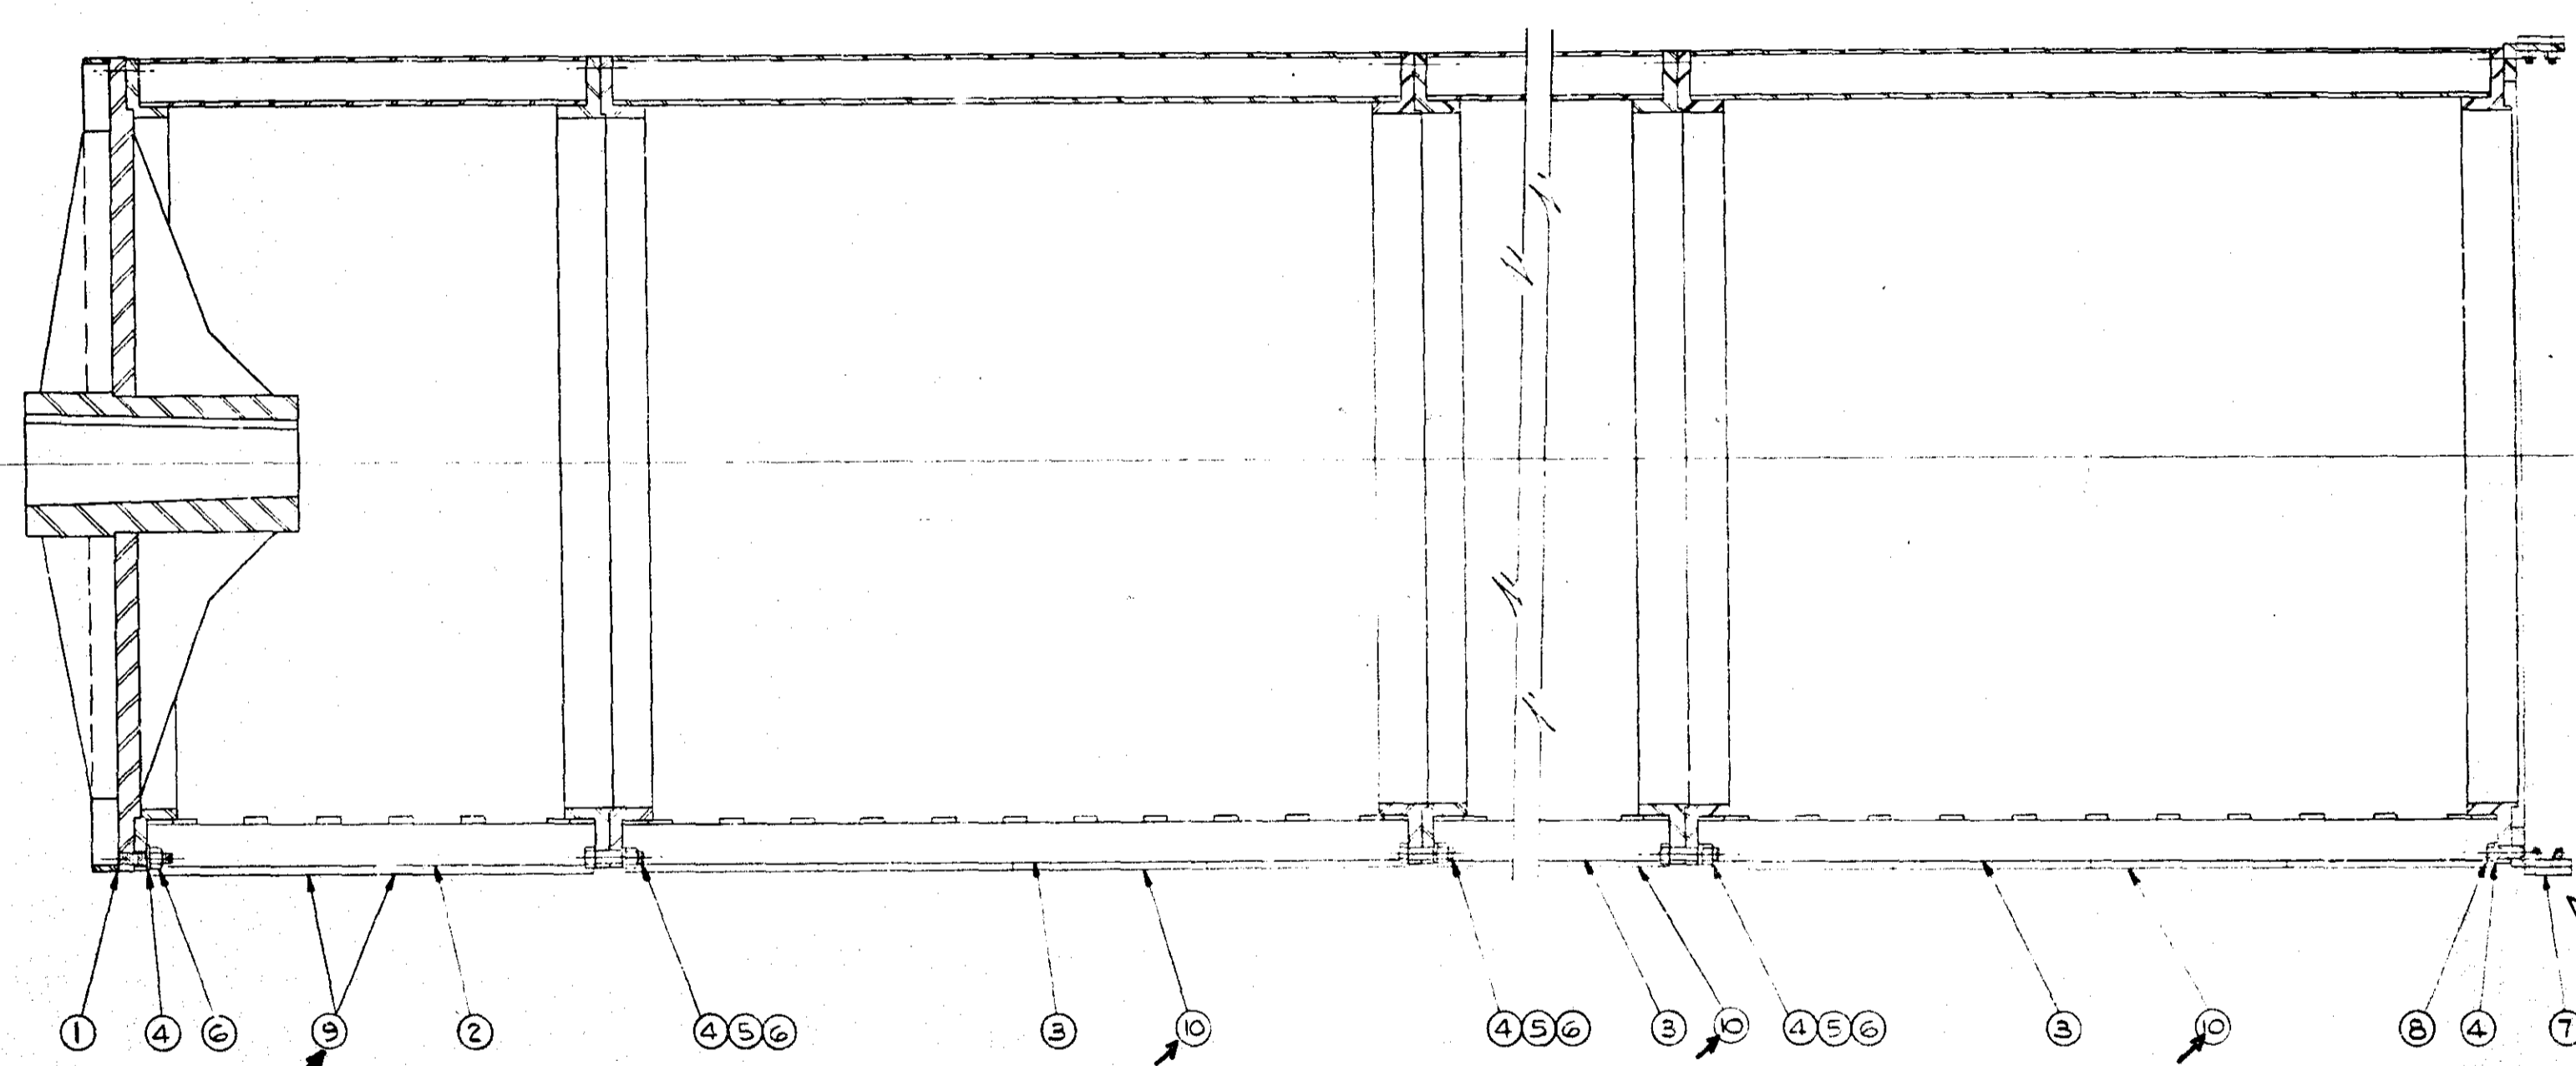

Run out 1/8" max Lecan.
a. J. J. T.
5-5-83

CUSTOMER: HOFFMANN-LA ROCHE INC.
ADDRESS: NUTLEY, N.J.
CONSIGNEE: HOFFMANN-LA ROCHE INC.
ADDRESS: BELVIDERE, N.J.
CUSTOMER ORDER NO.: E664483 B

TAG: B3-3600 CODE: EVP-152

ROTOR ASSY., S.S. 316L
FOR 90 SQ. FT. EVAPORATOR

REVISION	DATE	BY	DESCRIPTION

PFAUDLER
DIVISION OF SYBRON CORPORATION
ROCHESTER, N.Y. & ELYRIA, OHIO, U.S.A.

SYBRON Powder

SCALE: 3"=1'-0"

DATE: 11-2-78

CHECKED: MZ

DATE: 11-2-78

R578-0408

B3-3600
EVP-152

ISSUED NOV 16 1978
THE PFAUDLER CO.
A DIVISION OF SYBRON CORPORATION
ROCHESTER, N. Y.

EMP. CODE NO. EV P 152

#99695