


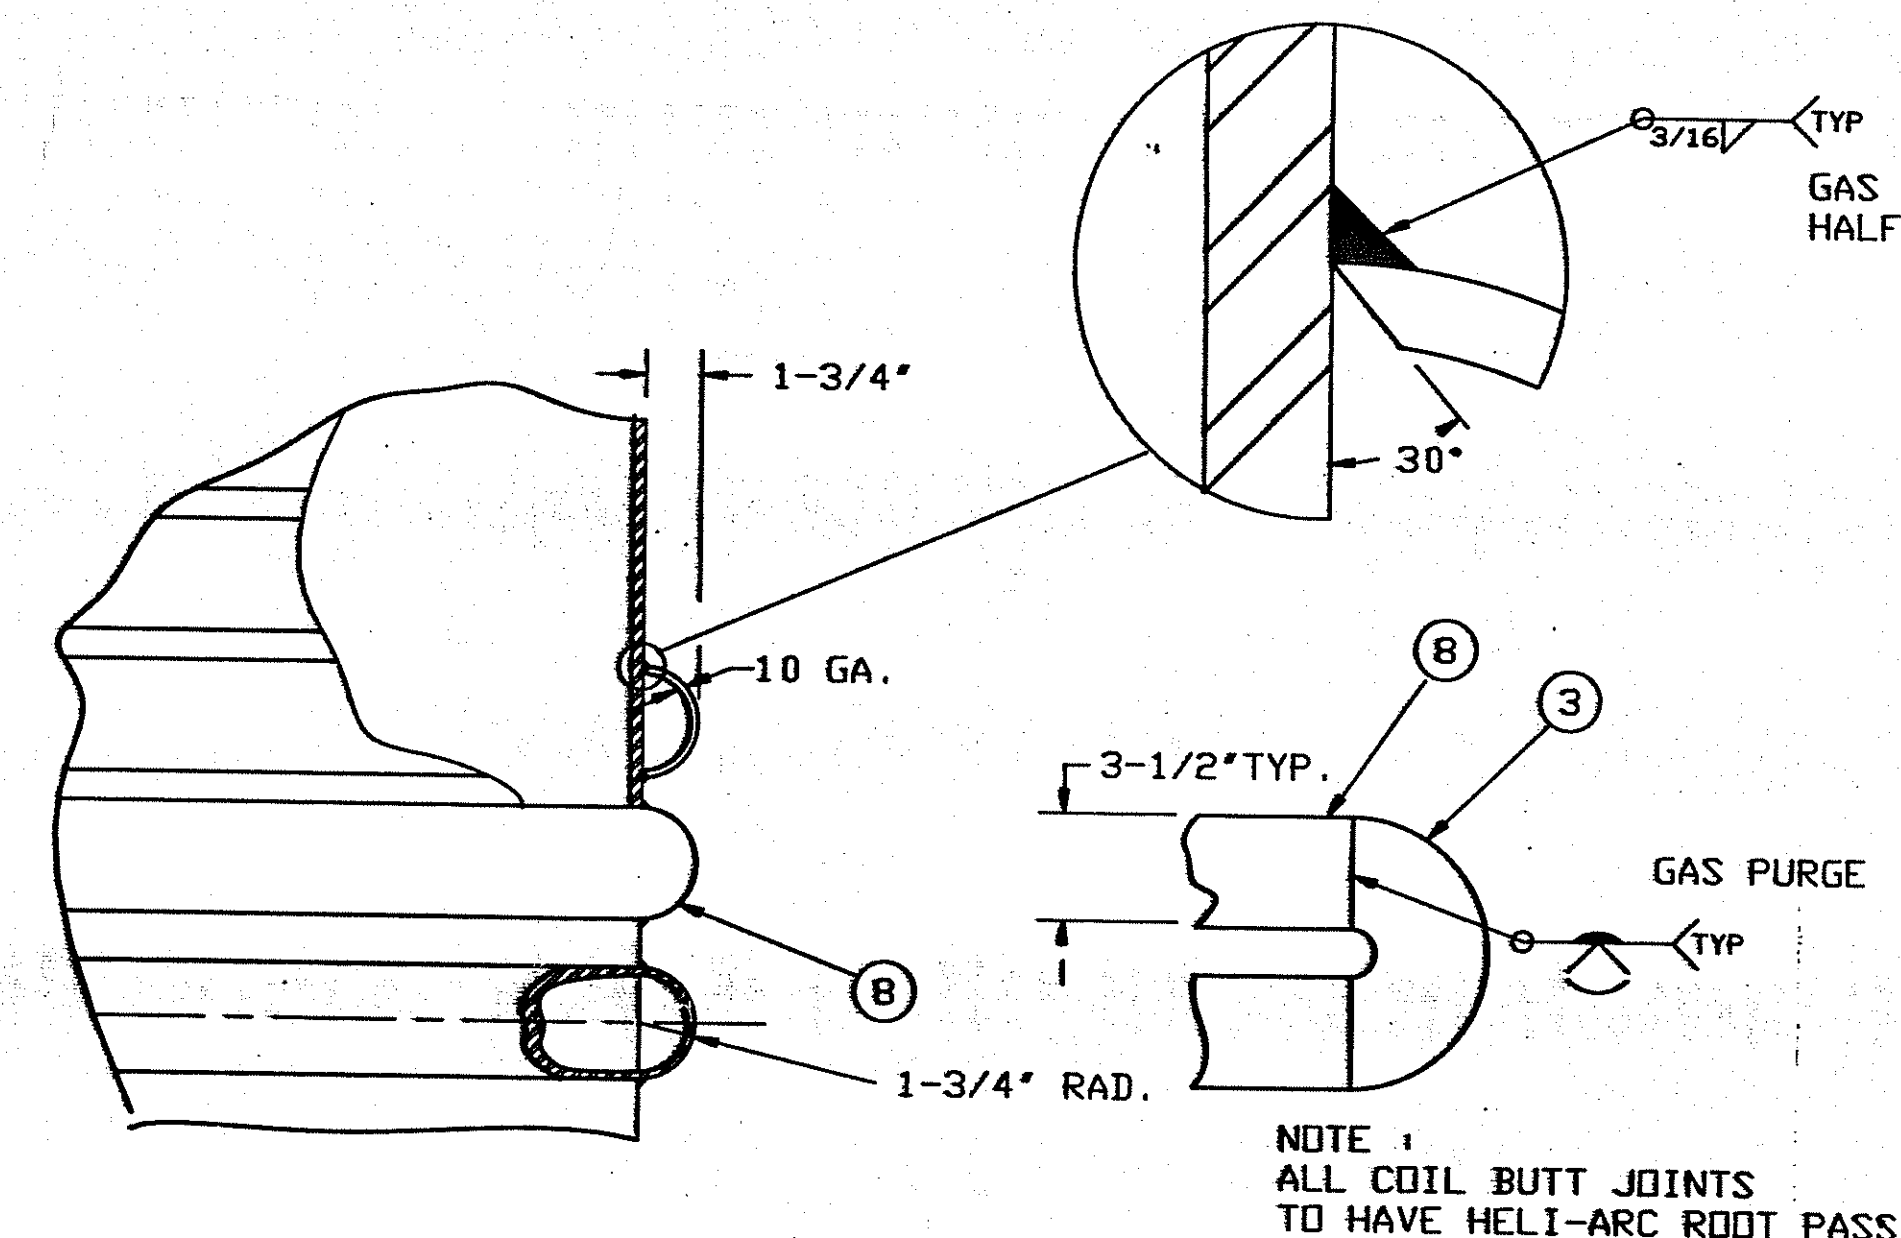


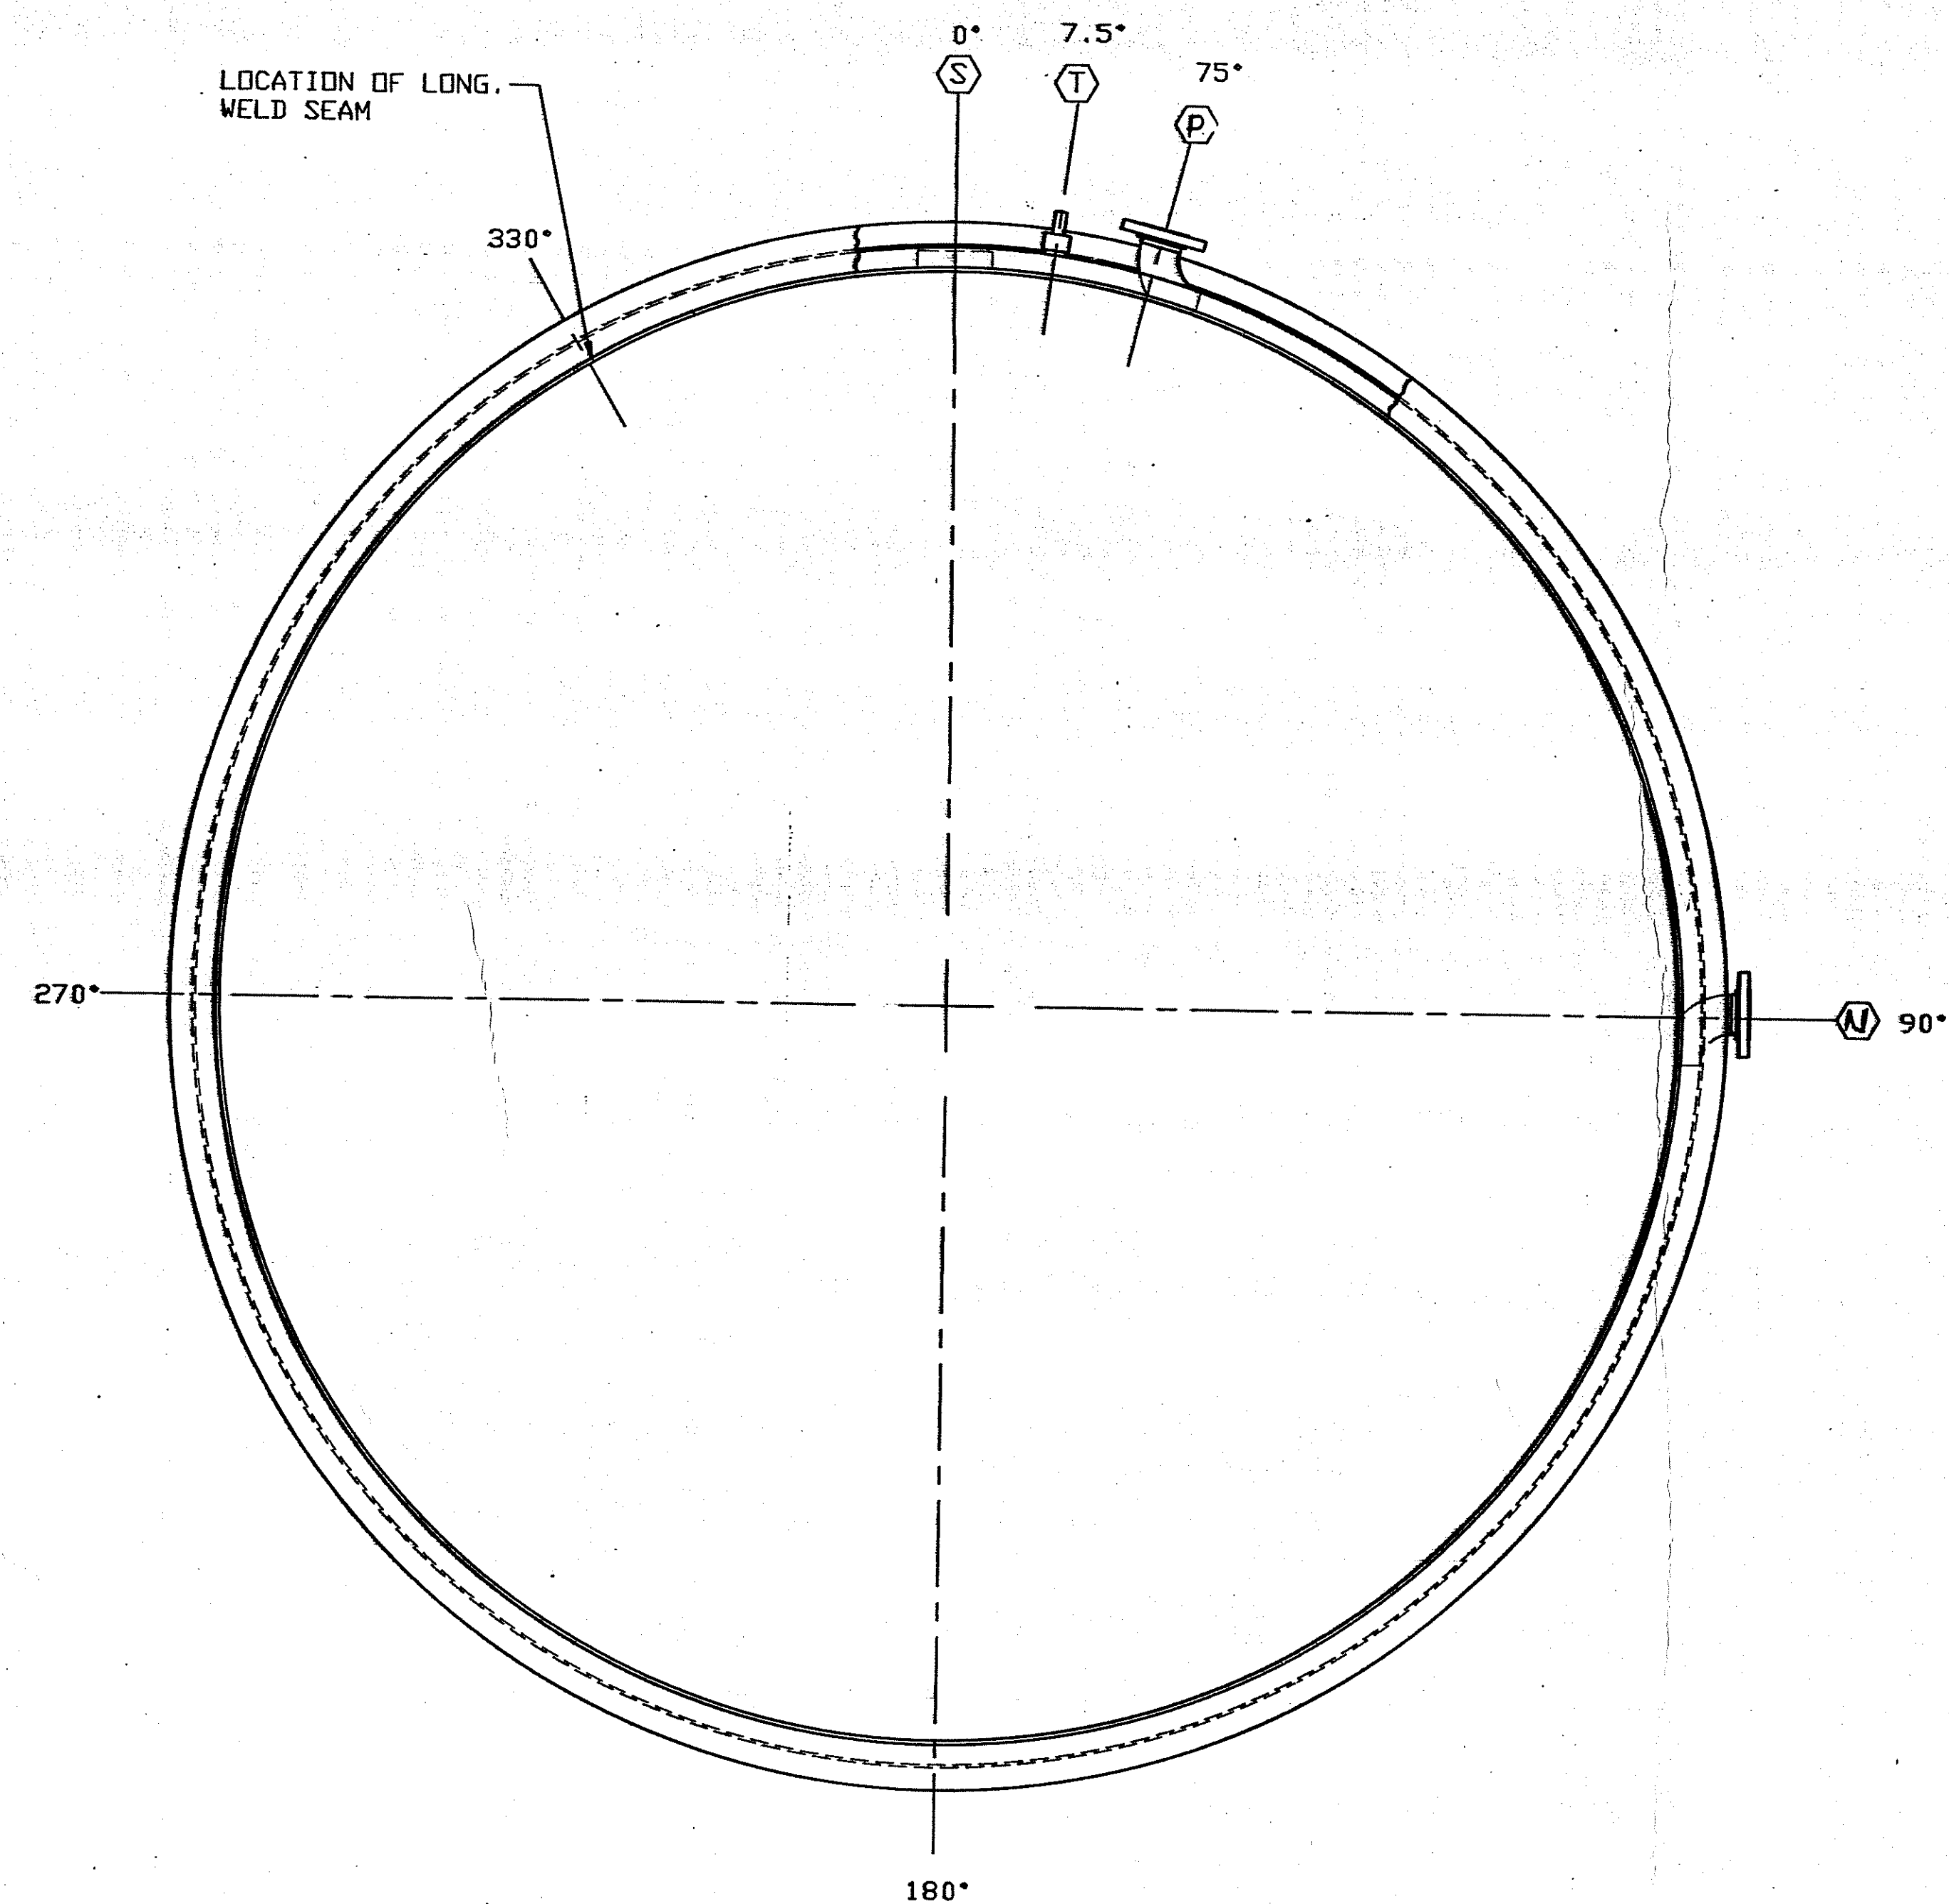


PIPE COIL DETAILS
SCALE: 2"=1'

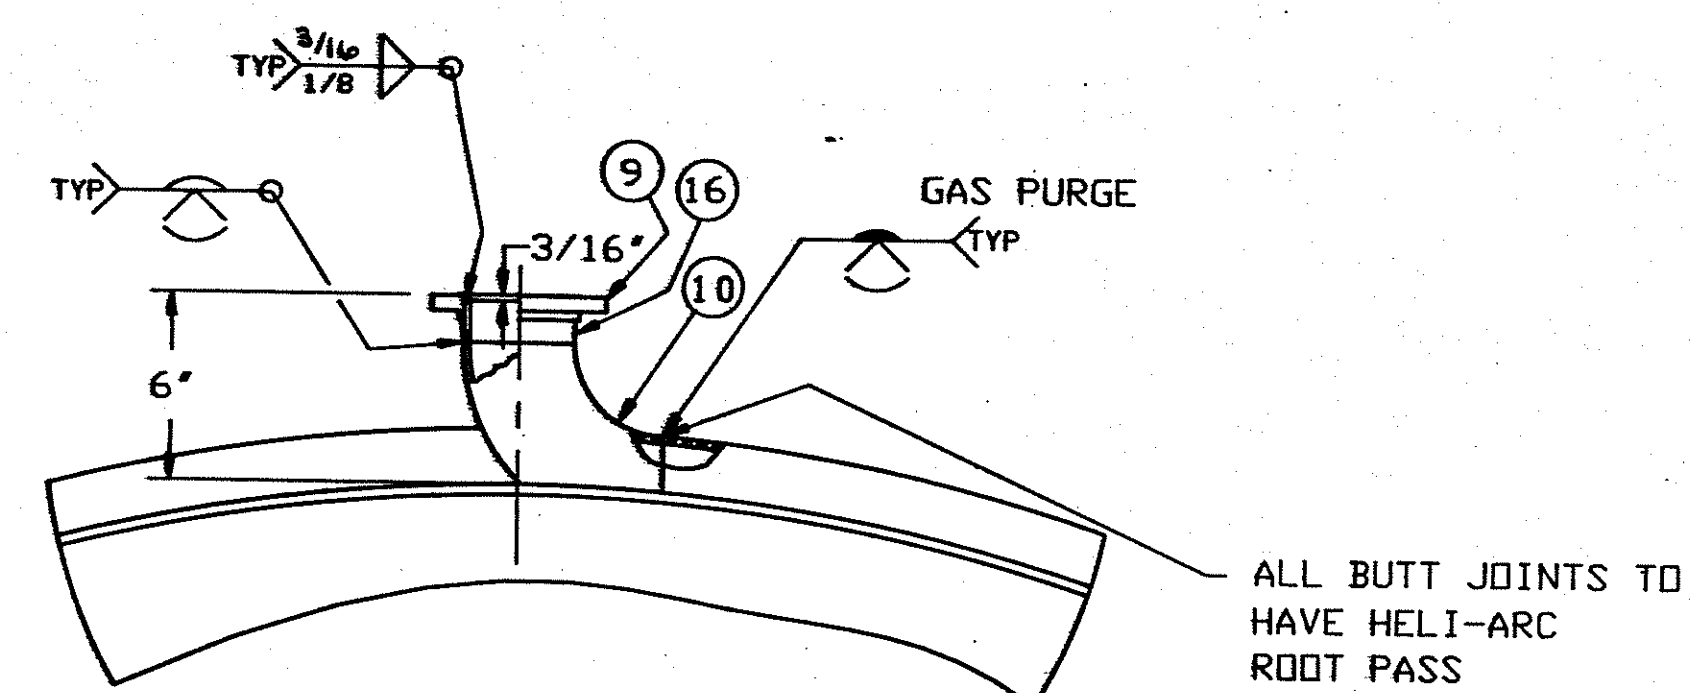

DETAIL NOZZ (N) (P)
SCALE: NONE

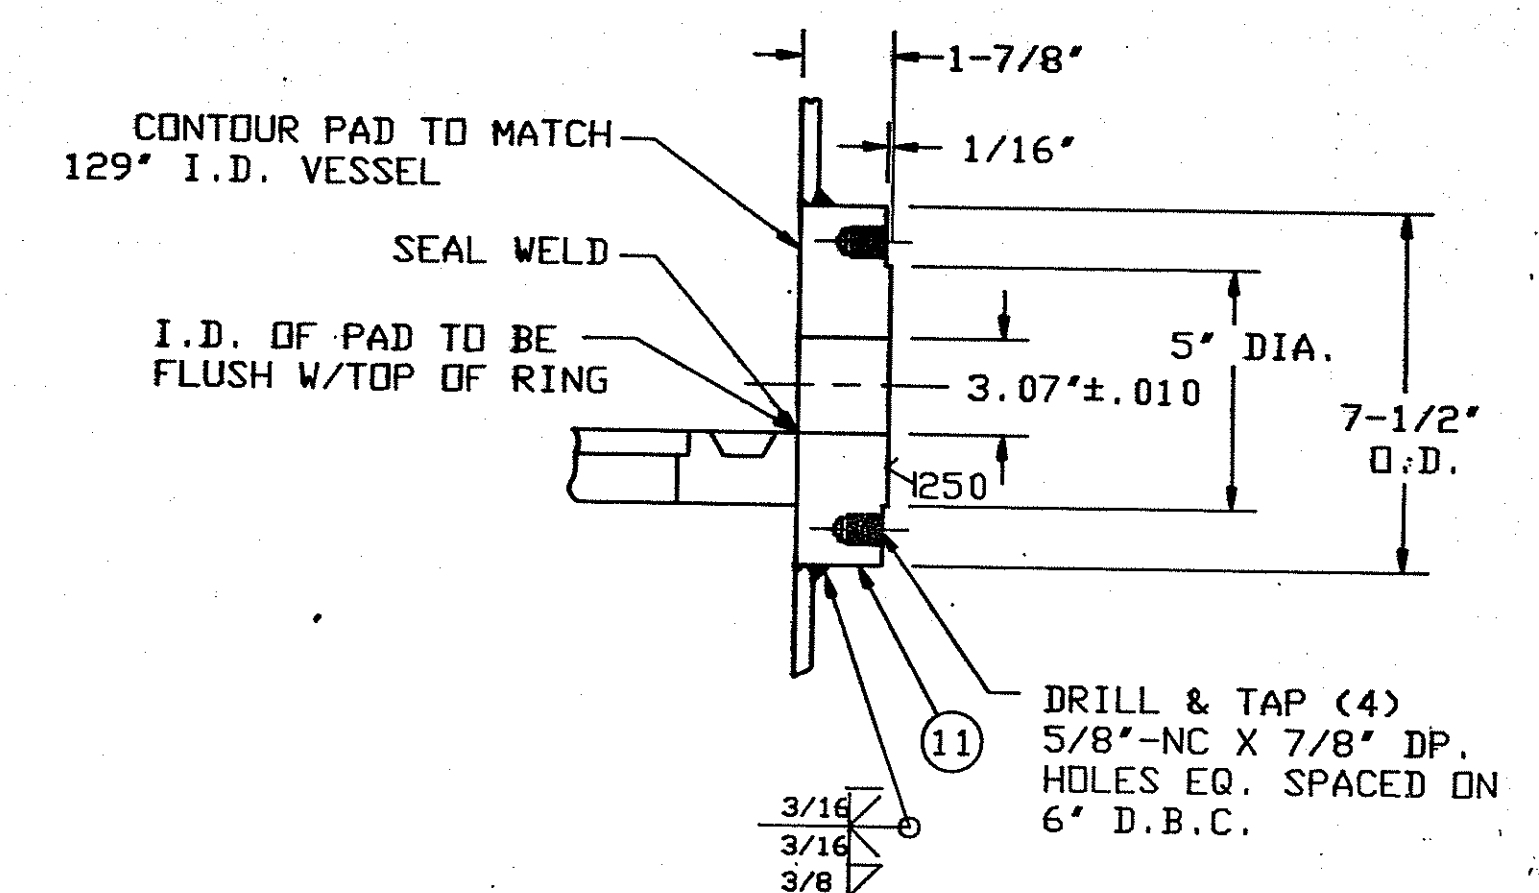


NOZZ (S) DETAIL
SCALE: NONE

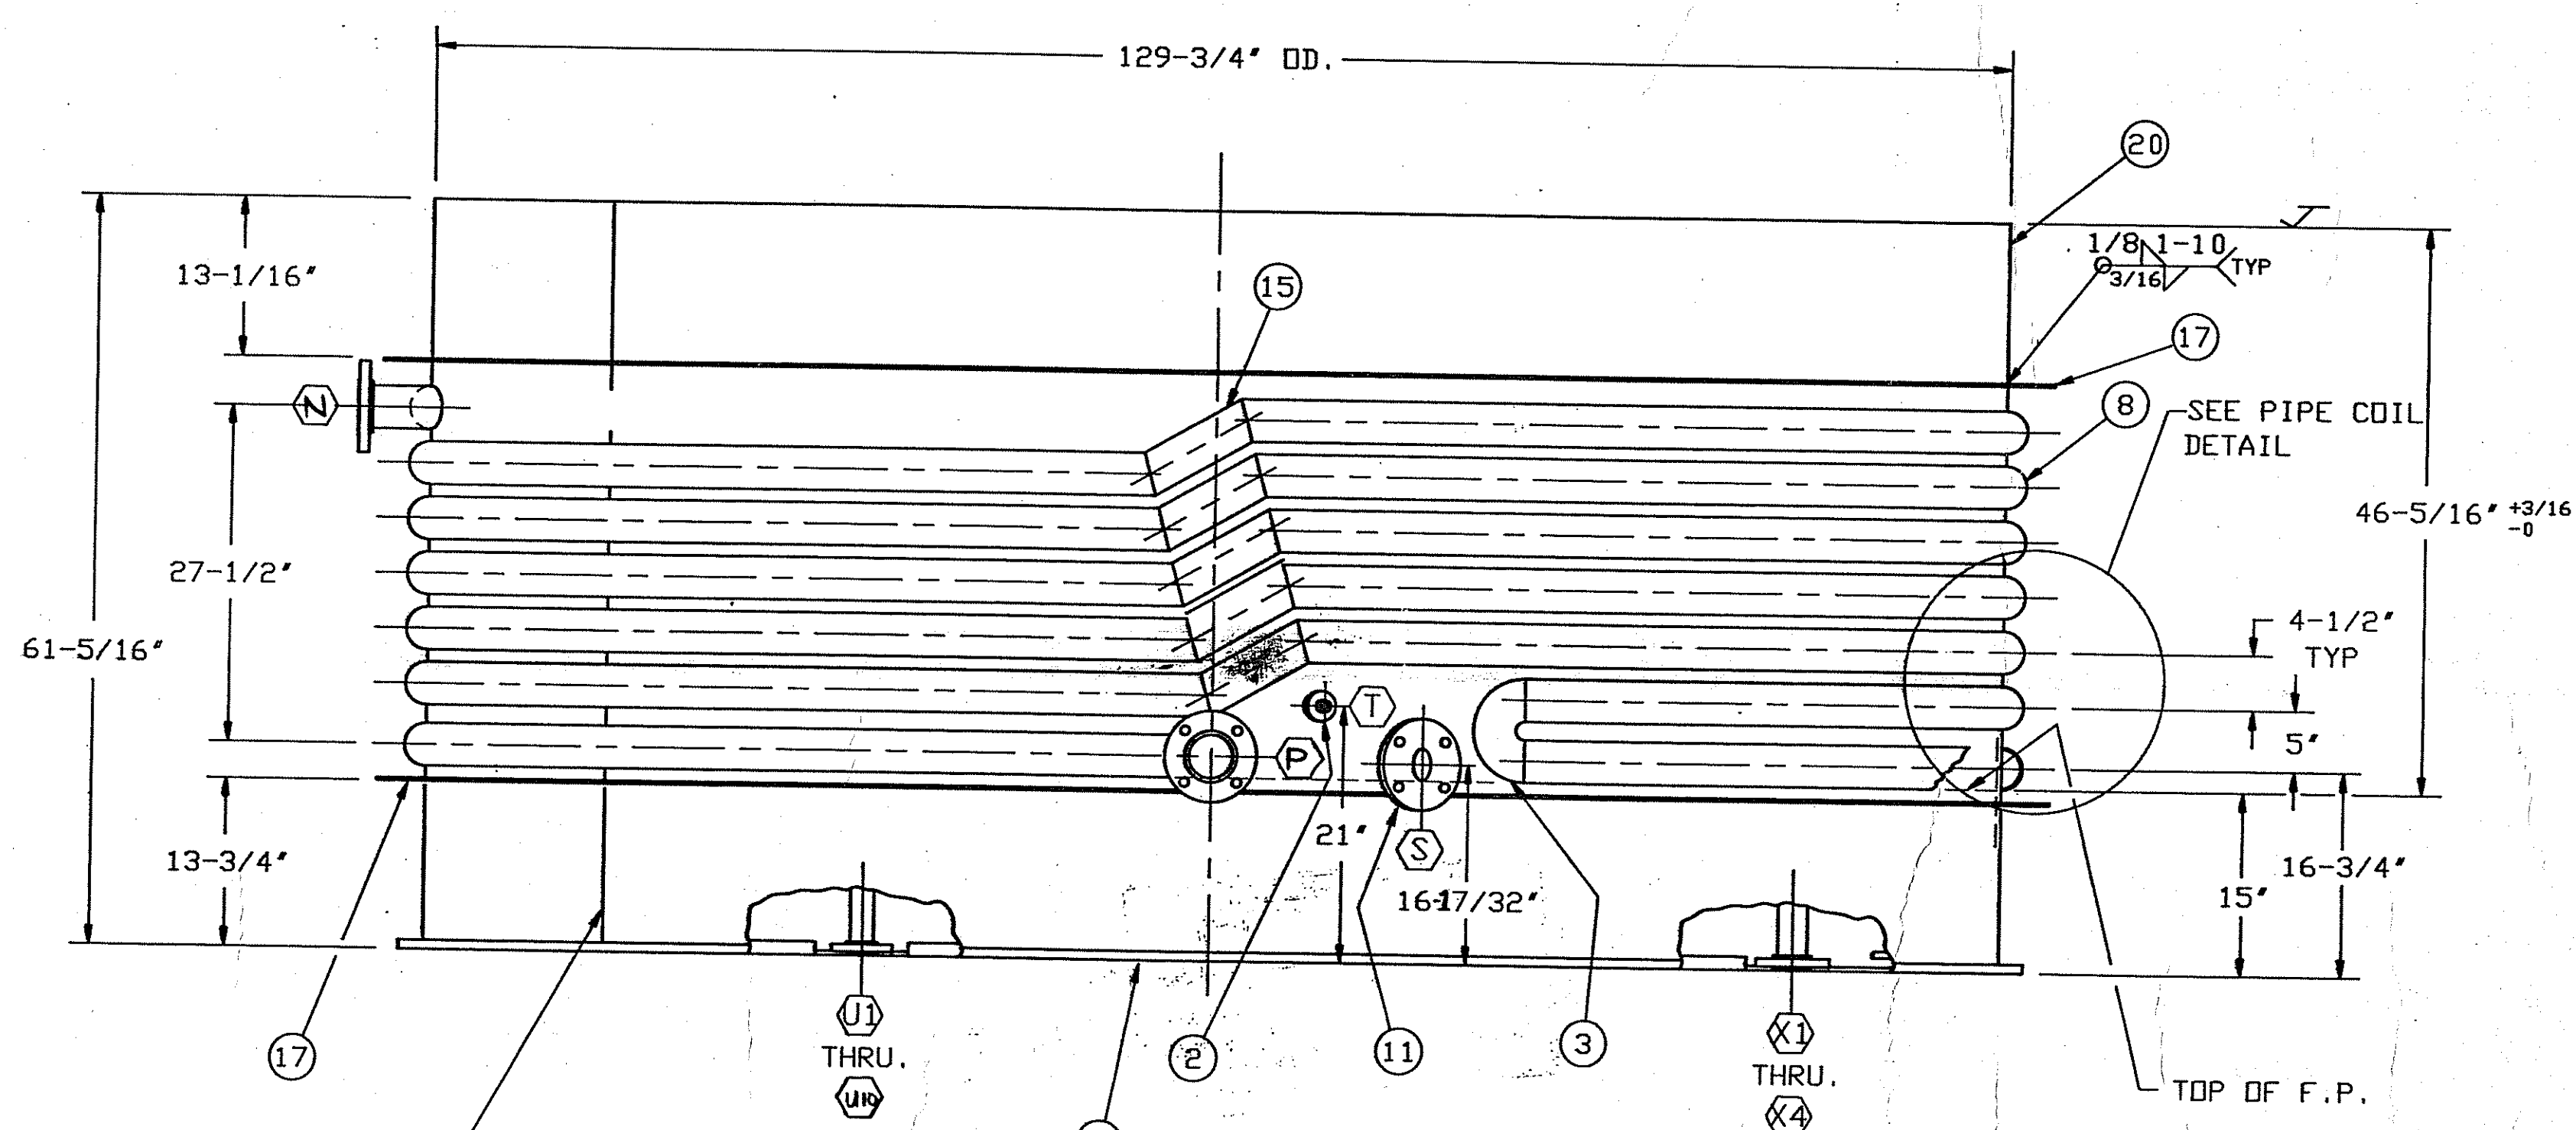

ELEVATION VIEW

NOTE: SEE NOTE #1 DWG. E-3600589

NOTE: GRIND THIS WELD FLUSH UNDER JKT.

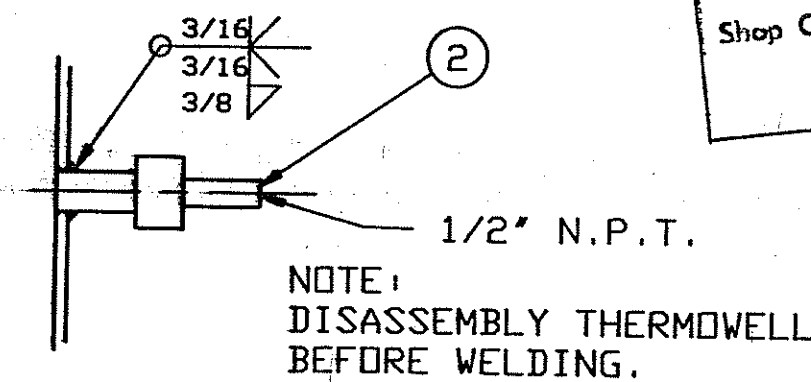

THERMOWELL WELD DETAIL
SCALE: NONE

Paul J. Cahill
REVIEWED
MAY 2 1991

CERTIFIED PRINT
Customer Order No. 90-00001
Shop Order No. 90-PF-111
ROSENBLUM
Charlotte, N.C. 42691

*** .017 (4) PIECE CONSTRUCTION
*** .008 129-7/8" I.D. W/30° BEVEL ON I.D. BOTH SIDES

ITEM NO.	PART NO.	DRAWING NO.	MATERIAL OR DESCRIPTION	MATERIAL SPEC.	MAT'L TYPE	QTY/PER UN.
020	9120026		PLATE, 3/8 X 60-15/16 X 406-7/16 LG.	SA-240	T-304	1.9500 EA
019			SHELL ASSEMBLY 8m2 P/N 9126241			
018						
017	9127078		RING, 137-3/4 OD +1/8-0 X 129-7/8 ID +0-1/8 X 1/4"	SA-240	304	2 EA
016	5215000		PIPE, 3 SCH 10S X 2-11/16" LG.	SA-312 304 /304L		.443 FT
015	5215000		PIPE, 3 SCH 10S X 9-15/16" LG.	SA-312 304 /304L		4.162 FT
014			RINGS & PREP PARTS P/N 9126240			
013						
012						
011	9127080		RING, 7-1/2 OD +1/16-0 X 2-5/8 ID +0-1/16 X 2	SA-240	304	1 EA
010	0101384		PIPE ELB, WELD 3 SCH 10 ANSI	SA-403	T304L	2 EA
009	0100508		FLANGE, RFSD 3 PS 150 LB ANSI	SA182B16.5	F304	2 EA
008	9125202		HALF PIPE, 3-1/2 OD X 10 GA (.134) X 7 TURNS	SA-240	T304	1 EA
007						
006						
004			SHELL ASSEMBLY 8m2 P/N 9126241			
003			RINGS & PREP PARTS P/N 9126240			
002	3616003		HALF PIPE, RETURN 180 DEG	SA-240	316L	1 EA
001	3600511		THERMOWELL ASSY			1 EA
ITEM	3600592		BASE ASSY, 8m2		B/M	1 EA
NO						

REV.	DESCRIPTION	DATE	BY	CHECKED	APPROVED
G					
F					
E					
D					
C					
B					
A	INTERCHANGE LETTERS N4P	4-18-91			

GASTON COUNTY FABRICATION
A DIVISION OF GASTON COUNTY DYING MACHINE COMPANY
STANLEY, NORTH CAROLINA 28154-7665

CUSTOMER ROSENBLUM INC. FOR SOFIX CORP.
CHARLOTTE, N.C.

TITLE BASE & SHELL ASSEMBLY 8m2

CUSTOMER P.O. NO. 1747 CUSTOMER ITEM NO. 5100

DRAWN BY G.M. DATE 1/27/91 CHECKED BY DATE 1-28-91




SHOP ORDER NO. F-80816 NO. REQUIRED 1 SHEET 11 REV. 1

CAD REFERENCE NO.
RD00151A


ASME CODE
REVIEWED DATE 3/5/91
APPROVED DATE

NO.	QTY.	SIZE	RATING	TYPE	SCH.	SERVICE/DESCRIPTION
X1-X4	4	2"	150#	RFSD	40	BASE HEAT IN & OUT
U1-U10	10	1-1/2"	150#	RFSD	40	FILTRATE OUTLETS
T	1	1/2"	PAD	BAR		THERMOWELL
S	1	3"	150#	RFSD	40	SLURRY OUTLET
P	1	3"	150#	RFSD	40	JACKET OUTLET
N	1	3"	150#	RFSD	40	JACKET INLET






NOZZLE SCHEDULE

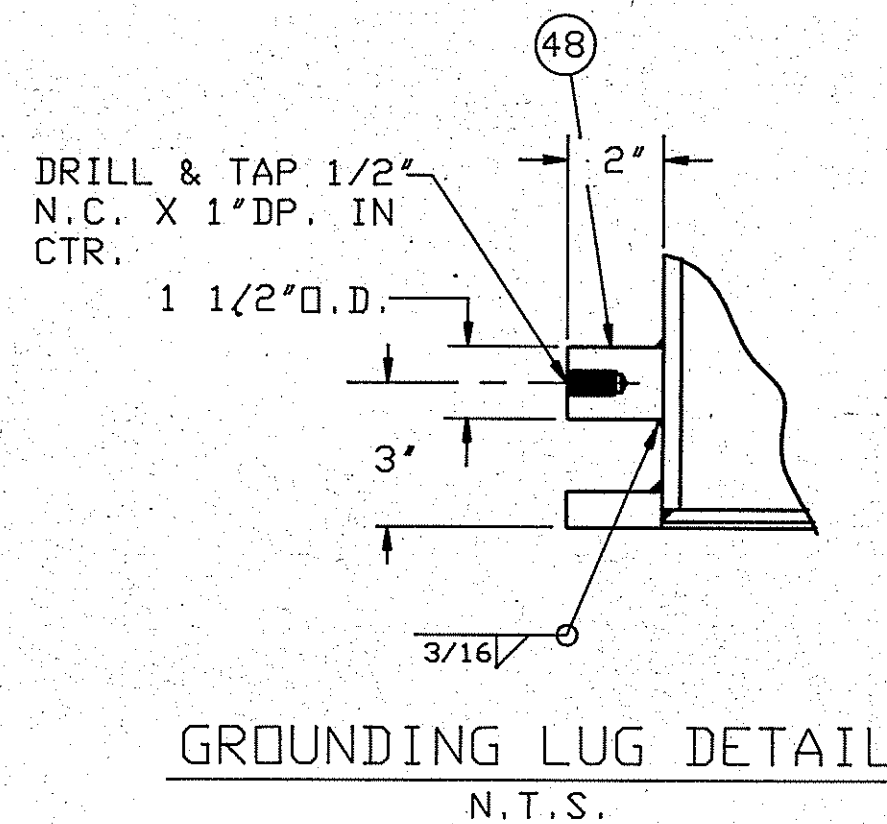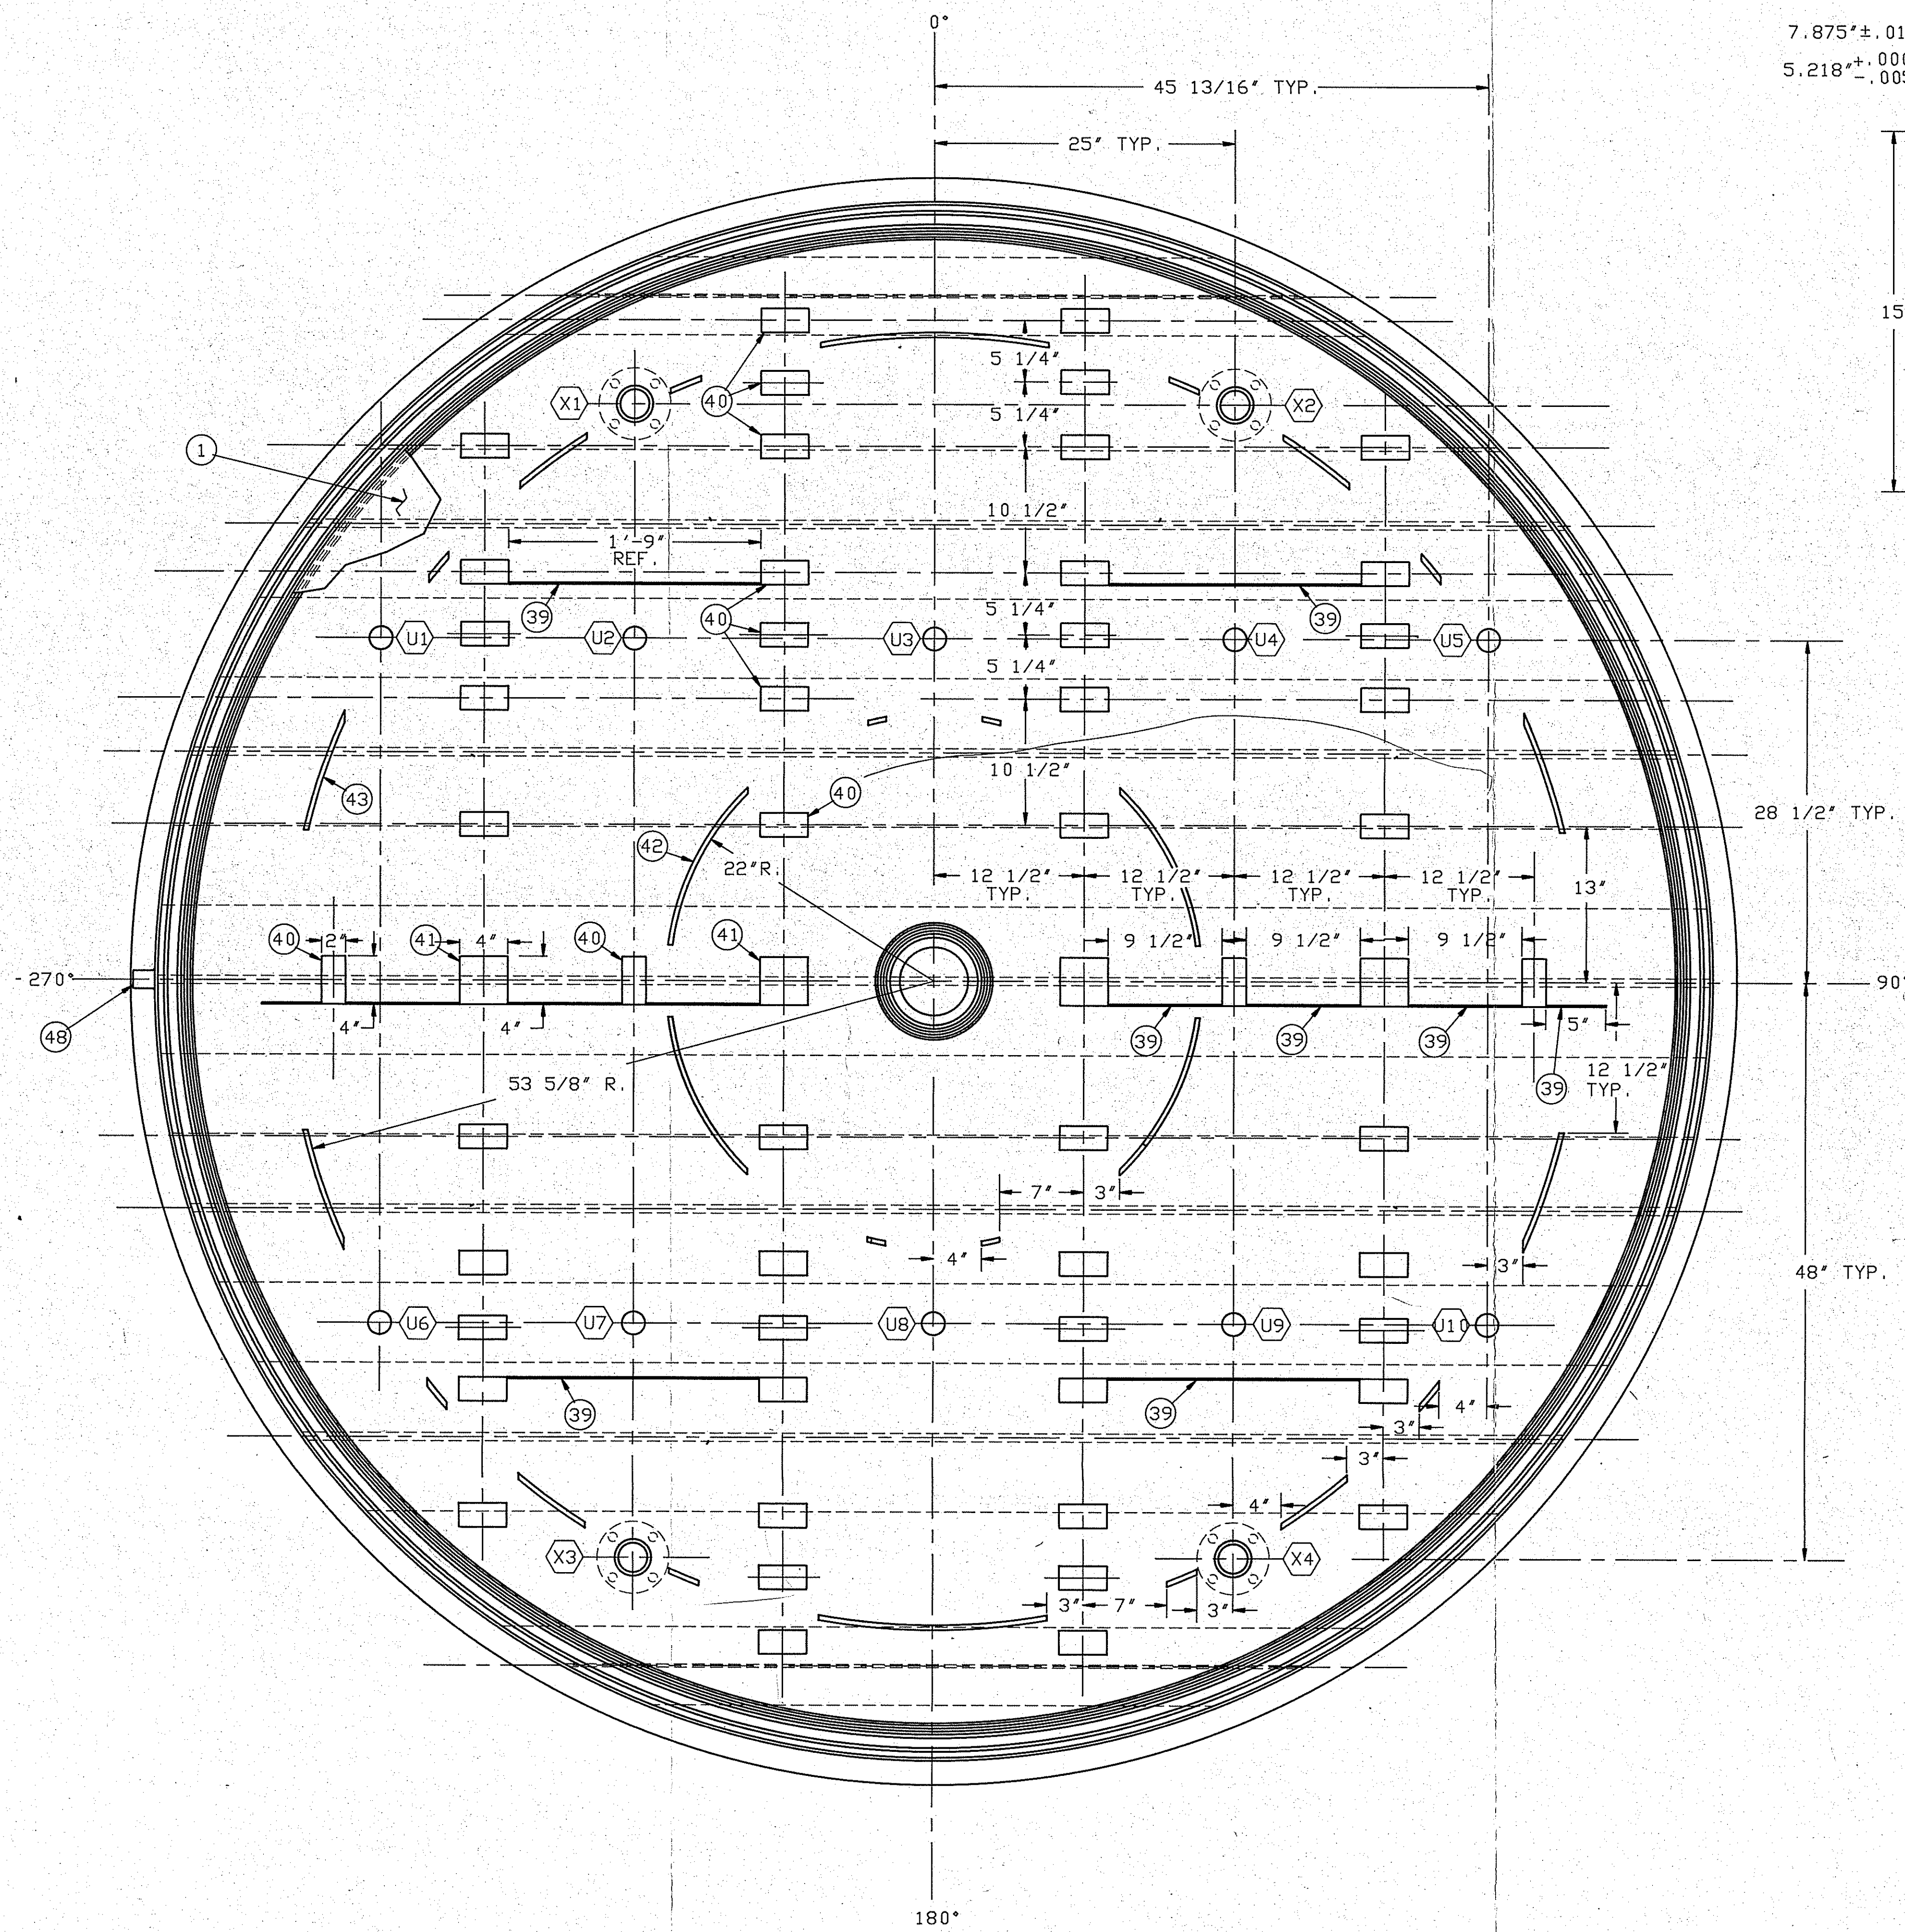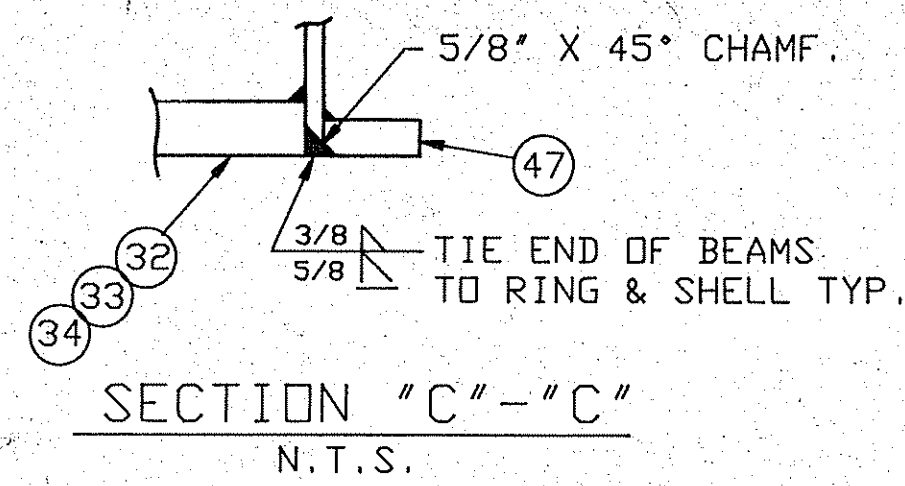

ASME CODE		
CODE SPEC	DATE	
REV	DATE	APP.

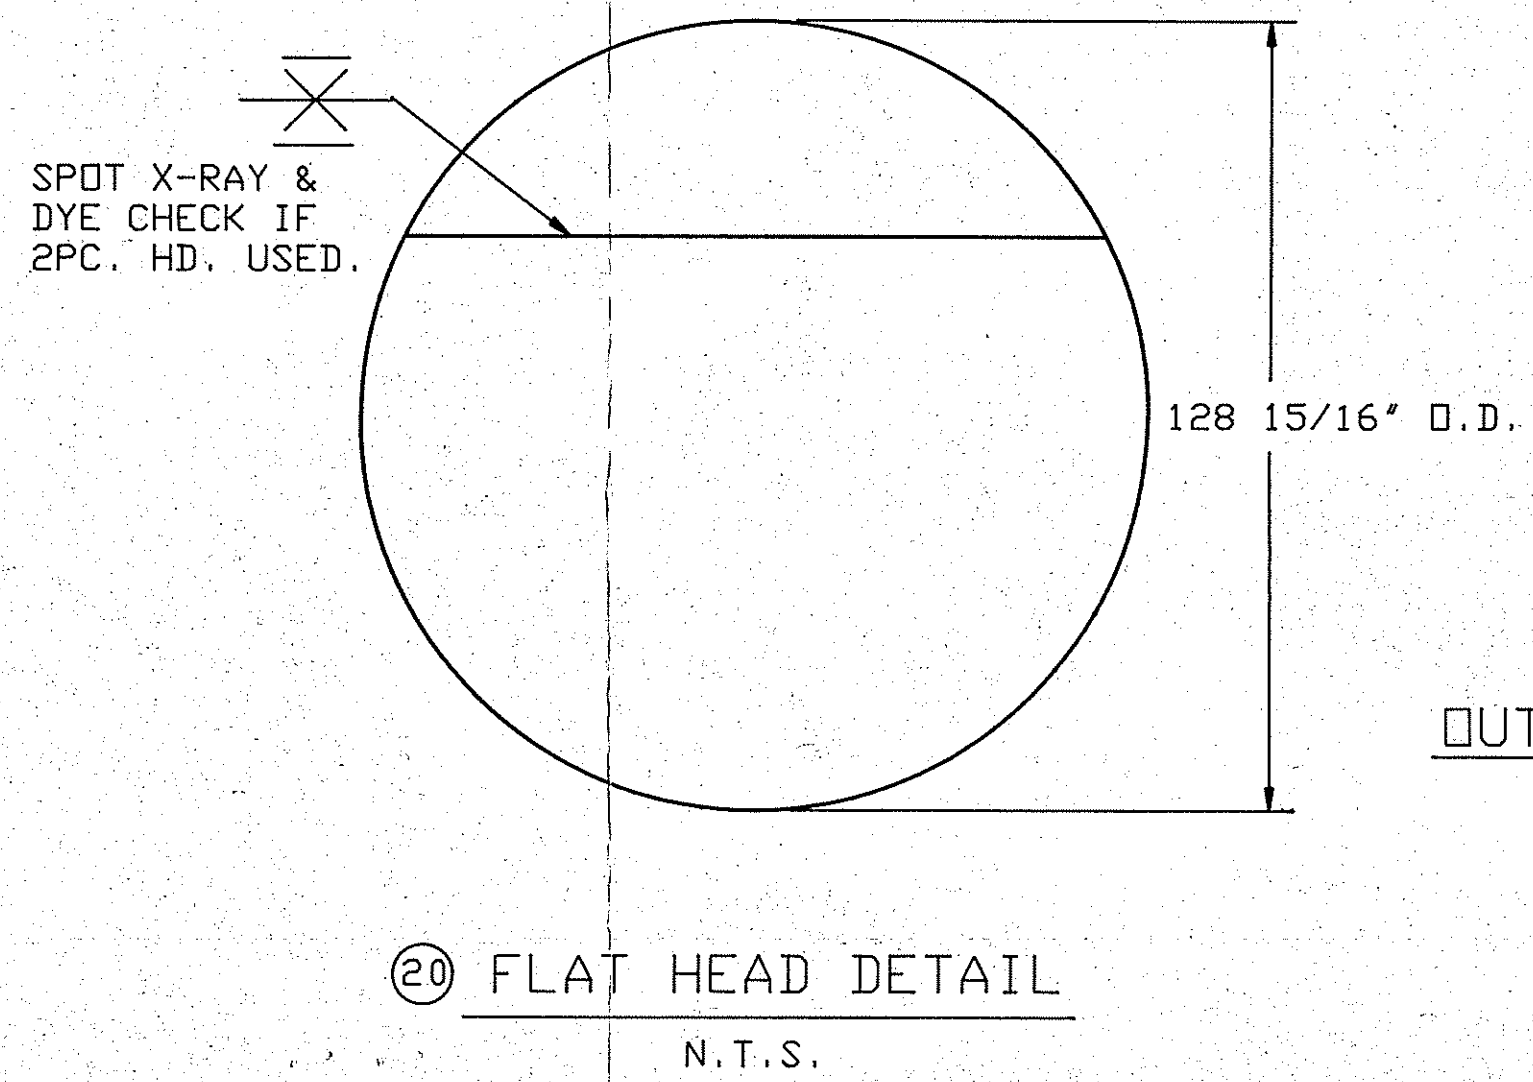

REFERENCE NO.
0147A

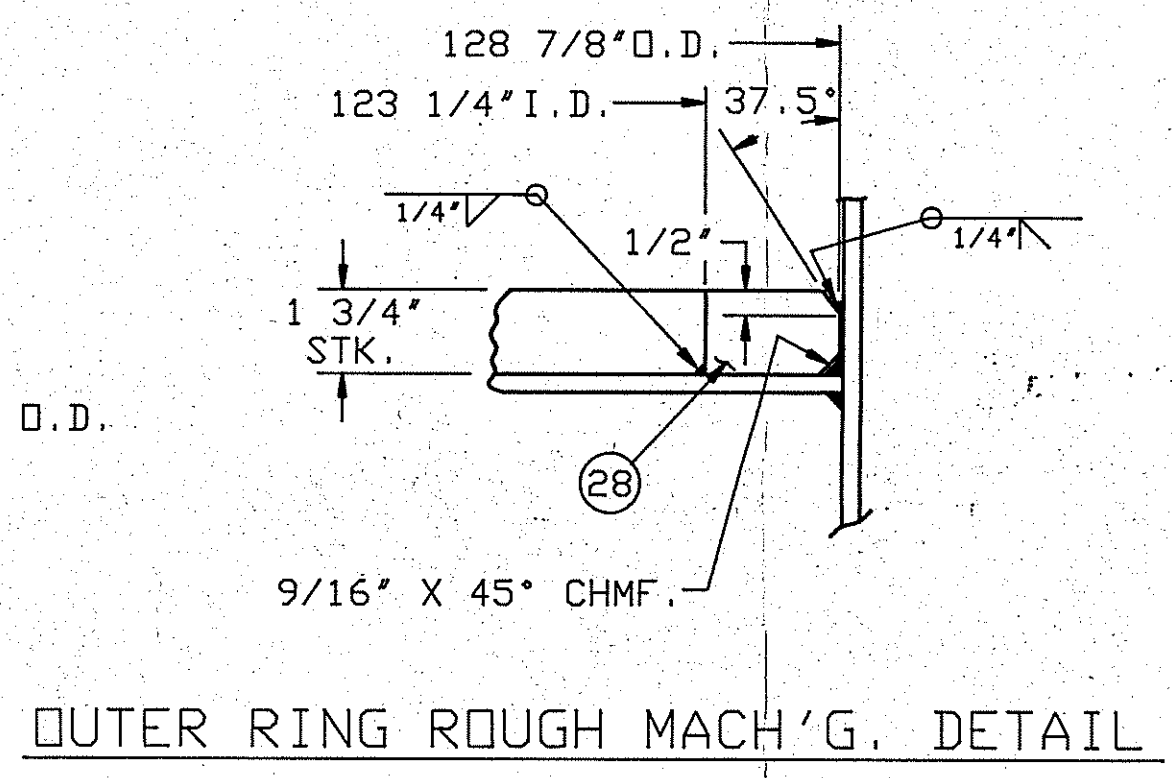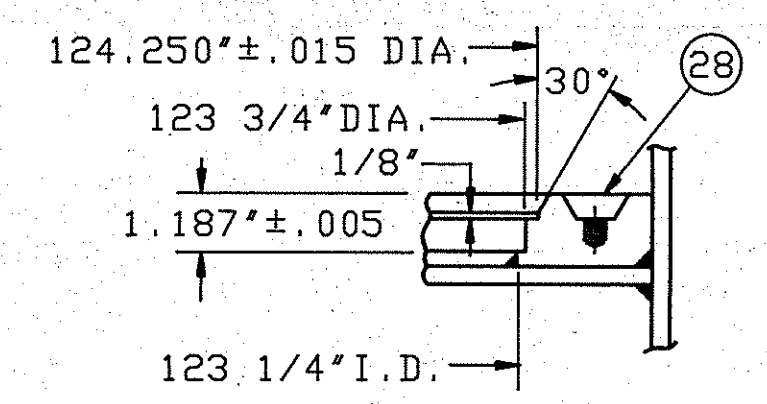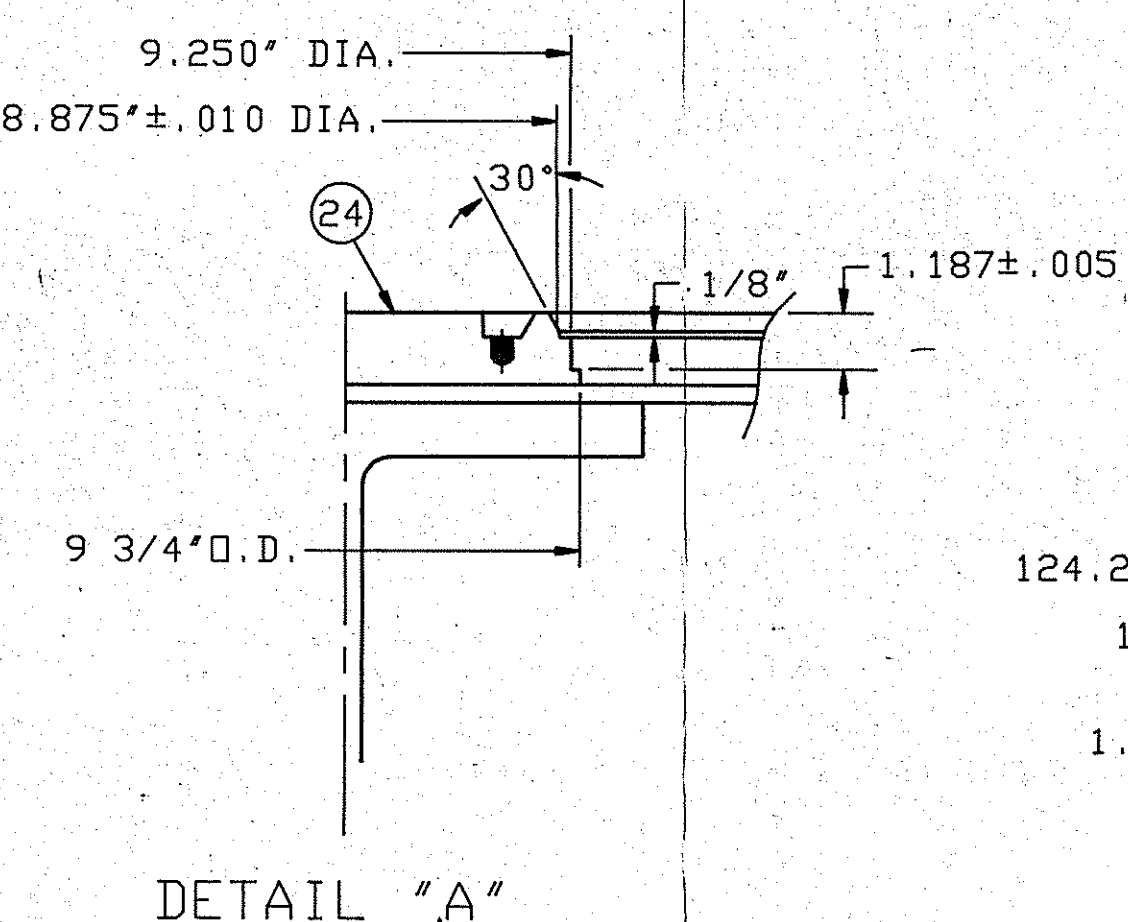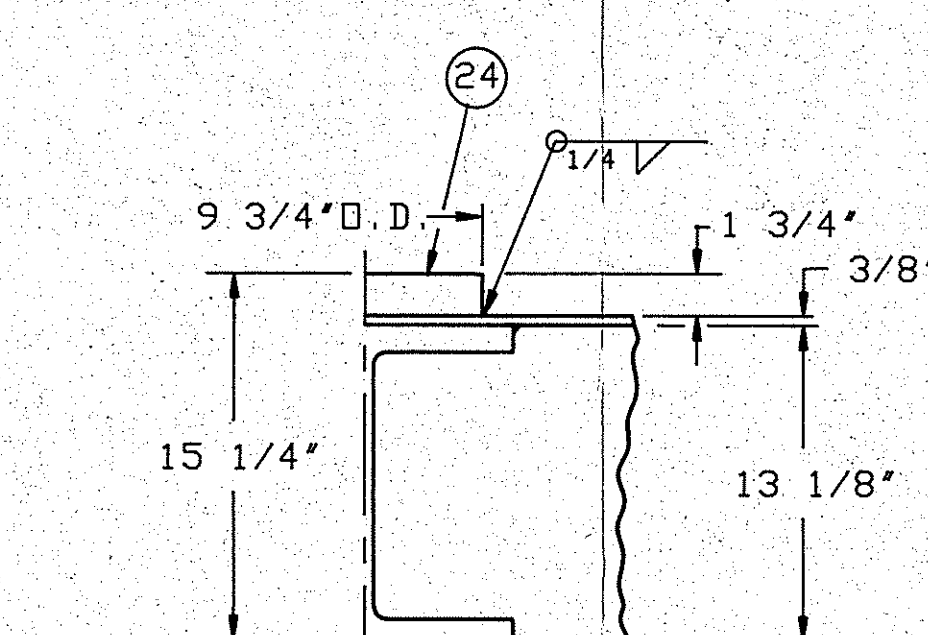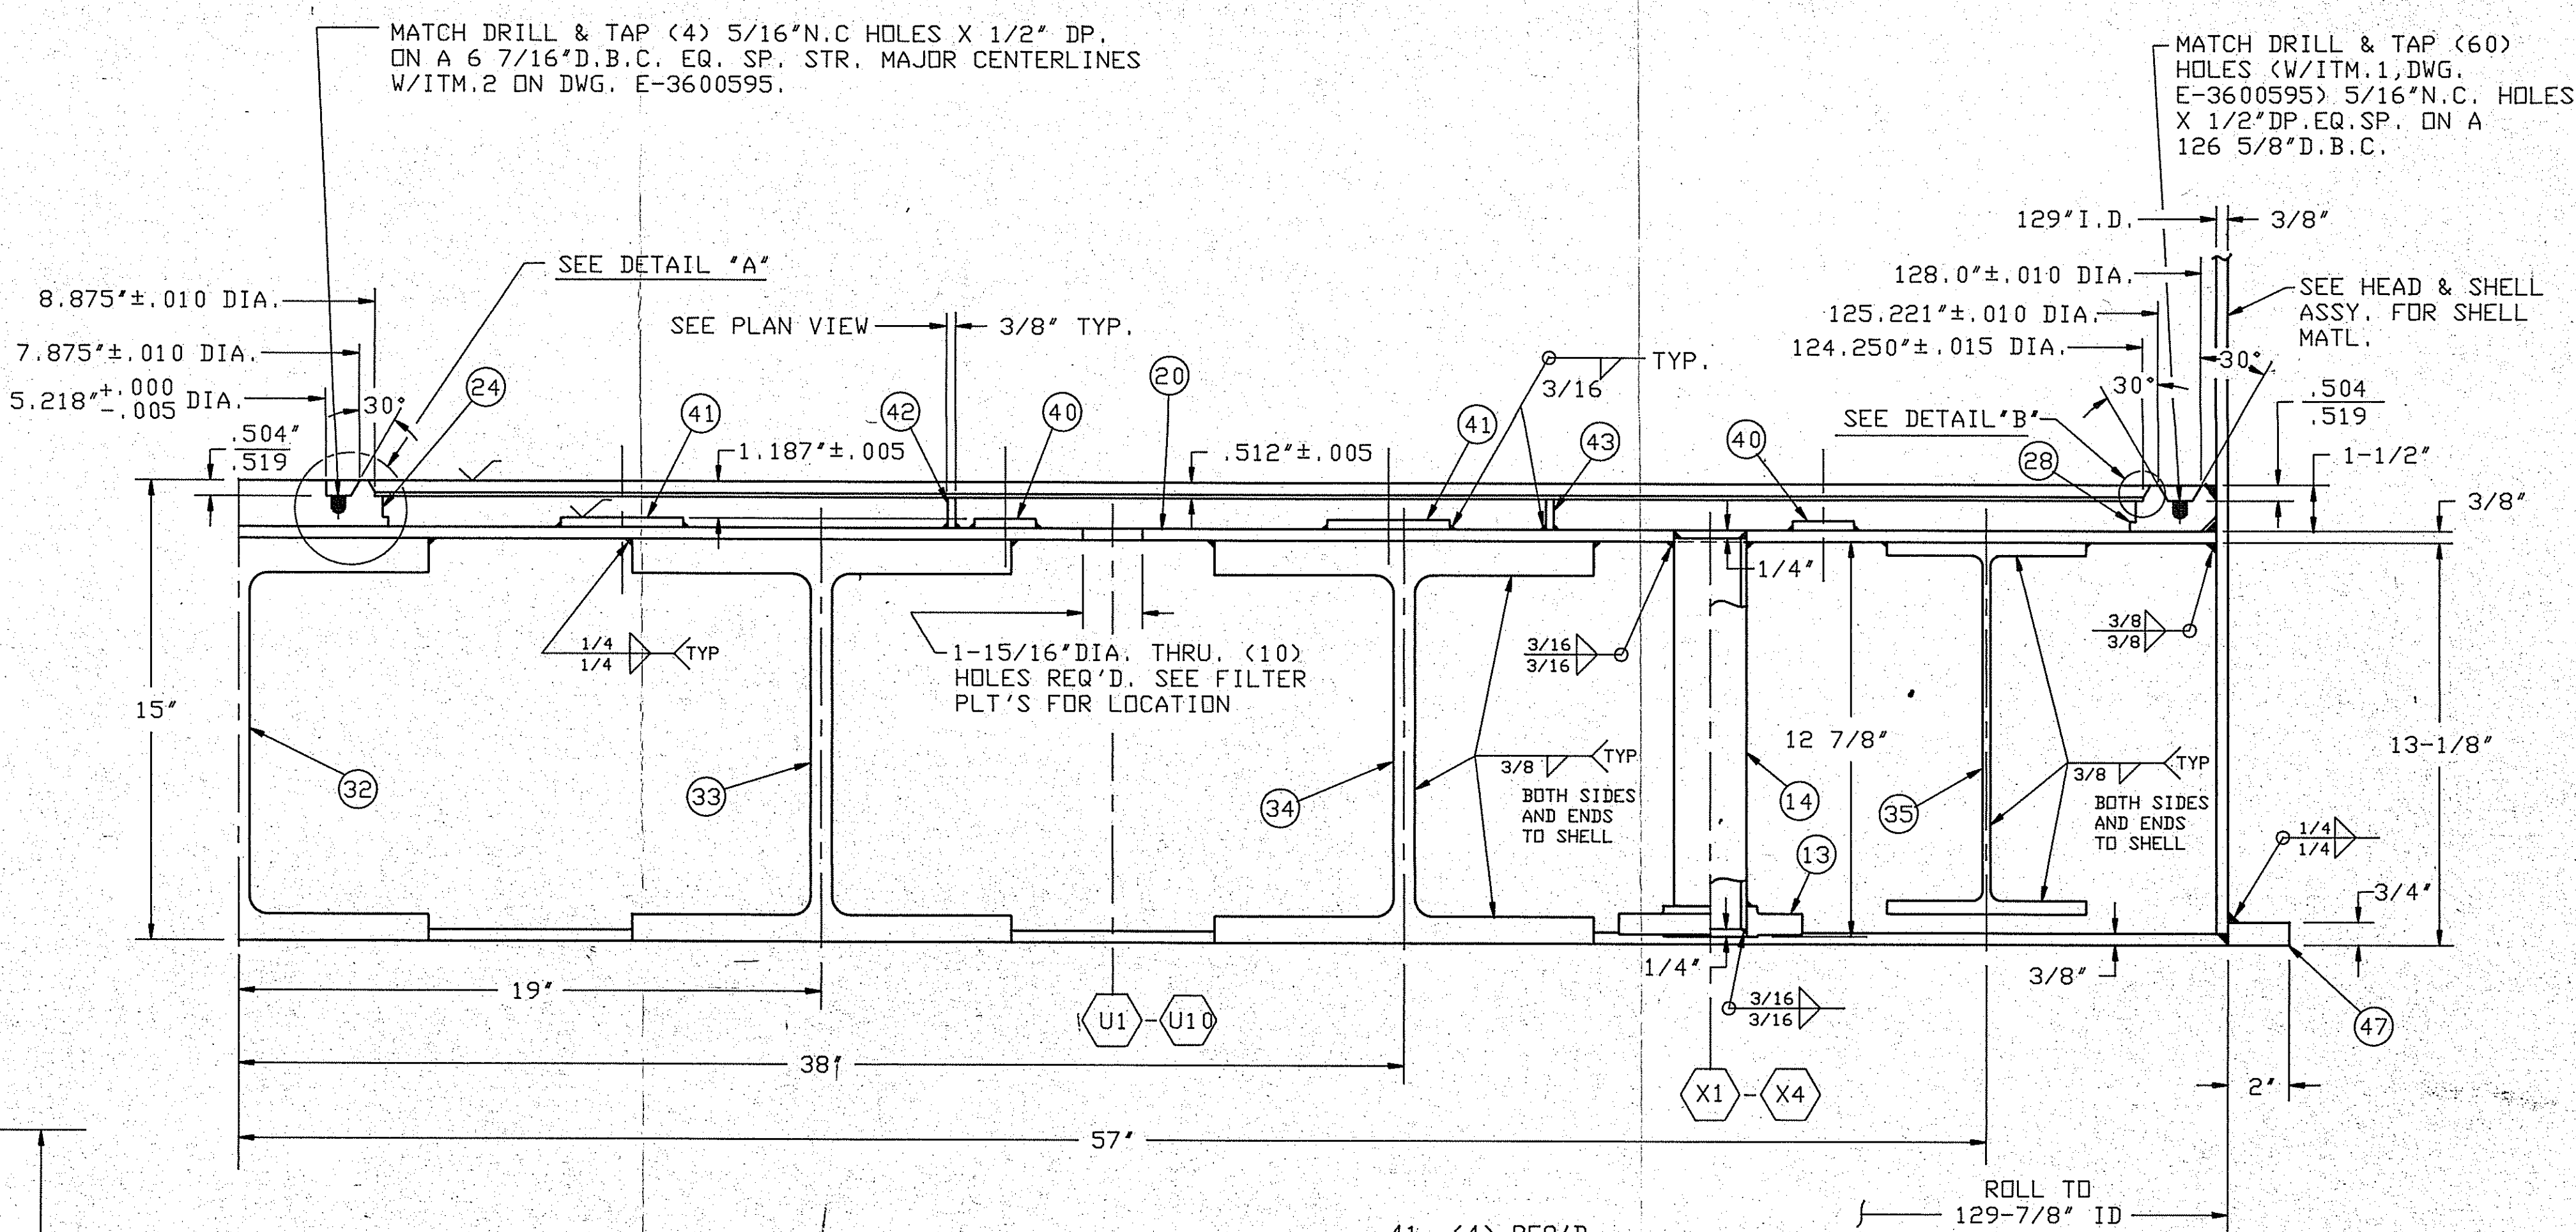

SIMONS-EASTERN CONSULTANTS, INC.
P. 3262A 001 OF 001
SHINZU AMERICA CORP.
SOFIX CORPORATION
RECEIVED: 06FEB93 COPIES: 3+1
P.O. NO. 000001 FILE # 005
EQUIP. # C-5100
REVIEWED
FOR GENERAL COMPLIANCE WITH THE DESIGN CONCEPT
OF THE PROJECT AND CONTRACT DOCUMENTS.
NO RESPONSIBILITY IS ASSUMED FOR CORRECTNESS
OF THE DRAWINGS.
BY: [Signature] DATE: 2/12/93
NOT ACCEPTABLE FOR RELEASE FOR PRODUCTION PURPOSES AND RELEASED
SUBJECT TO DESIGN AS INDICATED. RELEASED FOR PRODUCTION PURPOSES
ONLY.
NO EXCEPTION TAKEN. RELEASED FOR PRODUCTION. SUBMIT CERTIFIED
DRAWINGS.
CERTIFIED DRAWING ACCEPTED. RELEASED FOR PRODUCTION
AND NOT REQUIRED BY ENGINEERING DESIGN.

41. (4) REQ'D.					
40. (52) REQ'D.					
(**) 28. +0 -3/16 X 1 3/4" THK.					
055					
054					
053					
052					
051					
050					
049					
048	5117000	BAR, RND. 1 1/2" O.D. X 2" LG.	SA-479	304	.167
047	5042000	BAR, FL. 3/4" X 2" X 34'-6 5/16" LG.	SA-479	304	36.0
046		PREP. PARTS - P.N. 9126247			
045					
044					
043	5019000	BAR, FL. 3/8" X 1 1/2" X 28'-2 1/16" LG.	SA-479	304	30.0
042	5019000	BAR, FL. 3/8" X 1 1/2" X 11'-7 3/8" LG.	SA-479	304	12.0
041	6555038	PLATE, 1/2" THK. X 4" X 4" LG. (**)	SA-240	304	.0028
040	6555038	PLATE, 1/2" THK. X 2" X 4" LG. (**)	SA-240	304	.0181
039	6555017	SHEET, 11 GA. X 15'16" X 14'-0" LG. (APPROX.)	SA-240	304	.023
038		BAFFLES & BLOCKS - P.N. 9126246			
037					
036					
035	9101831	BEAM, I 12" X 31.8 LB./FT. X 71 3/4" LG.	SA-36	C.S.	2
034	9125193	BEAM, 12" W F 120 LB. X 112 1/2" LG.	SA-36	C.S.	2
033	9125192	BEAM, 12" W F 120 LB. X 126 3/8" LG.	SA-36	C.S.	2
032	9125192	BEAM, 12" W F 120 LB. X 129" LG.	SA-36	C.S.	1
031		SUPPORT BEAMS - P.N. 9126245			
030					
029					
028	9124949	RING, 129" O.D. +3/16 -0 X 123 1/4" I.D. (**)	SA-240	304	1
027		OUTER SUPPORT RING - P.N. 9126244			
026					
025					
024	9127079	DISC, 9 3/4" O.D. +1/16 -0 X 1 3/4" THK.	SA-240	304	1
023		CENTER DISC - P.N. 9126243			
022					
021					
020	9125194	DISC, 129" O.D. +1/8 -0 X 3/8" THK.	SA-240	304	1
019		FLAT HEAD - P.N. 9126242			
018					
017					
016					
015					
014	5231000	PIPE, 2" SCH. 40 X 12 7/8" LG.	SA-312	304	.3000
013	0100506	FLANGE, R.F.S.D. 2"-150# ANSI	SA-182	304	4
012					
011					
010					
009					
008					
007		PREP. PARTS - P.N. 9126247			
006		BAFFLES & BLOCKS - P.N. 9126246			
005		SUPPORT BEAMS - P.N. 9126245			
004		OUTER SUPPORT RING - P.N. 9126244			
003		CENTER DISC - P.N. 9126243			
002		FLAT HEAD - P.N. 9126242			
001	3600593	FILTER PLATE ASSY.	B/M	304	1
ITEM NO.	PART NO.	DRAWING NO.	MATERIAL OR DESCRIPTION	MATERIAL SPEC	QTY/PER UM
			* CUT LENGTH ON THIS B.O.M. FOR REFERENCE ONLY		

NO CORRECTIONS NOTED
MAKE CORRECTIONS NOTED
REVISE AND RESUBMIT
REJECTED-SEE REMARKS
DATE

PRINT FOR APPROVAL
Clarence J. Carroll
Customer Order No. 90-00001
Shop Order No. 90-BF-171
ROSENBLUM
Charlotte, NC 2-191

G					
F					
E					
D					
C					
B					
A					
REV.	DESCRIPTION	DATE	BY	CHECKED	APPROVED

GASTON COUNTY FABRICATION
A DIVISION OF GASTON COUNTY DYING MACHINE COMPANY
STANLEY, NORTH CAROLINA 704-263-4765

CUSTOMER ROSENBLUM INC., CHARLOTTE, N.C.
FOR SOFIX CORP.


TITLE M2 BASE ASSY., SIMPLE HEATED F.P.

CUSTOMER P.O. NO. 747 **CUSTOMER ITEM NO.** C5100

DRAWN BY H.K.M. **DATE** 1-21-93 **CHECKED BY** [Signature] **DATE** 1/28/93

SHOP ORDER NO. F-80816 **NO. REQUIRED** 1 **SHEET** 1




SCALE 1/8"=1' **No.** E-3600592

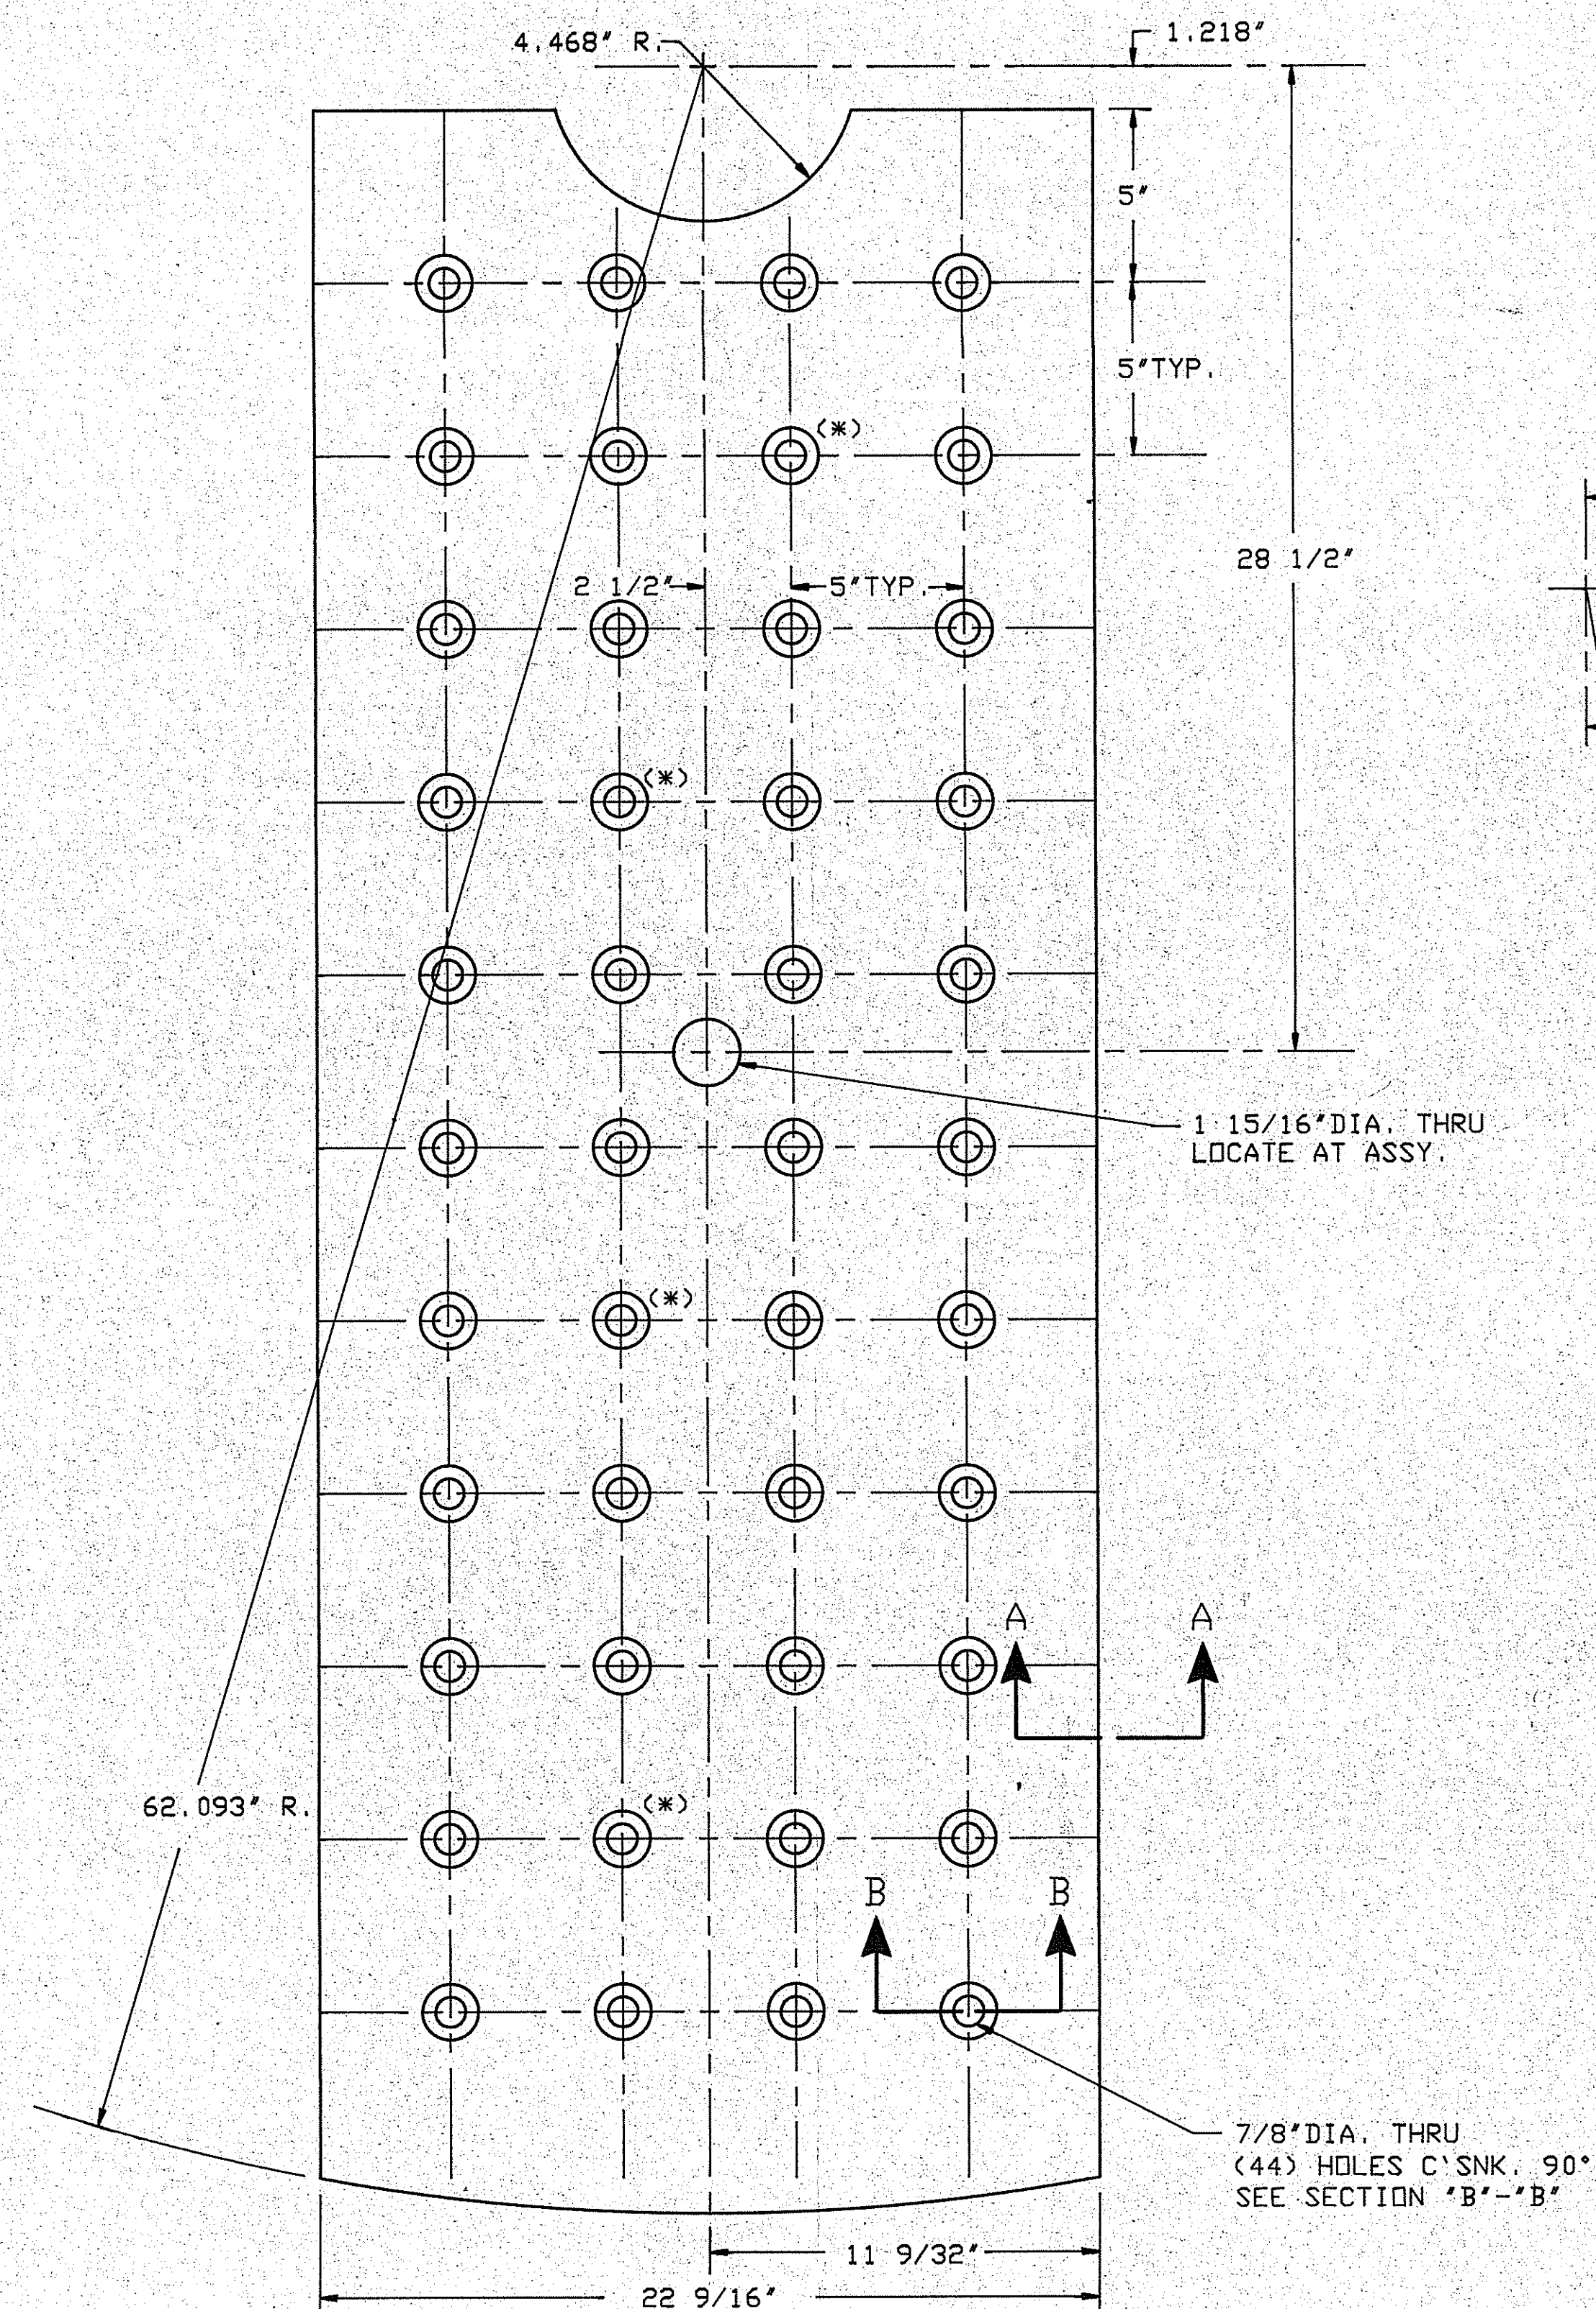

1 CENTER FILTER PLATE

SCALE-3'=1'

- (1) REQ'D. AS SHOWN
(1) REQ'D. OPPOSITE HAND

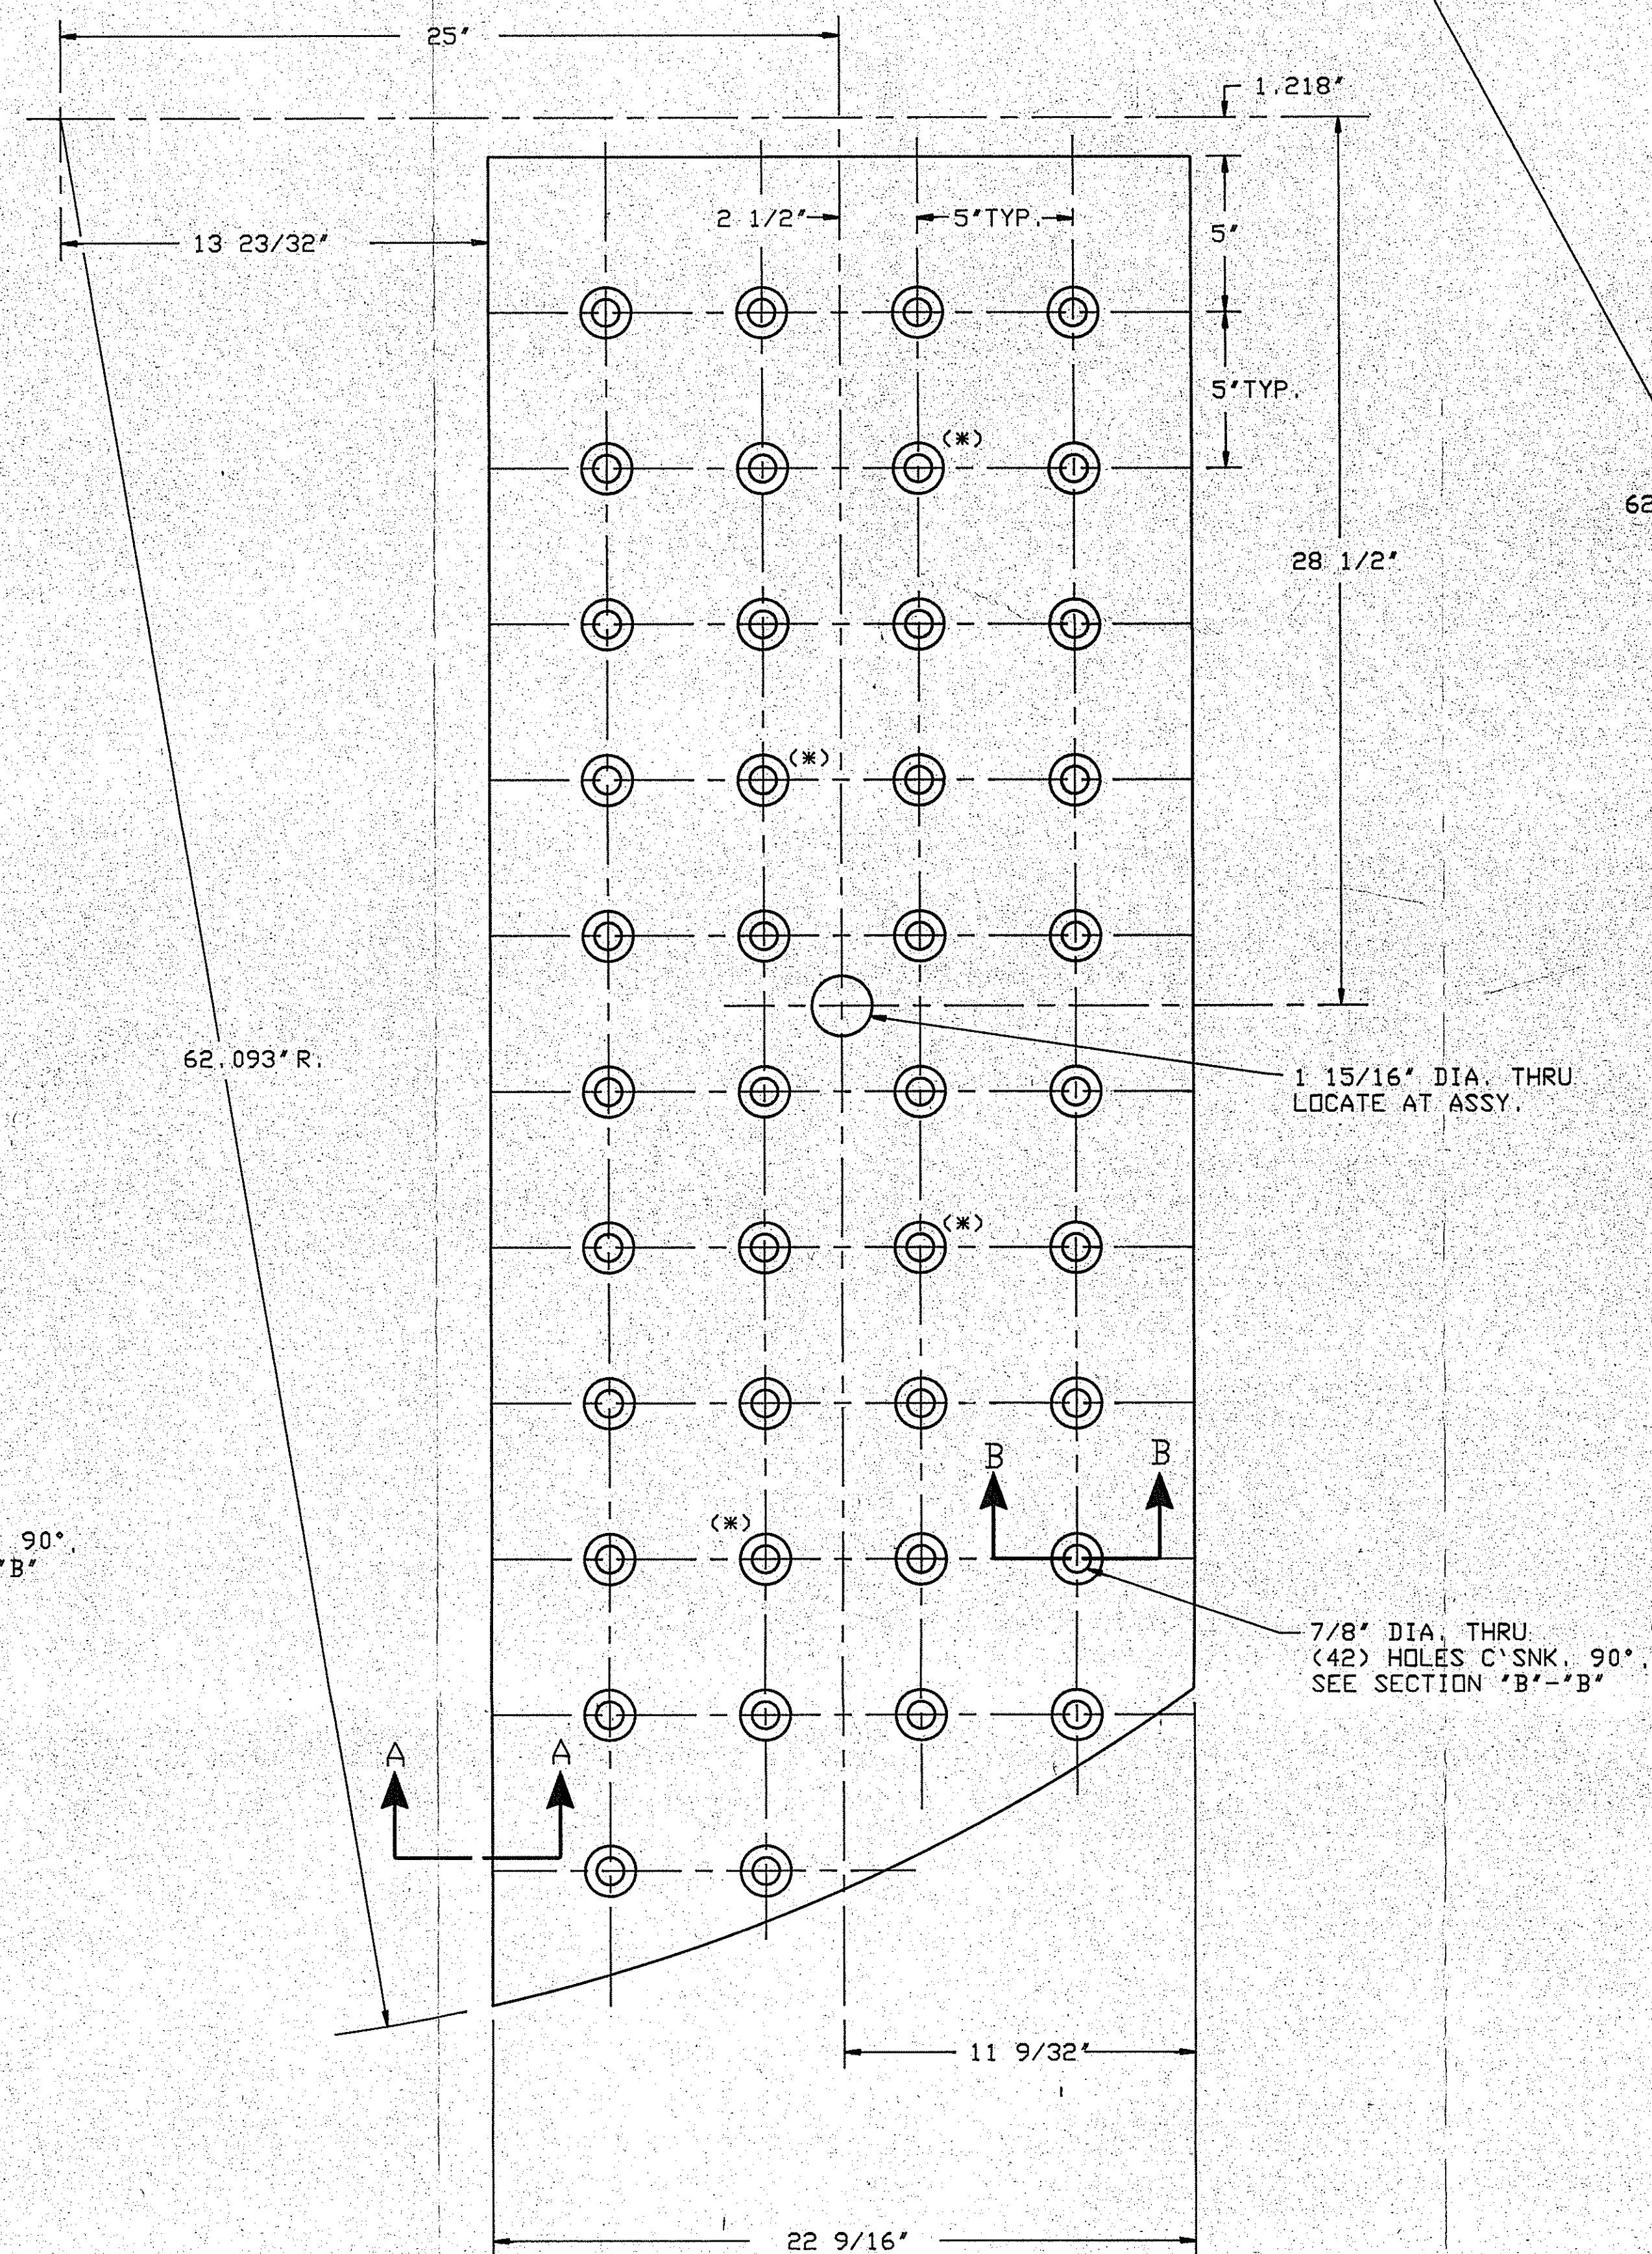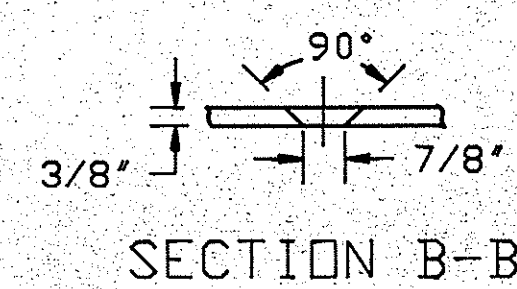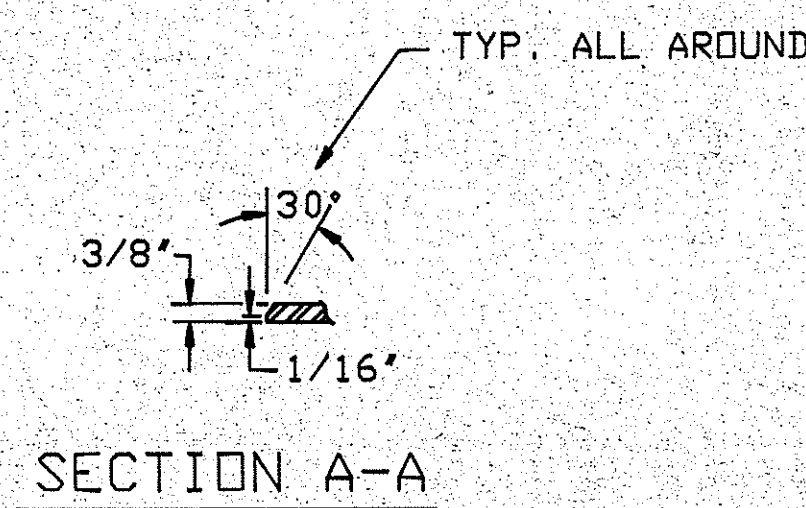


2 MIDDLE FILTER PLATE

SCALE-3'=1'

- (2) REQ'D. AS SHOWN
(2) REQ'D. OPPOSITE HAND

NOTE:
ALL HOLES WITH (*) SYMBOL
ARE TO HAVE STAY BARS
WITH TAPPED HOLES AT ASSY.

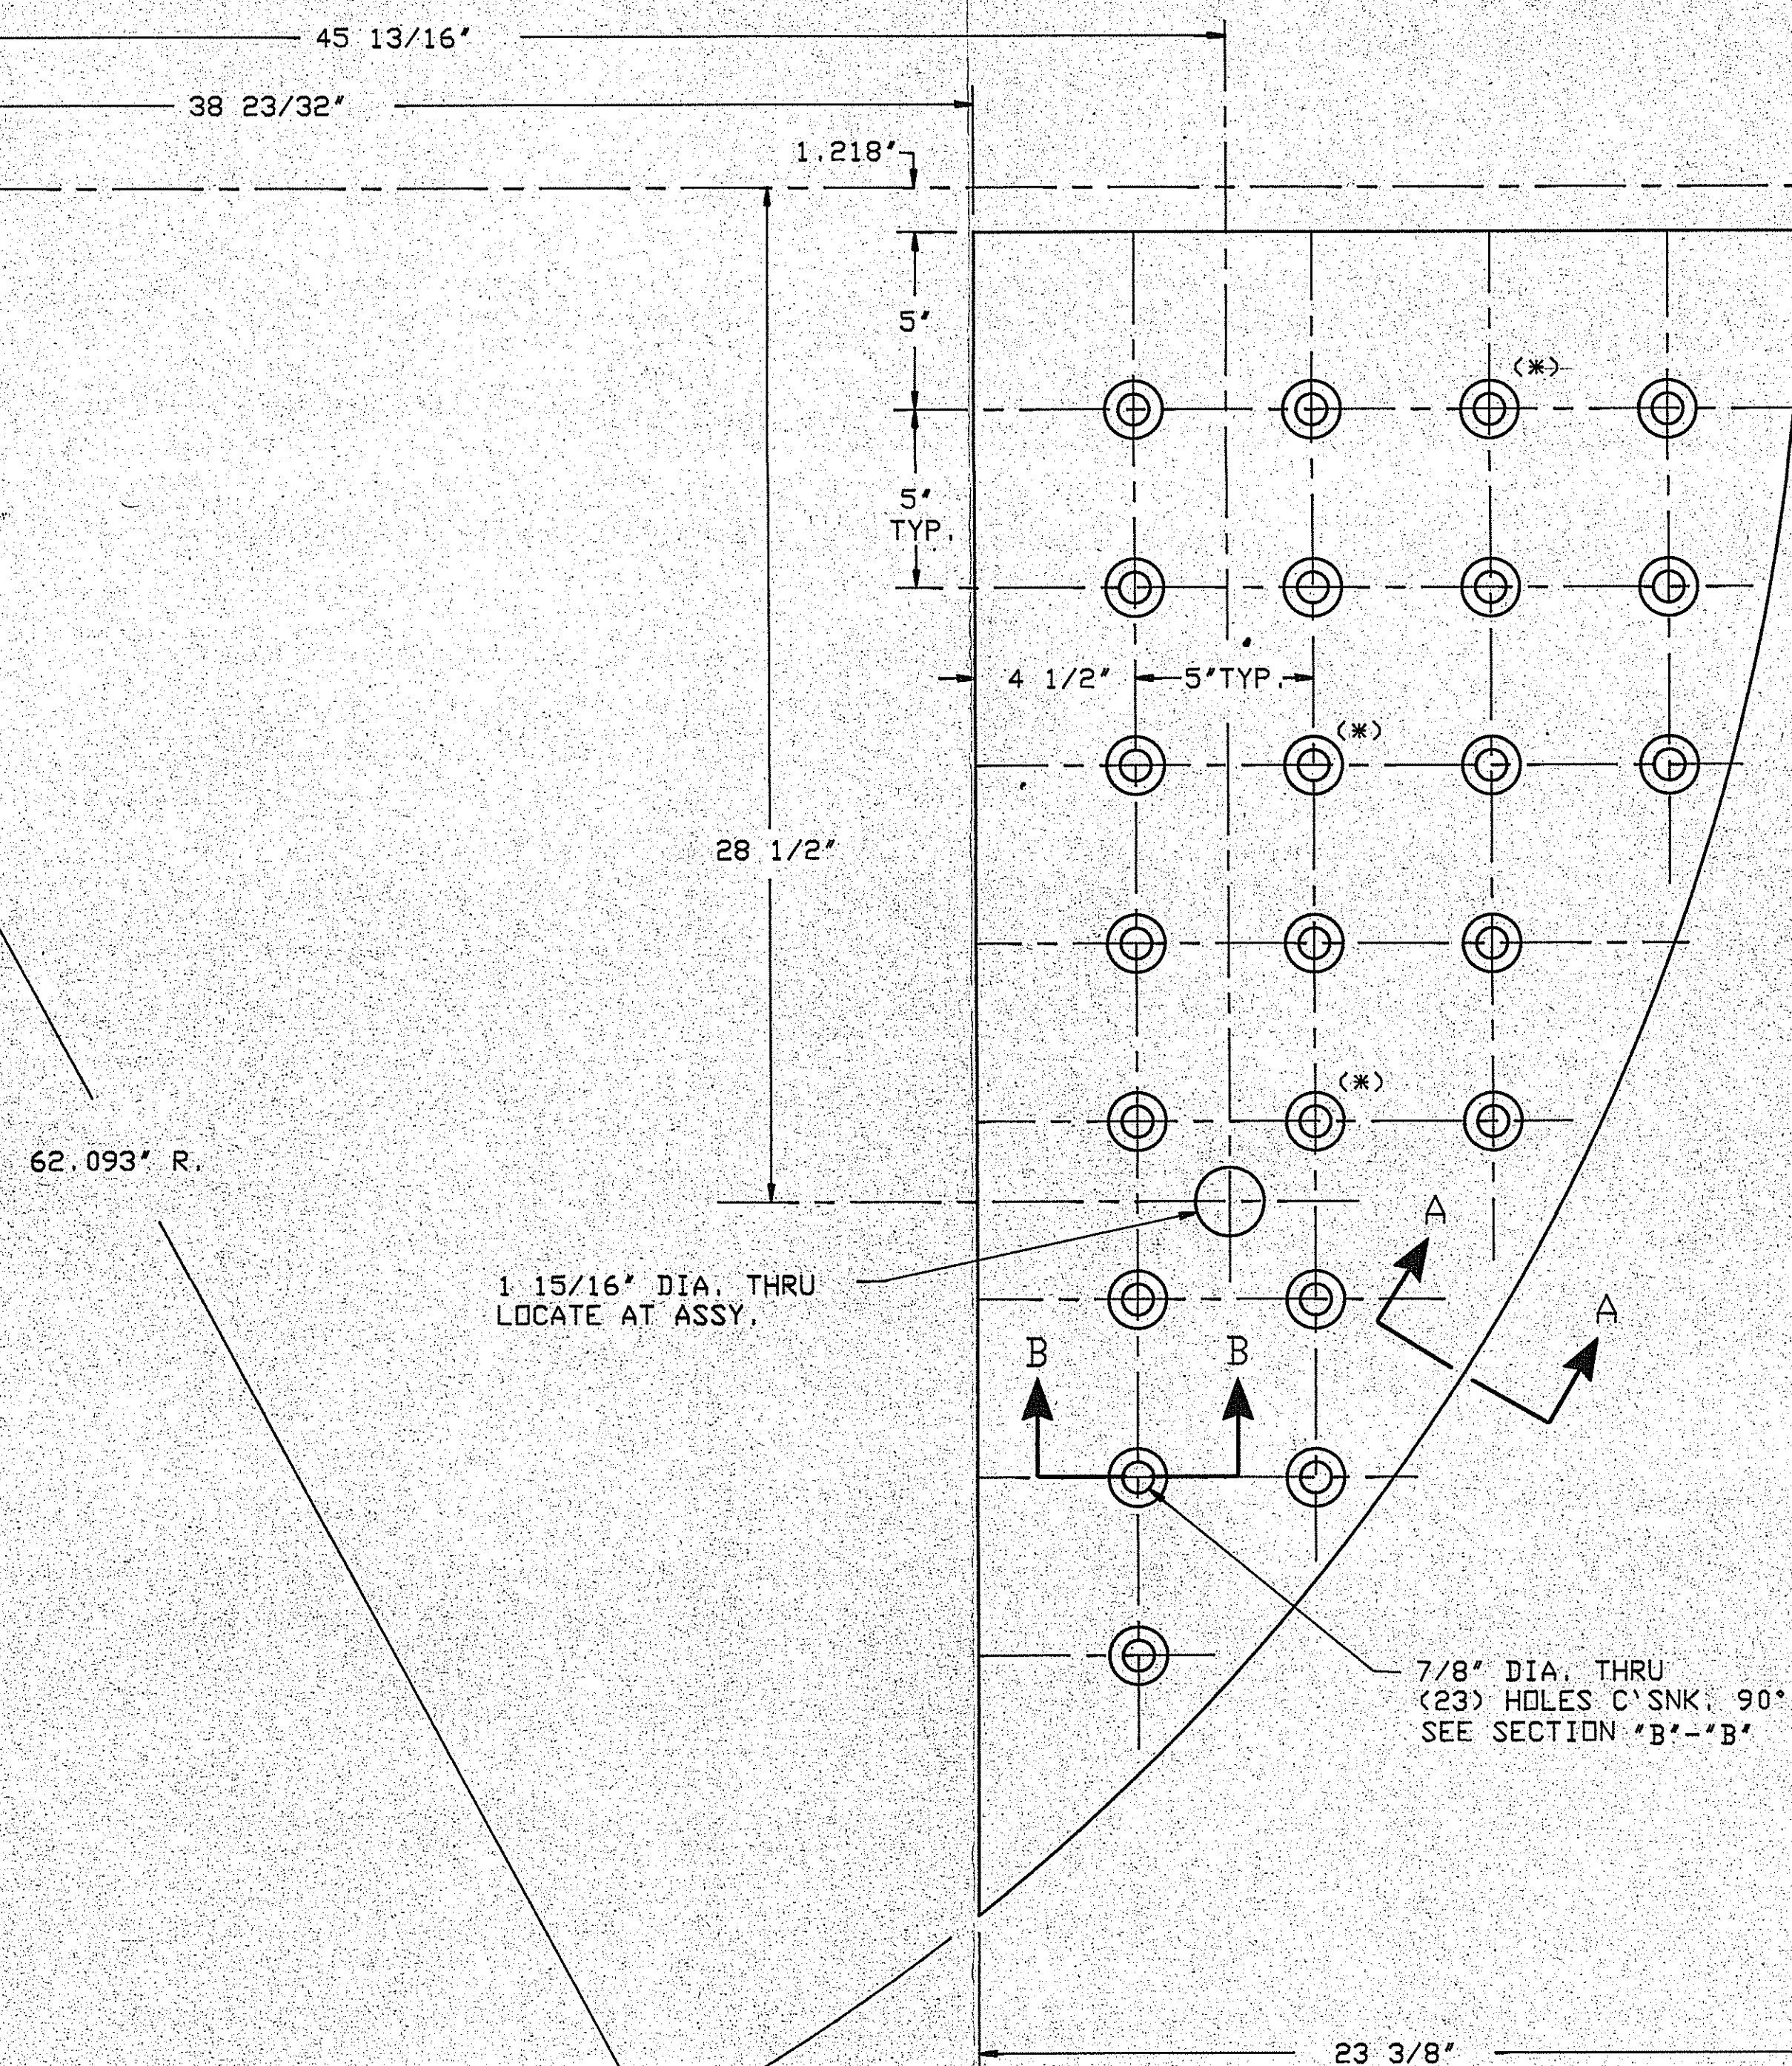

3 END FILTER PLATE

SCALE-3'=1'

- (2) REQ'D. AS SHOWN
(2) REQ'D. OPPOSITE HAND

SIMONS-EASTERN CONSULTANTS, INC.
P. 5263A 001 OF 001
SHIMIZU AMERICA CORP.
SOFIX CORPORATION
RECEIVED 06/15/91 COPIES 3+1
PO. 90-00001 FILE # 007
EQUIP # C-5100
REVIEWED
FOR GENERAL COMPLIANCE WITH THE DESIGN CONCEPT
OF THE PROJECT AND CONTRACT DOCUMENTS.
NO RESPONSIBILITY IS ASSUMED FOR CORRECTNESS
OF THE DRAWING.
BY DATE 7/15/91
NOT ACCEPTABLE FOR PRODUCTION REVIEW AND REWORK
SUBJECT TO DESIGNER'S REVIEW. RELEASED FOR PRODUCTION
NO EXCEPTION TAKEN. RELEASED FOR PRODUCTION. SUBMIT CERTIFIED
DRAWING.
CERTIFIED DRAWING ACCEPTED. RELEASED FOR PRODUCTION.
NOT REQUIRED BY DESIGN FOR ENGINEERING DESIGN.

GASTON COUNTY DYING MACHINE COMPANY
CHECKED BY

- (1) NO CORRECTIONS NOTED
(1) MAKE CORRECTIONS NOTED
(1) REVISE AND RESUBMIT
(1) REJECTED-SEE REMARKS

BY
DATE

REV.	PART NO.	DRAWING NO.	MATERIAL OR DESCRIPTION	MATERIAL SPEC	QTY/PER UM
003	9120027		PLATE, 3/8" X 64" X 128" LG.	SA-240	304 .5860 UM
002	9120027		PLATE, 3/8" X 64" X 128" LG.	SA-240	304 .6939 UM
001	9120027		PLATE, 3/8" X 64" X 128" LG.	SA-240	304 .3567 UM

* CUT LENGTH ON THIS B.O.M. FOR REFERENCE ONLY

REV.	DESCRIPTION	DATE	BY	CHECKED	APPROVED
G					
F					
E					
D					
C					
B					
A					




RETURN TO VENDOR

GASTON COUNTY FABRICATION
A DIVISION OF GASTON COUNTY DYING MACHINE COMPANY
STANLEY, NORTH CAROLINA 28154-4766

CUSTOMER ROSENTHAL INC. CHARLOTTE, N.C.
FOR SOFIX CORP.

TITLE: FILTER PLATE DETAILS, SIMPLE HEAT
8M2 FILTER VESSEL
CUSTOMER P.O. NO. 747 CUSTOMER ITEM NO. CS100
DRAWN BY H.K.M. DATE 1-9-91 CHECKED BY DATE 1-28-91
SHOP ORDER NO. F-80816 NO. REQUIRED 1 SHEET
SCALE 3'=1' No. E-3600594

PRINT FOR APPROVAL
Charles E. Small
Customer Order No. 90-00001
Shop Order No. 90-BF-171
ROSENTHAL INC.
Charlotte, NC 28191

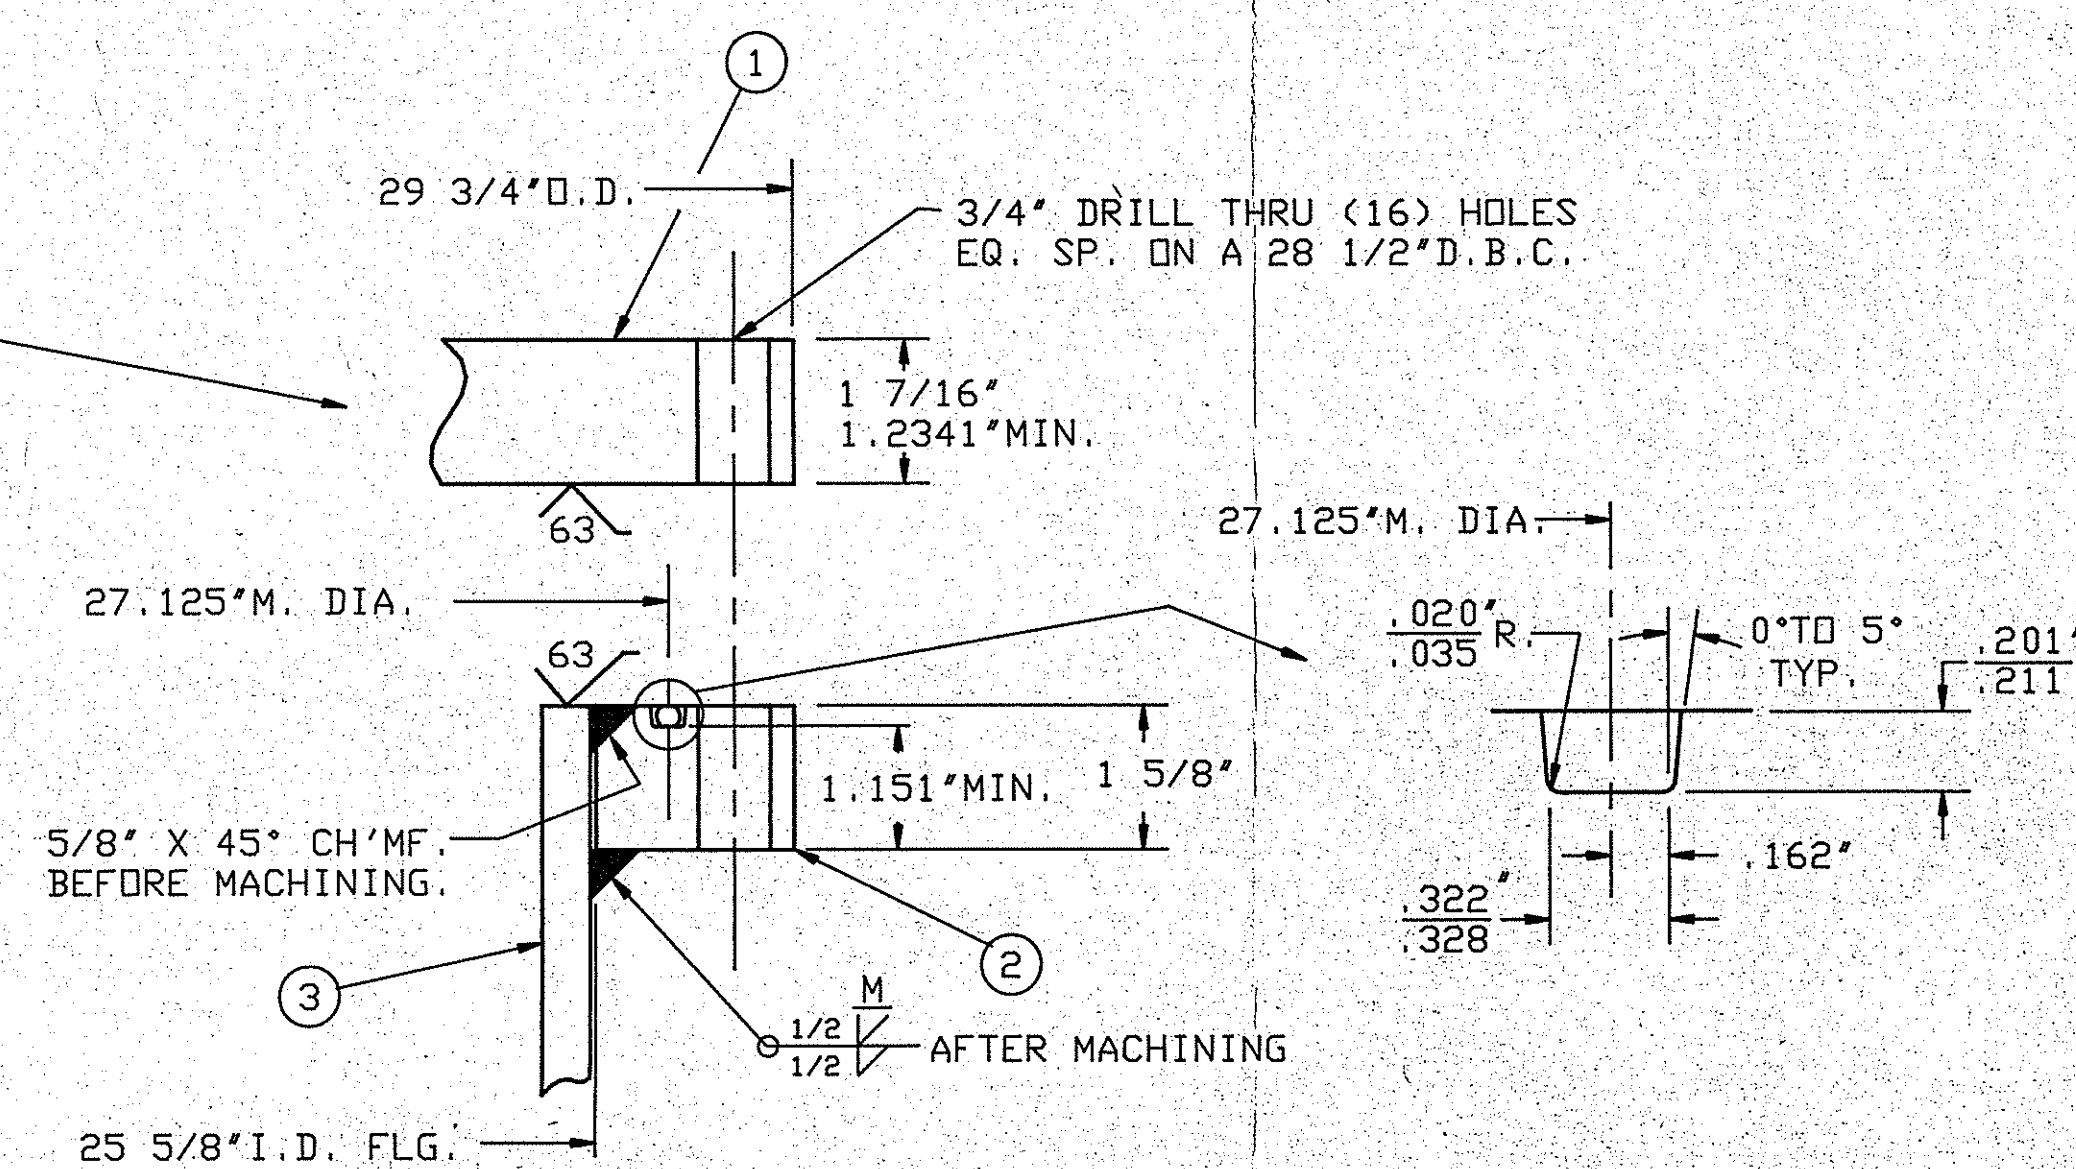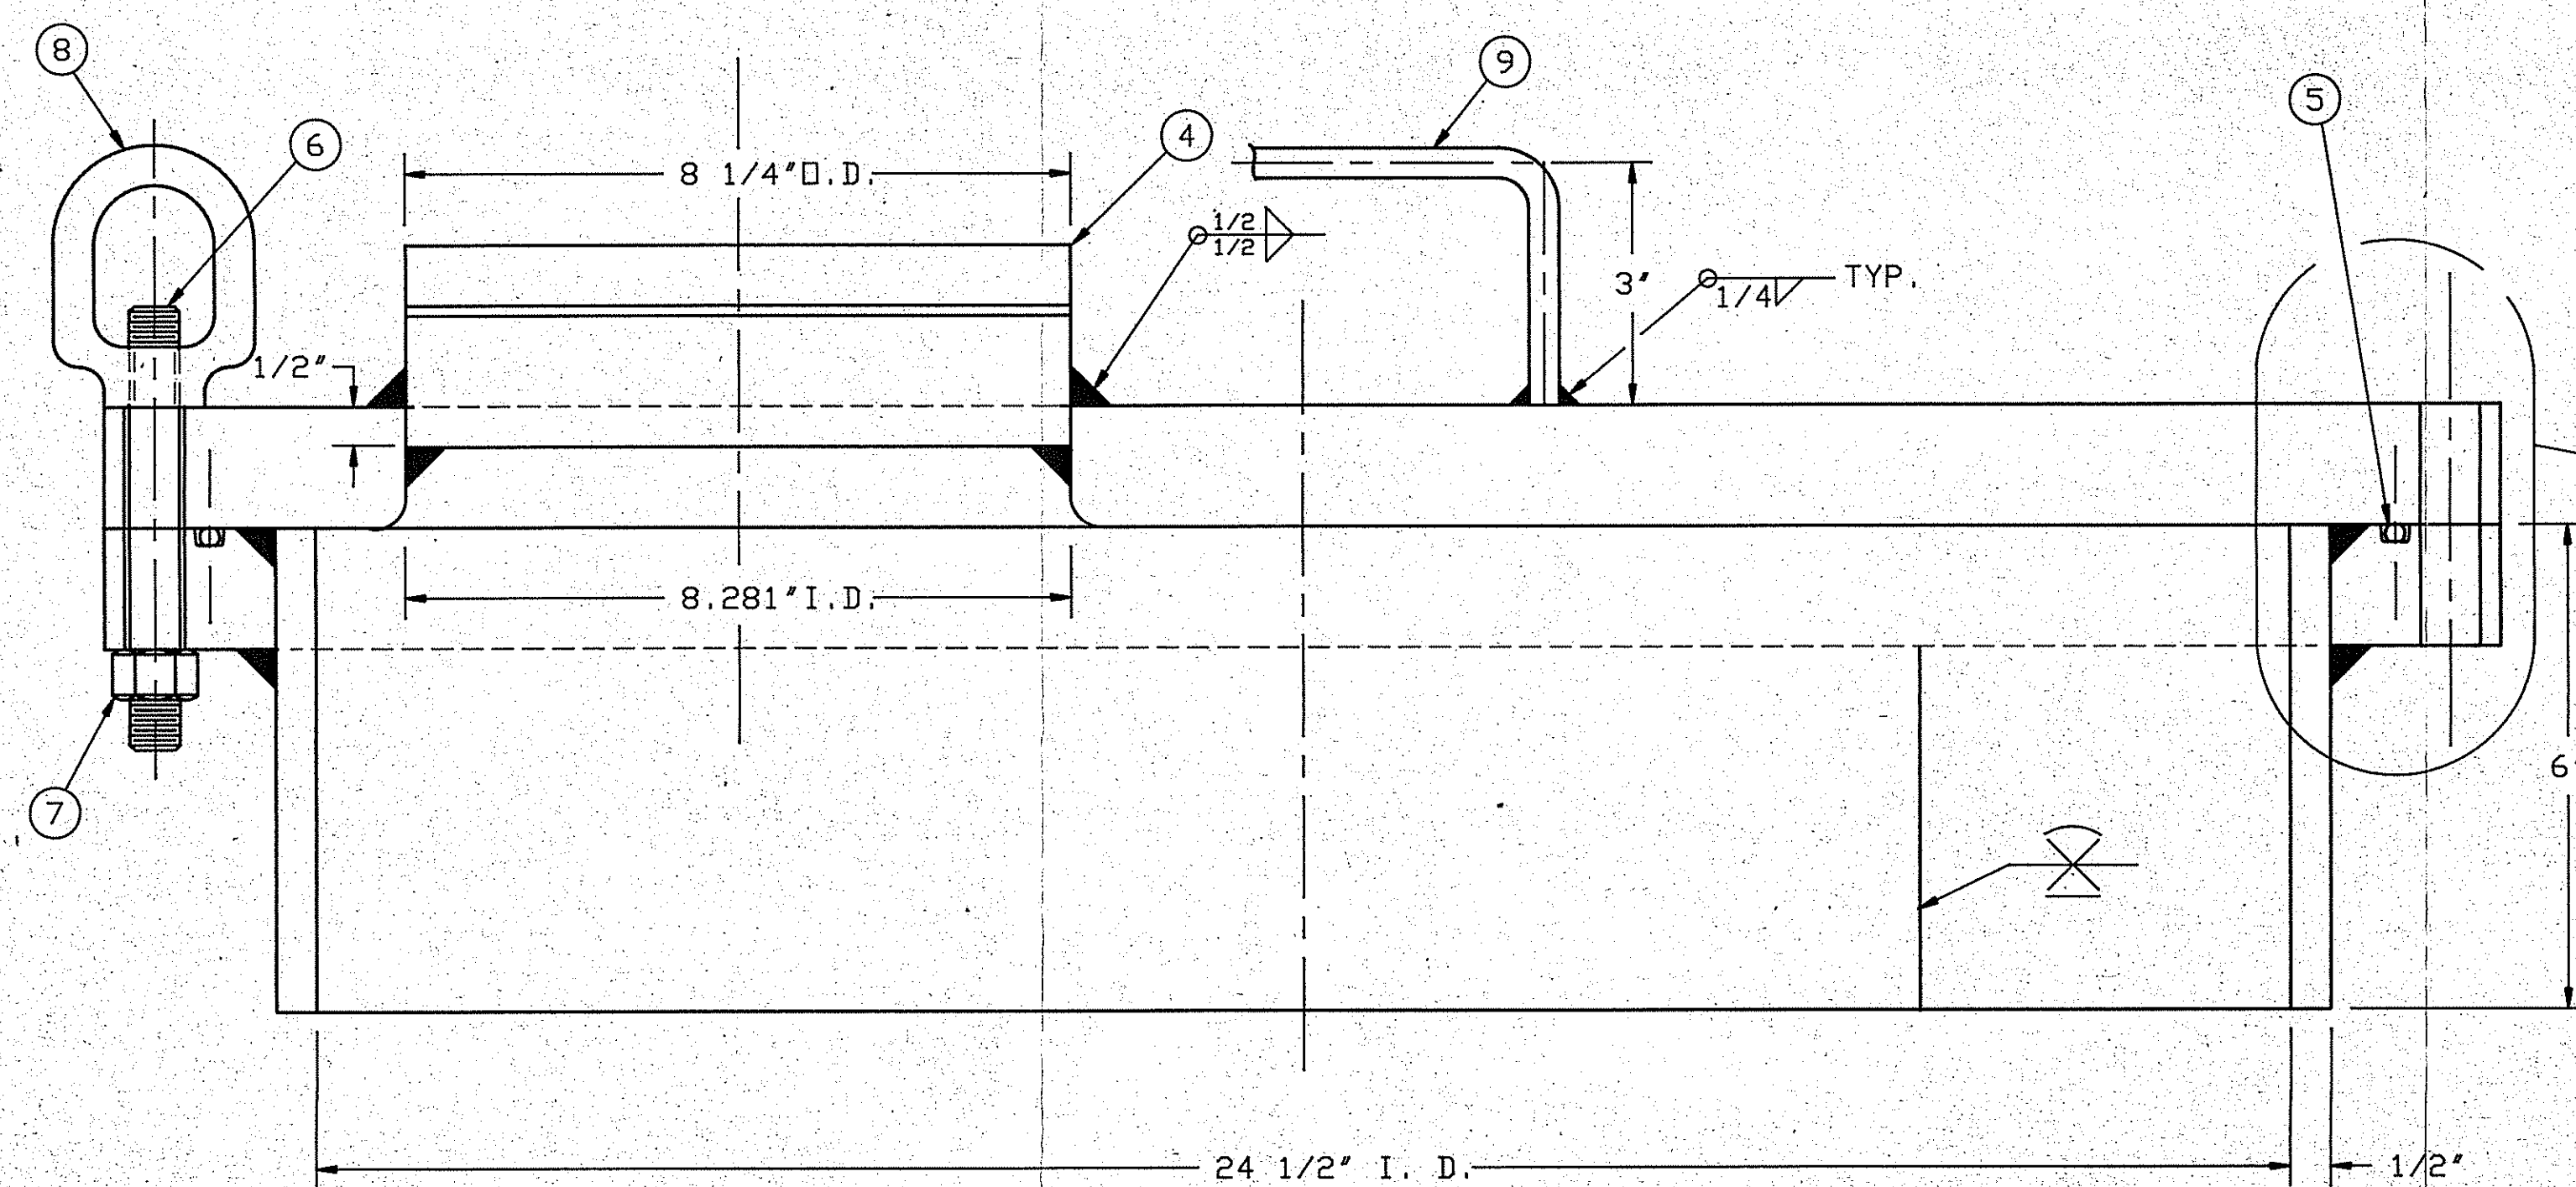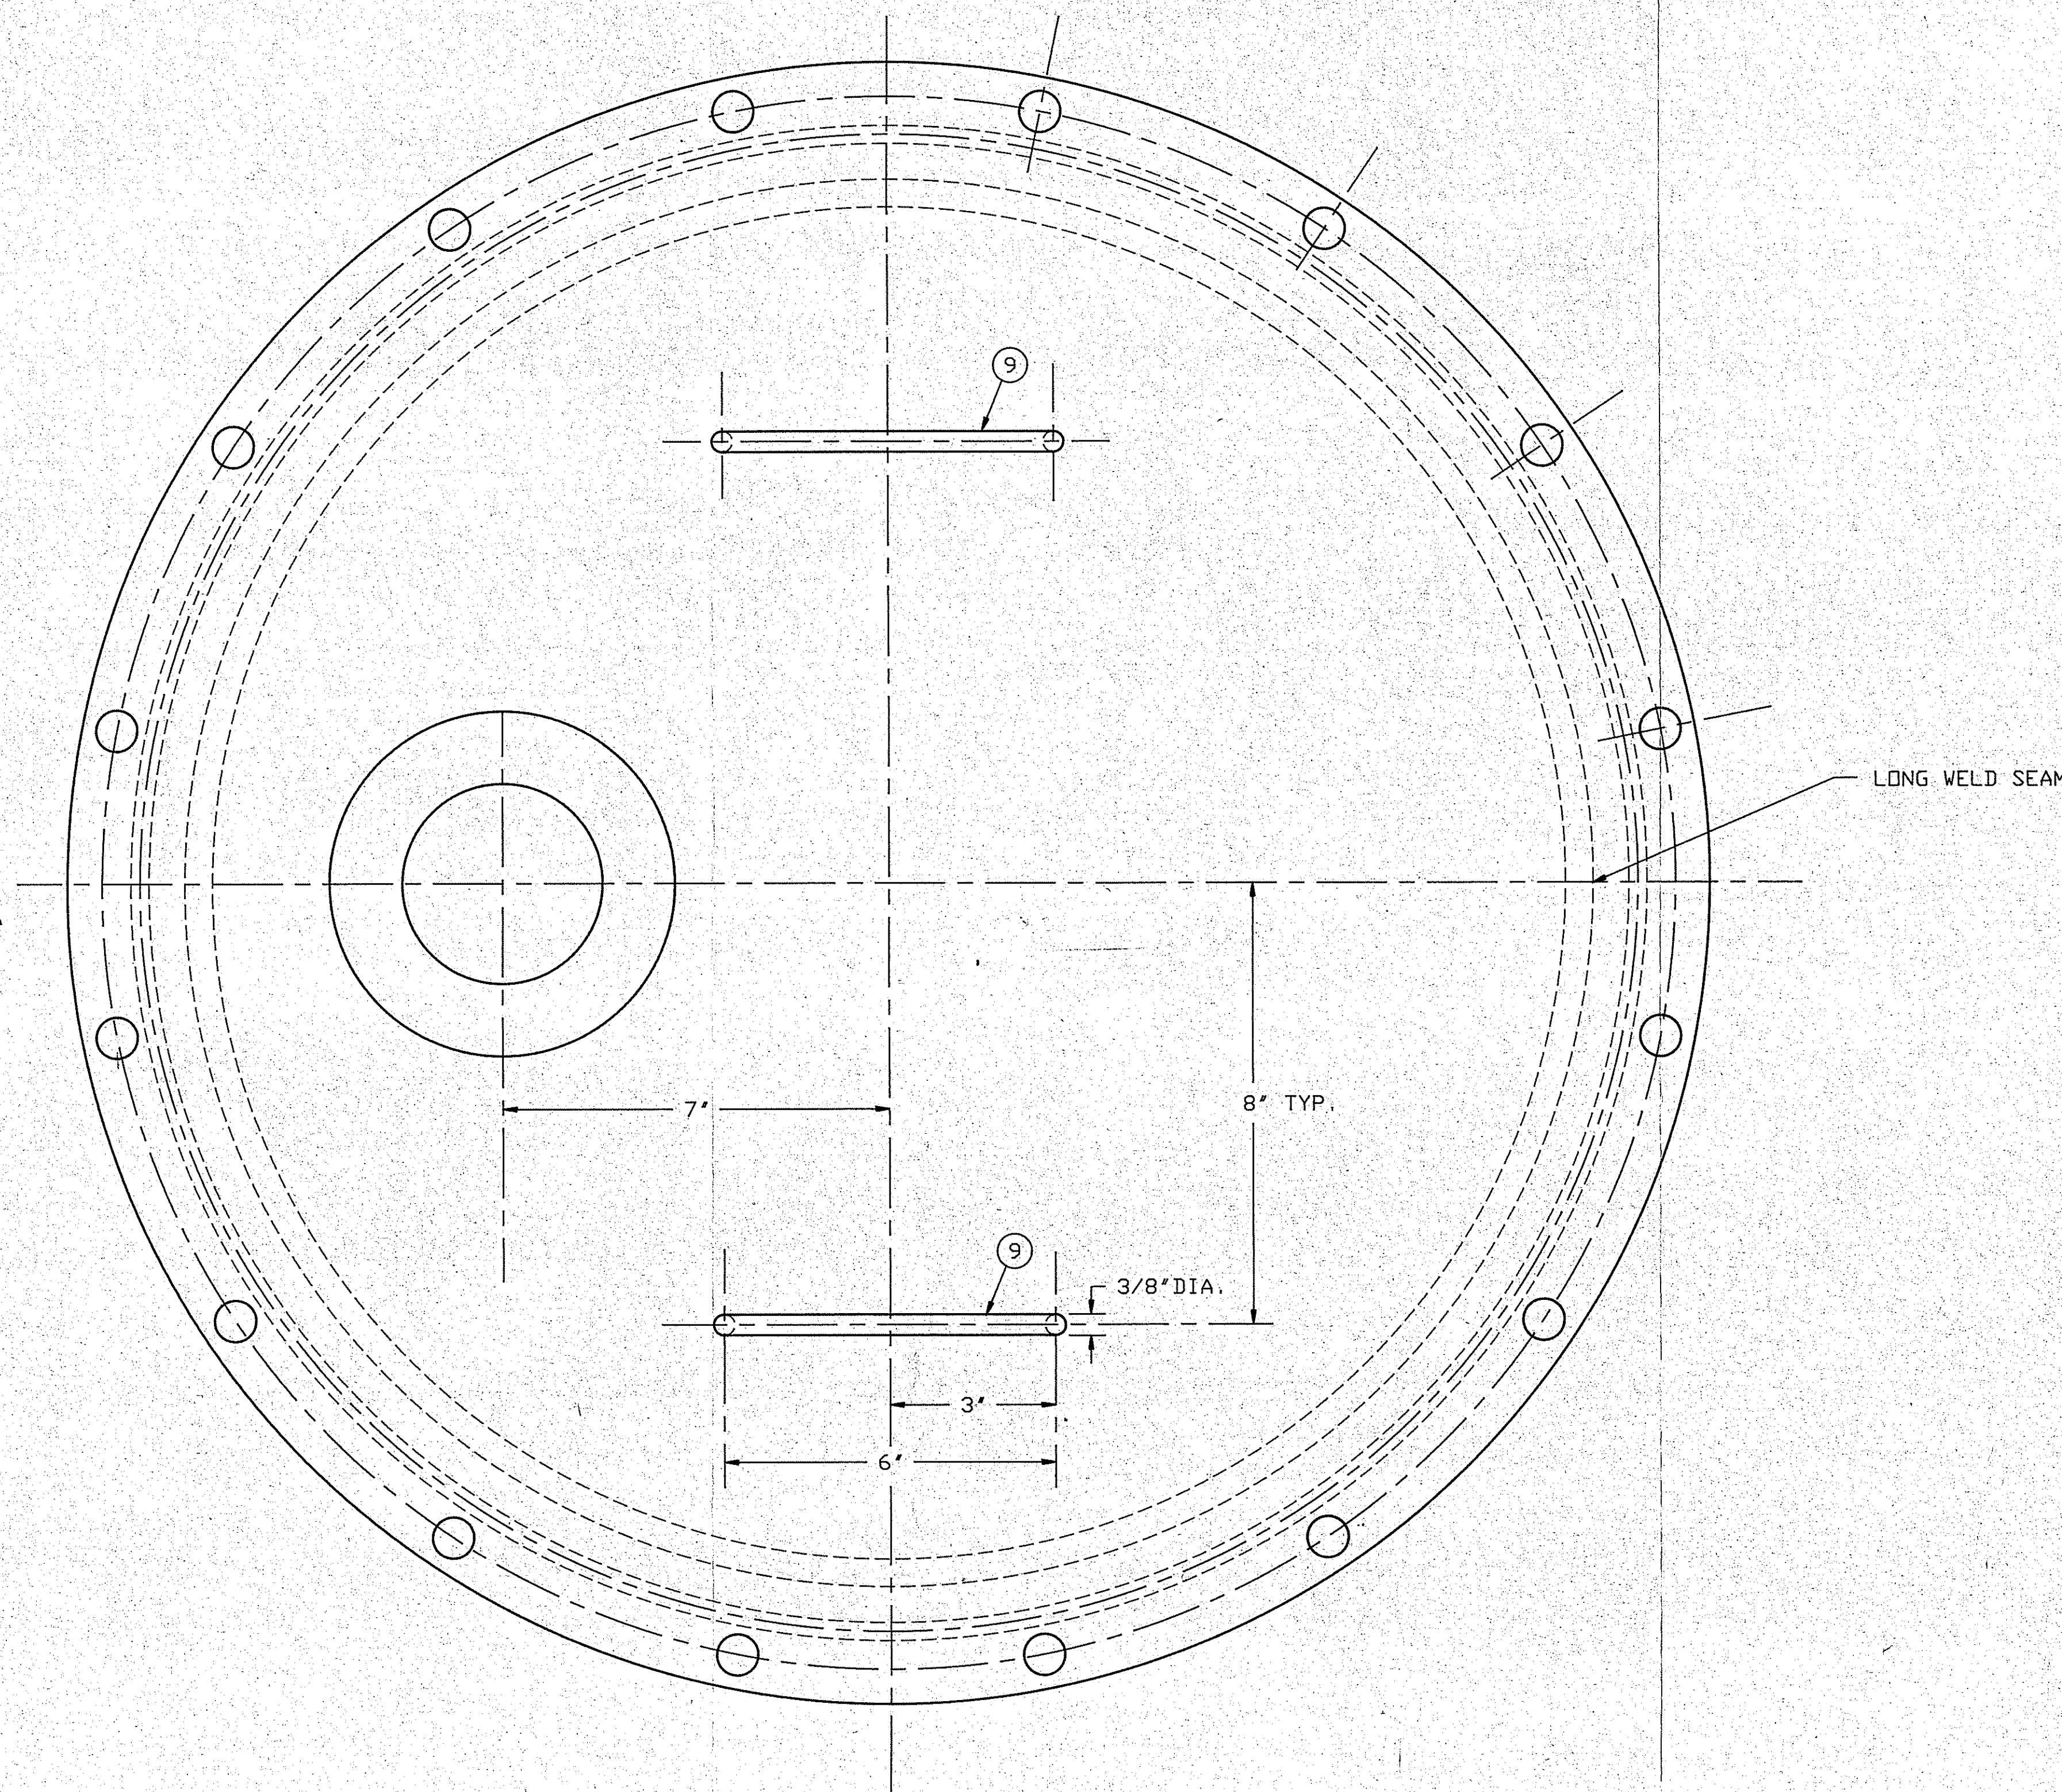

SOFIX WANTS THE MANWAY TYPE SHOWN ON ROSENTHAL'S DRAWING NO. E-3600509, WHICH WAS SHOWN TO US ON HARRY PERLMUTTER'S VISIT ON DEC. 20, 1990.

(**) 9. (2) REQ'D.
(**) 4. F.V.@400°F ASME STYLE "B" WELD IN
(**) 2. +0 -1/16 X 1 3/4" THK.

SIMONS-EASTERN CONSULTANTS, INC.
P.5262A 001 OF 001
E-3600598
SHINZU AMERICA CORP.
SOFIX CORPORATION
RECEIVED: 06 FEB 91 COPIES: 3+1
PO: 90-00001 FILE: 011
EQUIP #: C-5100
FOR GENERAL COMPLIANCE WITH THE DESIGN CONCEPT OF THE PRODUCT AND CONTRACT DOCUMENTS, NO RESPONSIBILITY IS ASSUMED FOR CORRECTNESS OF THE DRAWING.
BY: [Signature] DATE: 2/18/91
☐ NOT ACCEPTABLE AND NOT RELEASED FOR PRODUCTION REVIEW AND RESUBMIT
☒ CORRECTED PERIODICALLY AS REQUIRED FOR PRODUCTION REVIEW AND RESUBMIT
☐ NO PRODUCTION REVIEW RELEASED FOR PRODUCTION REVIEW AND RESUBMIT
☐ CORRECTED PERIODICALLY AS REQUIRED FOR PRODUCTION REVIEW AND RESUBMIT
☐ NOT REQUIRED BY BUYERS FOR ENGINEERING DESIGN

CHECKED BY: [Signature]
DATE: [Signature]
BY: [Signature]
DATE: [Signature]
[] NO CORRECTIONS NOTED
[] MAKE CORRECTIONS NOTED
[] REVISE AND RESUBMIT
[] REJECTED-SEE REMARKS

ITEM NO.	PART NO.	DRAWING NO.	MATERIAL OR DESCRIPTION	MATERIAL SPEC	MAT'L TYPE	QTY/PER UM
009	5105000		BAR, RND. 3/8" X 12" LG. (***)	SA-479	304	2.0000
008	1601011	C-1601011	RING NUT 5/8"N.C.	SB-62	BRZ.	16
007	9115372		NUT, HEX 5/8"N.C. (CAD. PLT.)	SA-1942H	C.S.	16
006	9123192		STUD, THRD. 5/8"N.C. X 6 1/2" LG., CAD. PL	SA-19387	C.S.	16
005	9125199		O-RING, .275" DIA. X 26 7/8" I.D. (TEF. ENC.)	VIT.		3
004	9125198		SIGHT GLASS, PRESS. P. 6"-150# & (***)	SA-240	304	1
003	6555038		PLATE, 1/2" THK. X 6 1/4" X 78 9/16"	SA-240	304	0.02132
002	9127076		RING, 29 3/4" D.D. +1/16 -0 X 25 5/8" (***)	SA-240	304	1
001	9127075		DISC, 29 3/4" D.D. +1/16 -0 X 1 1/2" THK.	SA-240	304	1




REV.	DESCRIPTION	DATE	BY	CHECKED	APPROVED
G					
F					
E					
D					
C					
B					
A					

GASTON COUNTY FABRICATION
A DIVISION OF GASTON COUNTY DYING MACHINE COMPANY
STANLEY, NORTH CAROLINA 2704-263-4765
TITLE: 24 1/2" I.D. MANWAY ASSY.
CUSTOMER: ROSENTHAL INC., CHARLOTTE, N.C. FOR SOFIX CORP.
CUSTOMER P.O. NO. 747 CUSTOMER ITEM NO. CS100
DRAWN BY: HKM DATE: 1-14-91 CHECKED BY: [Signature] DATE: 1/28/91
SHOP ORDER NO. F-808166 NO. REQUIRED: 1 SHEET OF 1
SCALE: 6" = 1" No. E-3600598 REV.

CAD REFERENCE NO.
RD00149A

ASME CODE	CODE	SPEC	DATE
REV	DATE	APP.	


PRINT FOR APPROVAL
Customer Order No. 90-00001
Shop Order No. 90-EF-171
ROSENTHAL
Charlotte, NC 28191

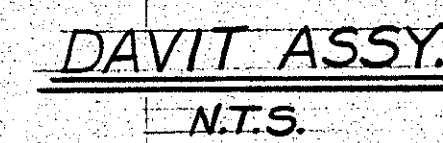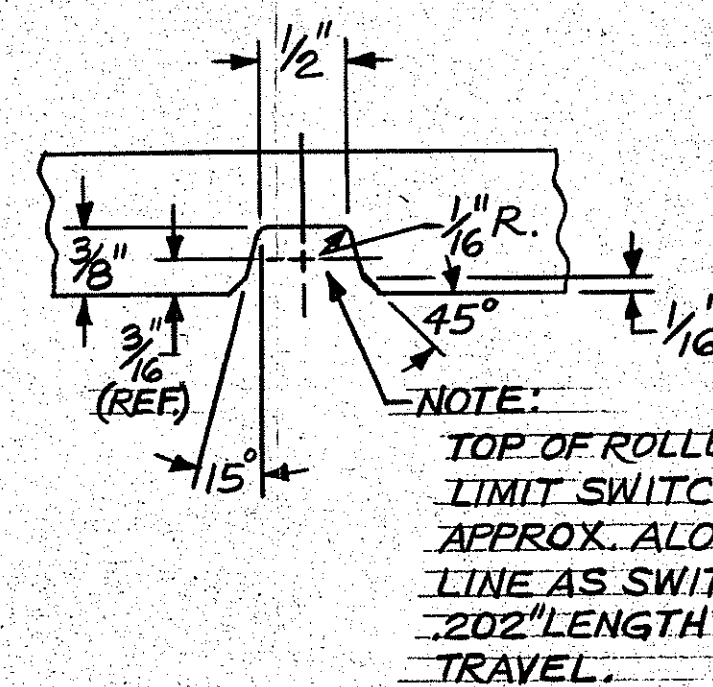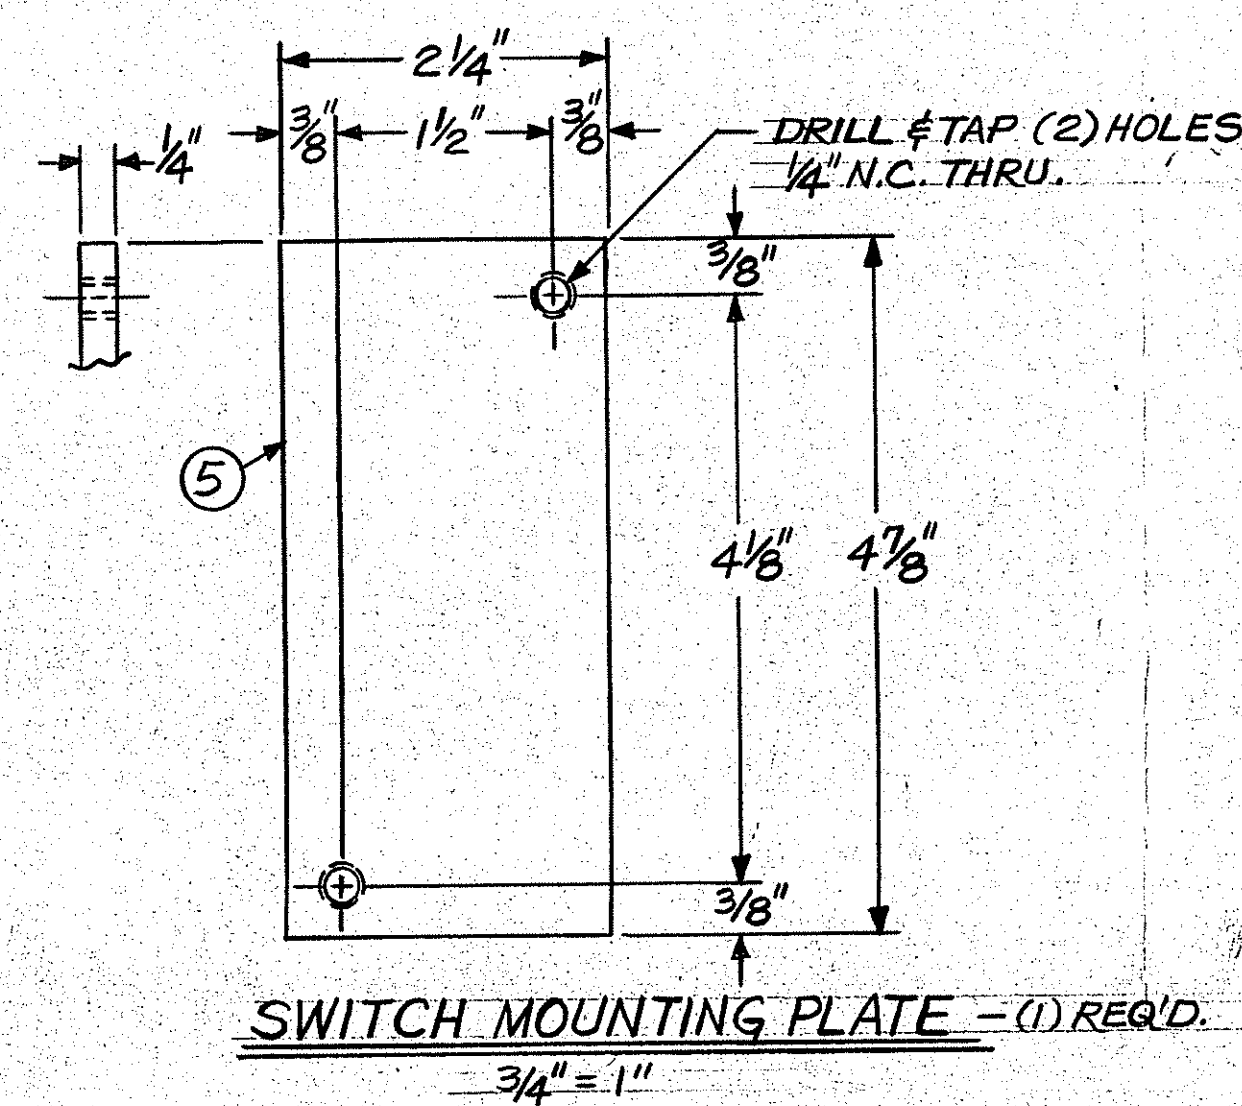

PRINT FOR APPROVAL
Clarence S. Samell
 Customer Order No. 90-00001
 Shop Order No. 90-PF-171
 ROSENMUND
 Charlotte, NC 2.1.91

GASTON COUNTY FABRICATION
A DIVISION OF GASTON COUNTY DYEING MACHINE COMPANY
STANLEY, NORTH CAROLINA 704-263-4765

This shop drawing is the property of Gaston County Dyeing Machine Company and is not to be reused without written permission.

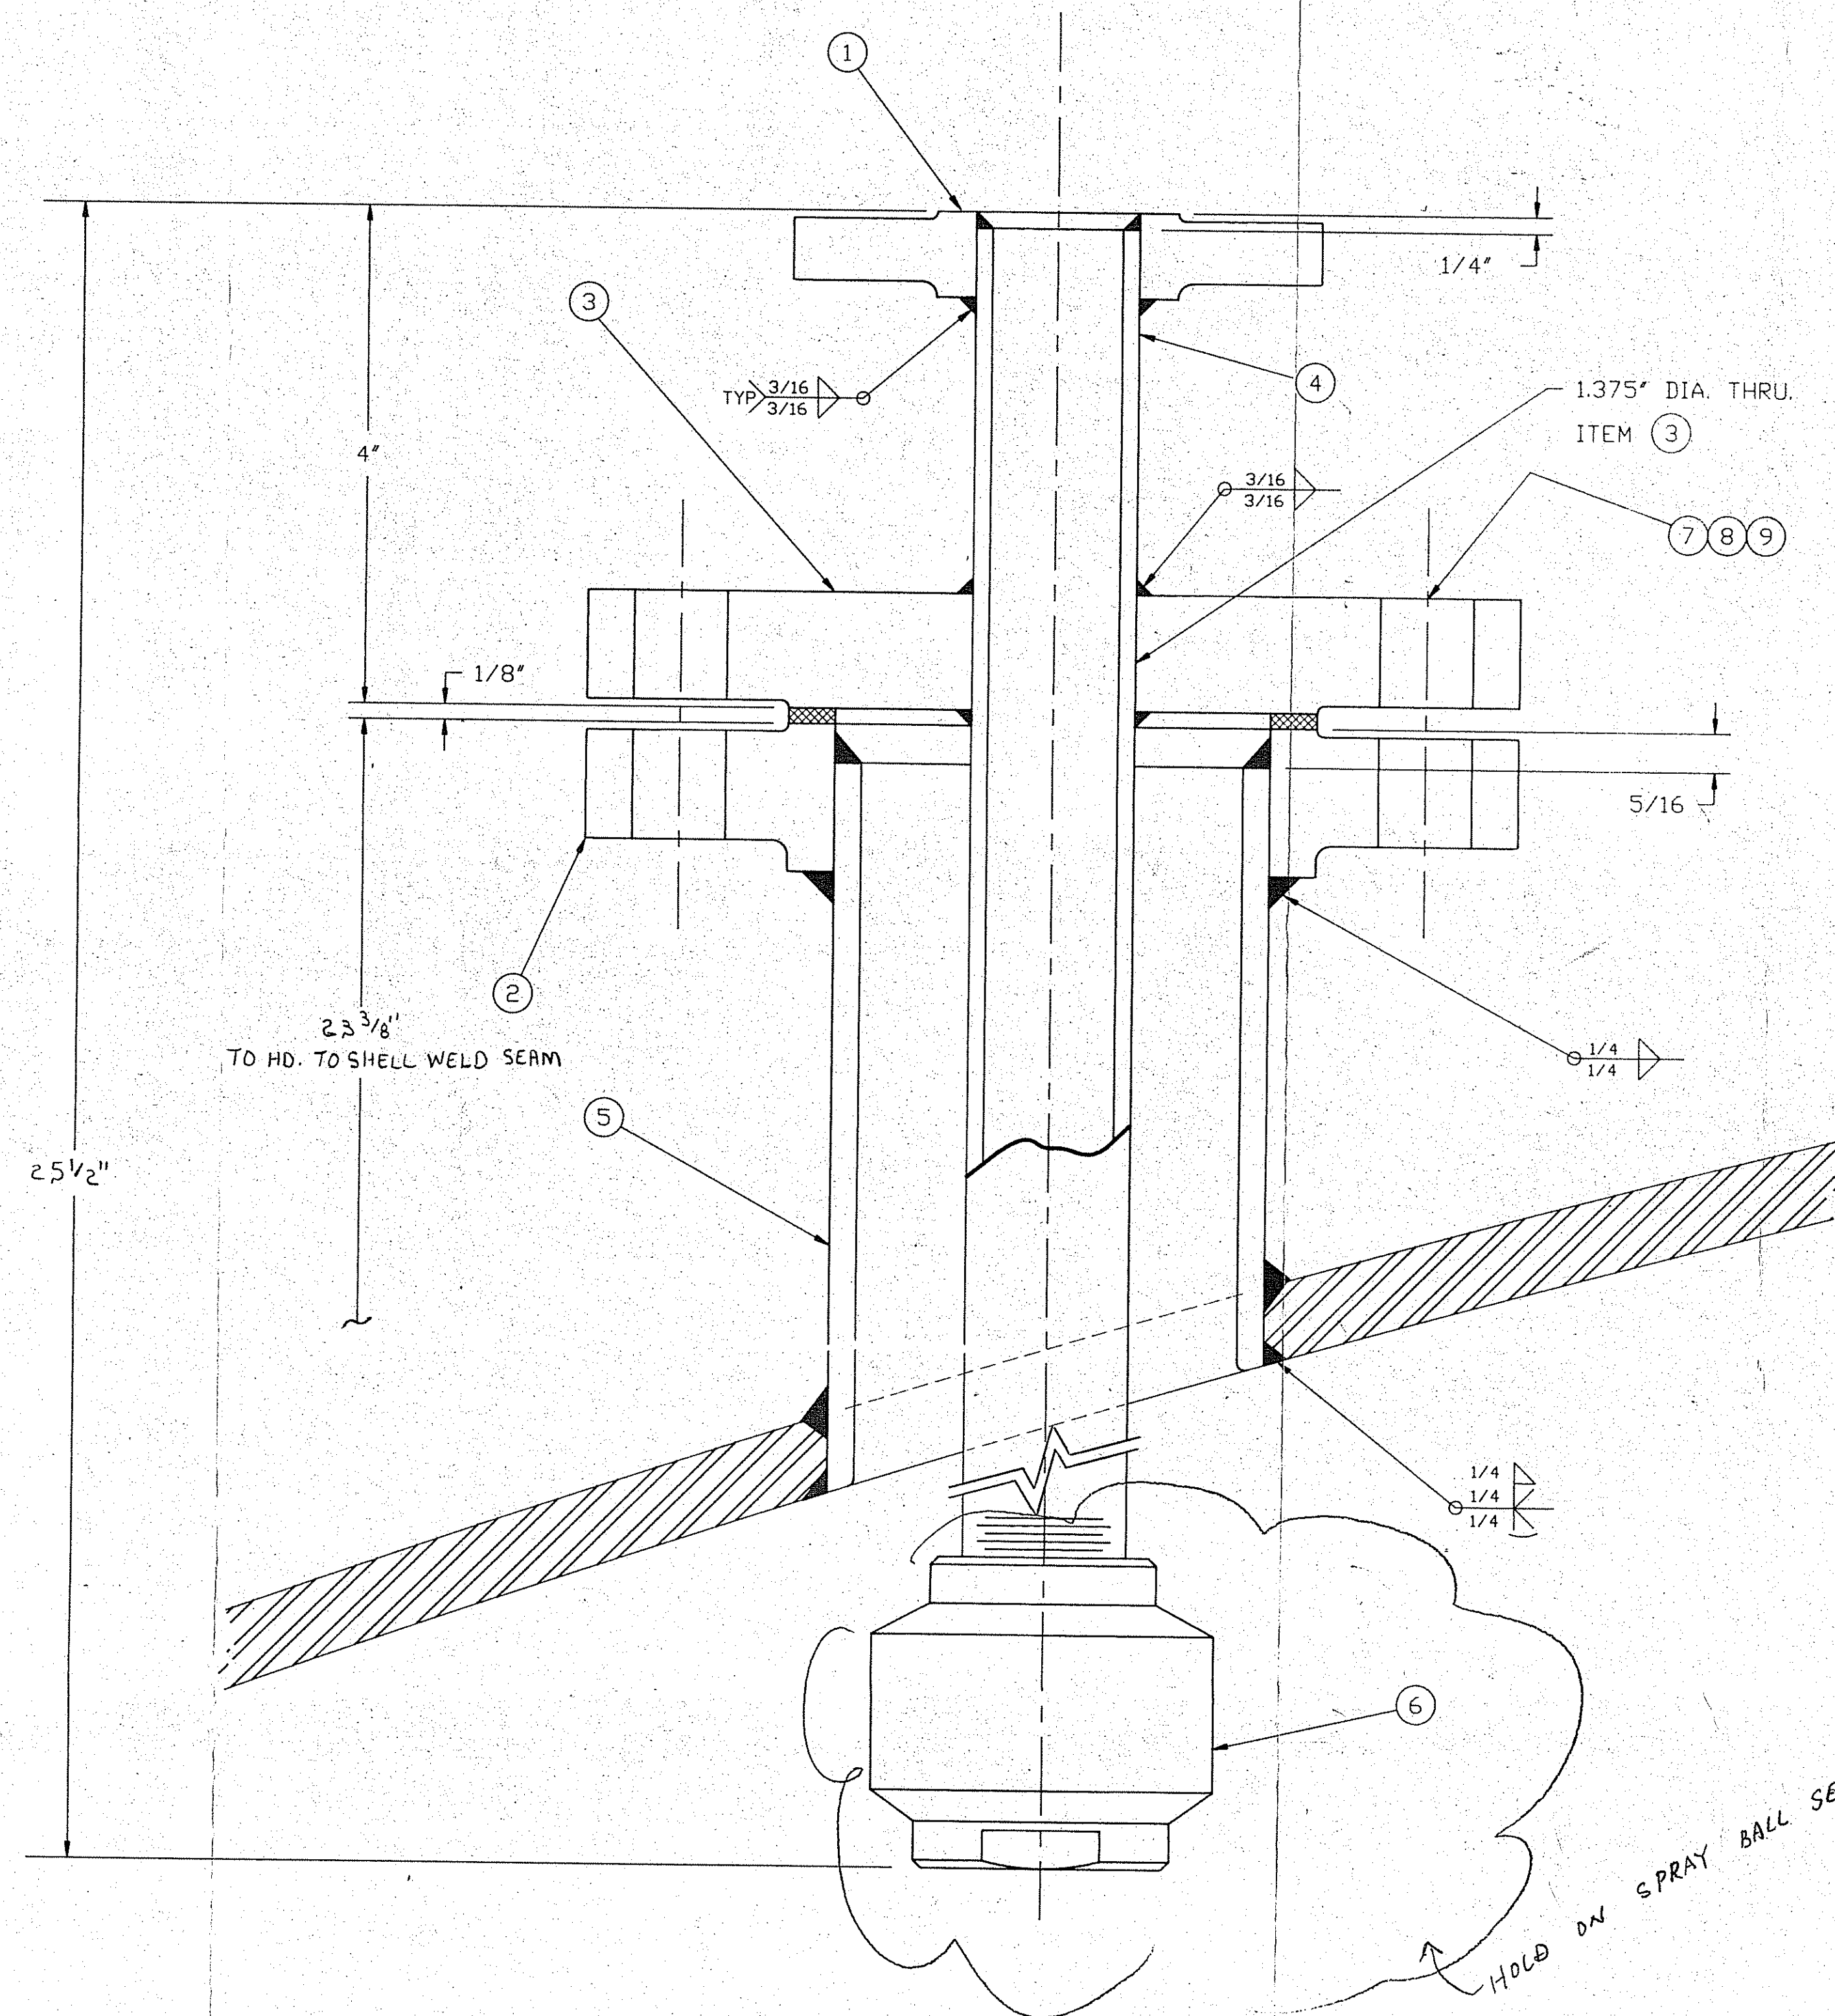

HOLD ON SPRAY BALL SELECTION UNTIL 3/6/91.



PRINT FOR APPROVAL
Clarence L. Camell
Customer Order No. 90-00001
Shop Order No. 90-EE-171
ROSENHARD
Charlotte, NC 28119

SIMONS-EASTERN CONSULTANTS, INC.		P. 5262A		001 OF 001	
SHIMIZU AMERICA CORP.		SOEIX CORPORATION		GASTON COUNTY DYEING MACHINE COMPANY	
RECEIVED	06 FEB 91	COPIES	3+	CHECK PRINTS	
P.O.	90-00001	FILE #	013	[] NO CORRECTIONS NOTED	
EQUIP #	C-5100			[] MAKE CORRECTIONS NOTED	
REVIEWED				[] REVISE AND RESUBMIT	
FOR GENERAL COMPLIANCE WITH THE DESIGN CONCEPT				[] REJECTED-SEE REMARKS	
OF THE PROJECT AND CONTRACT DOCUMENTS					
NO RESPONSIBILITY IS ASSUMED FOR CORRECTNESS					
OF DIMENSIONED DETAILS					
BY	J. K. K.	DATE	2/15/91	BY	
☐ NOT ACCEPTABLE NOT RELEASED FOR PRODUCTION REVISE AND RESUBMIT				DATE	
☐ SUBJECT TO PRODUCTION AND MODIFIED RELEASED FOR PRODUCTION SUBMIT					
☒ CERTIFIED DRAWING - RELEASED FOR PRODUCTION SUBMIT					
☐ NOT REQUIRED BY SHIMIZU FOR ENGINEERING DESIGN					


ITEM NO.	PART NO.	DRAWING NO.	MATERIAL OR DESCRIPTION	MATERIAL SPEC	MAT'L TYPE	QTY/PER UM
015						
014						
013						
012						
011						
010						
009	9103495		GASKET, 5-3/8" OD X 3-1/2" ID X 1/8" THK	TEFLON		1
008	0100352		NUT, HEX 5/8" NC	SA-194-GR8	304	8
007	0100031		STUD, THRD 5/8" NC X 3-3/4" LG	SA-193-B8	304	4
006	9125188		ROTARY TANK WASHING NOZZLE, SPRAYING SYSTEMS (*)	TEFLON		1
005	5233000		PIPE, 3" SCH 40 X 8' 3/8" LG	SA-312	304	150
004	5228000		PIPE, 1" SCH 40 X 2 3/4" LG	SA-312	304	2.00
003	0100458		FLANGE, BLIND 3" 150# ANSI	SA-182	304	1
002	0100508		FLANGE, RFSD 3" 150# ANSI	SA-182	304	1
001	0100503		FLANGE, RFSD 1" 150# ANSI	SA-182	304	1

REV.	DESCRIPTION	DATE	BY	CHECKED	APPROVED
G					
F					
E					
D					
C					
B					
A					

GASTON COUNTY FABRICATION		CUSTOMER ROSENHARD INC.	
A DIVISION OF GASTON COUNTY DYEING MACHINE COMPANY		CHARLOTTE, N.C. FOR SOEIX CORP.	
STANLEY, NORTH CAROLINA 28134-1165			
TITLE: SPRAY NOZZLE ASSY			
CUSTOMER P.O. NO.	1747	CUSTOMER ITEM NO.	C-5100
DRAWN BY G.M.	DATE 12-19-90	CHECKED BY	DATE 1-15-91
SHOP ORDER NO.	F-80816A	NO. REQUIRED	SHEET OF
SCALE 1" = 1"	REV.		

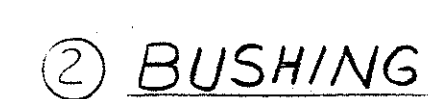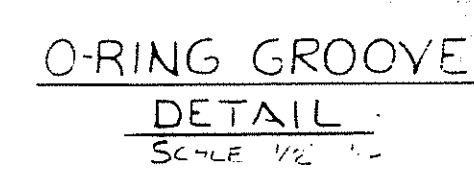

SHIMIZU AMERICA CORP.

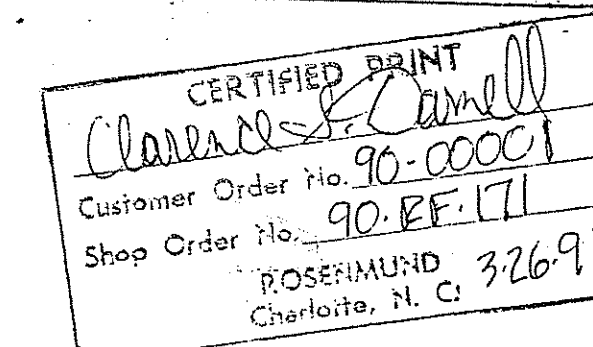

1. MILL TEST REPORTS REQ'D ON ITEM 1

ASME CODE

W. Medlin 12/10/90

GASTON COUNTY FABRICATION
A DIVISION OF GASTON COUNTY DYEING MACHINE COMPANY

RETURN TO VENDOR

CUSTOMER	ROSENMUND
----------	-----------

TITLE	TH'D SLEEVE
THERMOWELL ASS'Y	316L

CUSTOMER P.O. NO.		CUSTOMER ITEM NO.	
-------------------	--	-------------------	--

DRAWN BY R D DAVIS DATE 15 OCT 90 CHECKED BY [signature] DATE 10/18/90

SHOP ORDER NO.	NG REQUIRED	SHEET
----------------	-------------	-------

SCALE	REV.
-------	------

SEARCHED ☒ INDEXED ☒
SERIALIZED ☒ FILED ☒
MAY 1964
FBI - NEW YORK
No. E-36005H

02-190 20

PC-V-142

BILL OF MATERIAL				
ITEM	QTY	MFR	CAT. NO.	DESCRIPTION
1	34	SQUARE D	9080GR6	TERMINAL BLOCK
2	5	SQUARE D	9001SKPIR31	PILOT LIGHT - RED
3	3	SQUARE D	9001SKPIG31	PILOT LIGHT - GREEN
4	1	SQUARE D	9001SKR9RH147	PUSH - PULL SWITCH
5	1	SQUARE D	9001SKRIBH126	MOMENTARY PUSHBUTTON
6	5	SQUARE D	9001SKS53FBH128	3 POS. SEL. SW. RET. TO CTR.
7	1	SQUARE D	9001SKS43FBH128	3 POS. SEL. SW. MAINT. POS.

1. NUMBERS IN PARENTHESES REFER TO ITEM NO. IN BOM.
2. BOM COVERS DEVICES IN THE LOCAL AND AGITATOR CONTROL PANEL. DEVICES MOUNTED ON THE FILTER AND IN THE HYDRAULIC PACKS ARE NOT INCLUDED.

	TERMINAL ON LCP
	TERMINAL ON ACP
	TERMINAL ON AUX. HYDRAULIC PACK
	TERMINAL ON FILTER OR CUST. — SUPPLIED DEVICE
	CONNECTION TO ANOTHER POINT ON DRAWING. NOT A TERMINAL DESIGNATION
	INTERCONNECT WIRING BY CUSTOMER
	N.O. LIMIT SWITCH
	3—POSITION SELECTOR SWITCH
	2—POSITION SELECTOR SWITCH
	PUSHBUTTON SWITCH MOMENTARY CONTACT N.O.
	N.C. PUSH—PULL SWITCH MAINTAINED CONTACT
	PROXIMITY SENSOR
	PRESSURE SWITCH — OPEN ON INC. PRESSURE
	PRESSURE SWITCH — CLOSE ON INC. PRESSURE
	RELAY OR MISC. CONTACT N.O.
	RELAY OR MISC. CONTACT N.C.
	RELAY OR STARTER COIL
	SOLENOID VALVE
	LED CLUSTER LAMP R — RED Y — YELLOW G — GREEN
	FUSE
	INDICATOR LAMP (INCANDESCENT) R — RED Y — YELLOW G — GREEN

CERTIFIED PRINT
RSP
Customer Order No. 94-00001
Shop Order No. 94-RF-171
ROSENMUND
Charlotte, N. C.




	A	FOR APPROVAL	4/9/91	RSB
SOFIX P.D. #90-00001	No.	REVISION	Date	Approv.

Scale	Drawn	C/CAD	
NTS	Checked	ESB	




DWG. No. 90-RF-171-K1

A B C D E F G H

LOCAL CONTROL PANEL

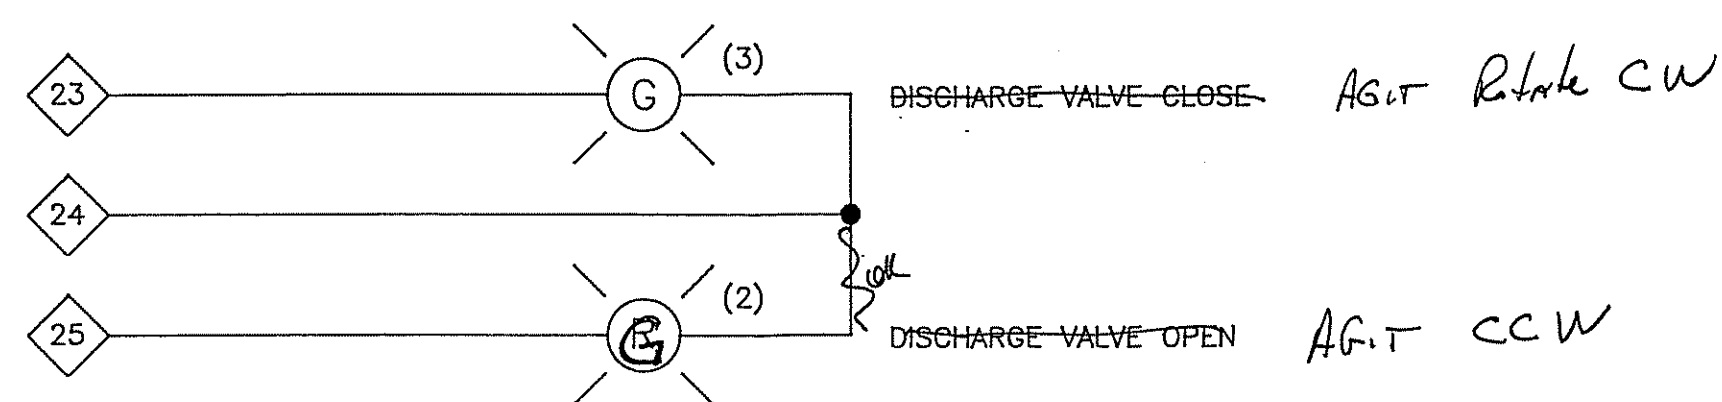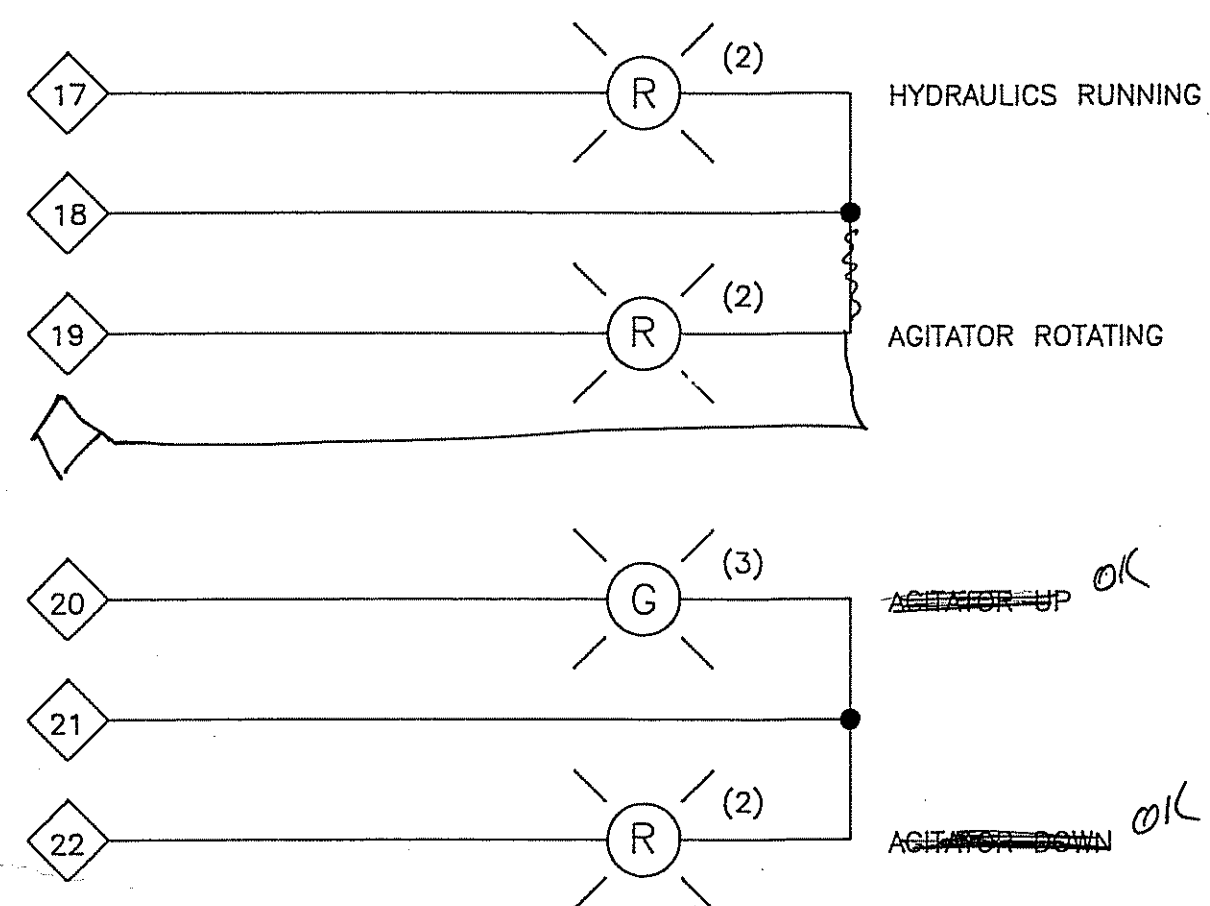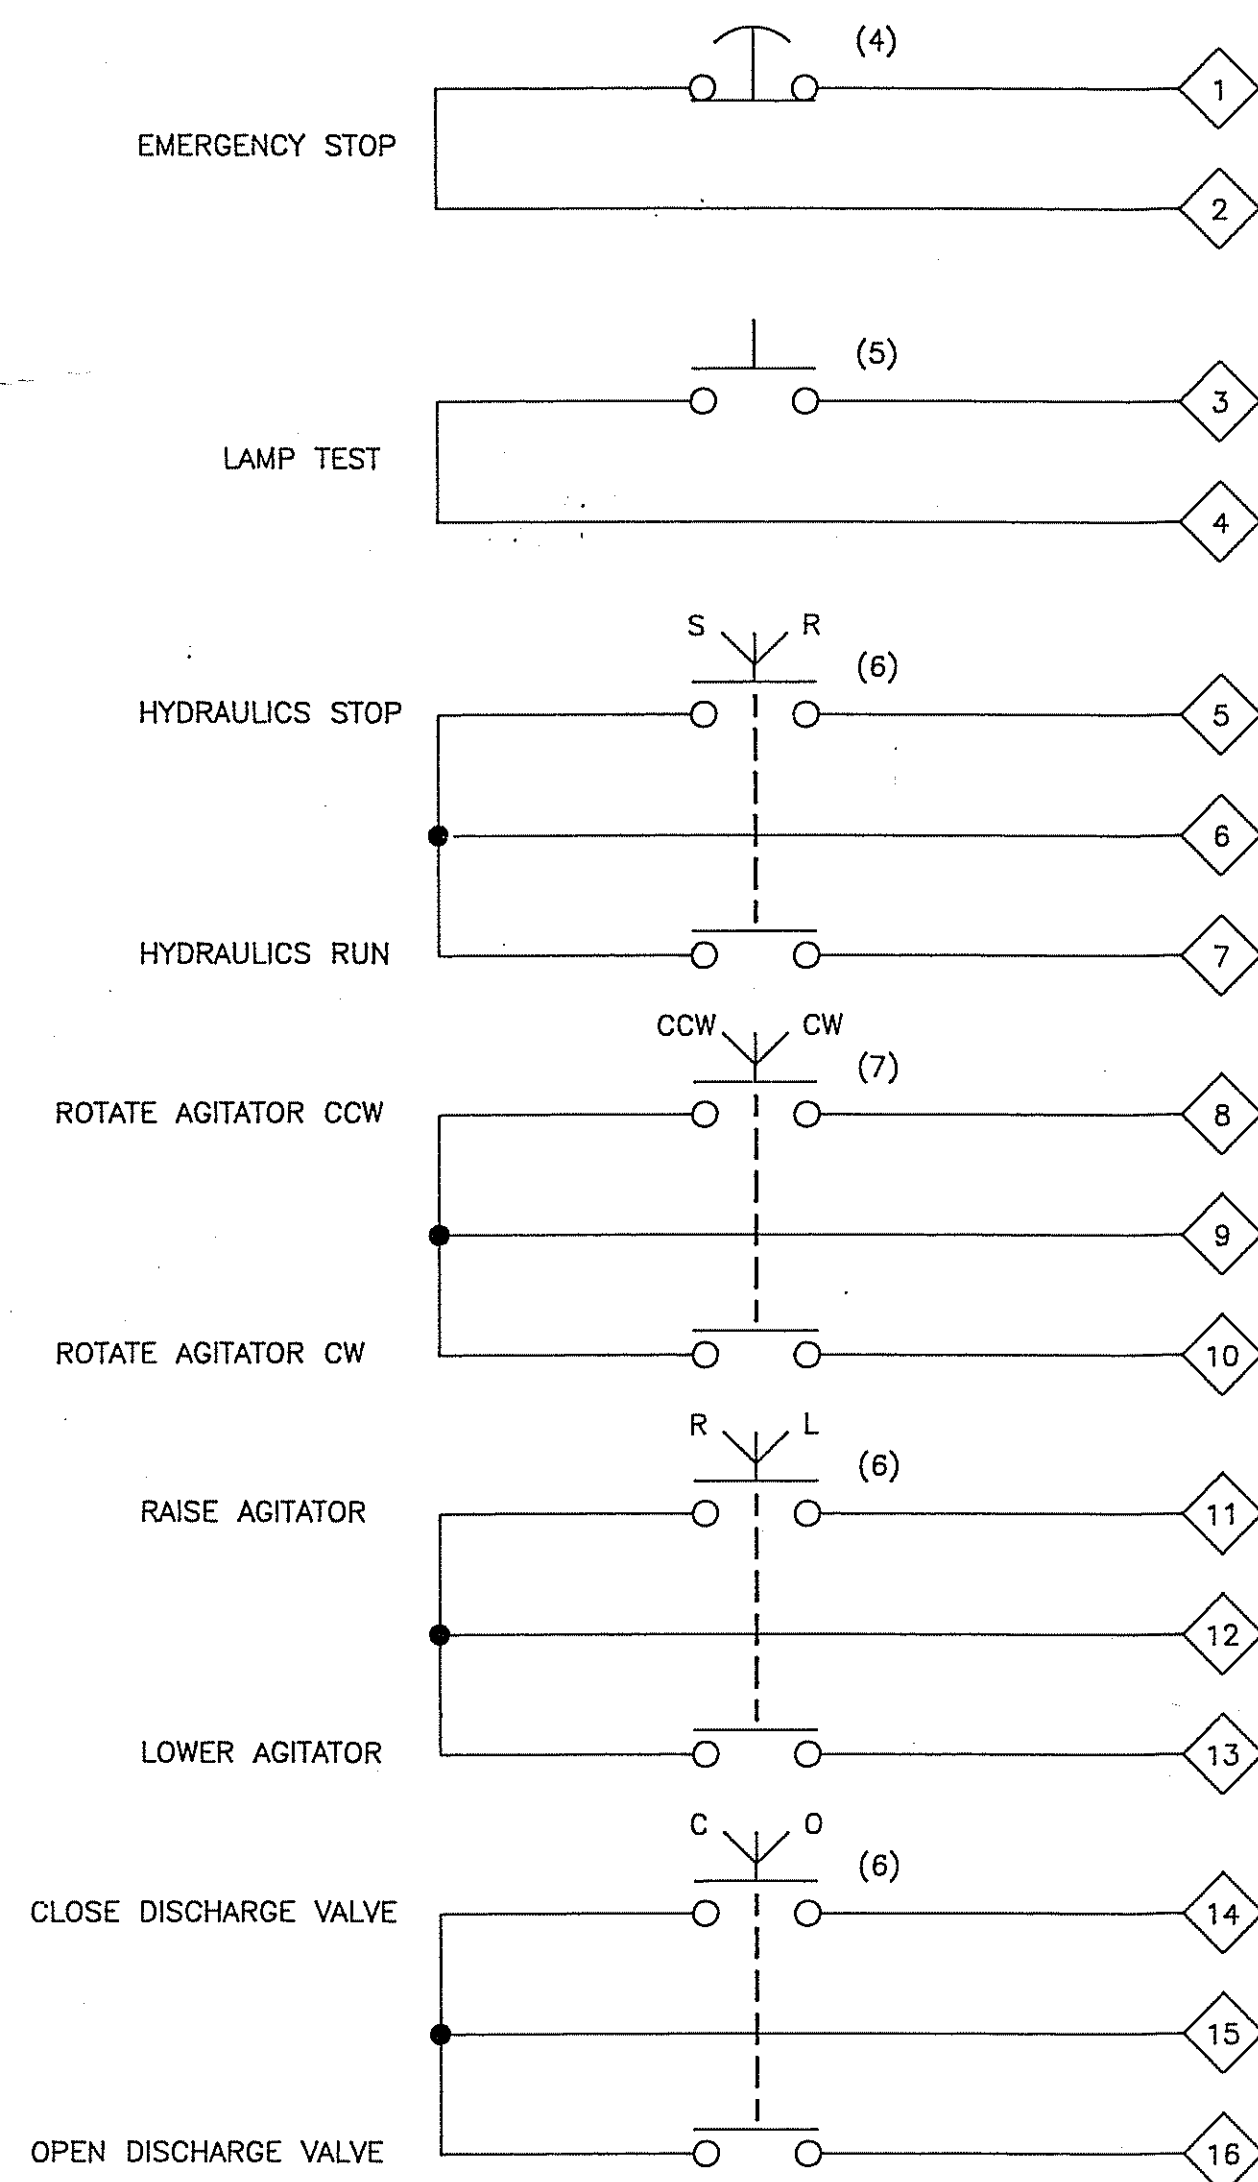

AGITATOR CONTROL PANEL

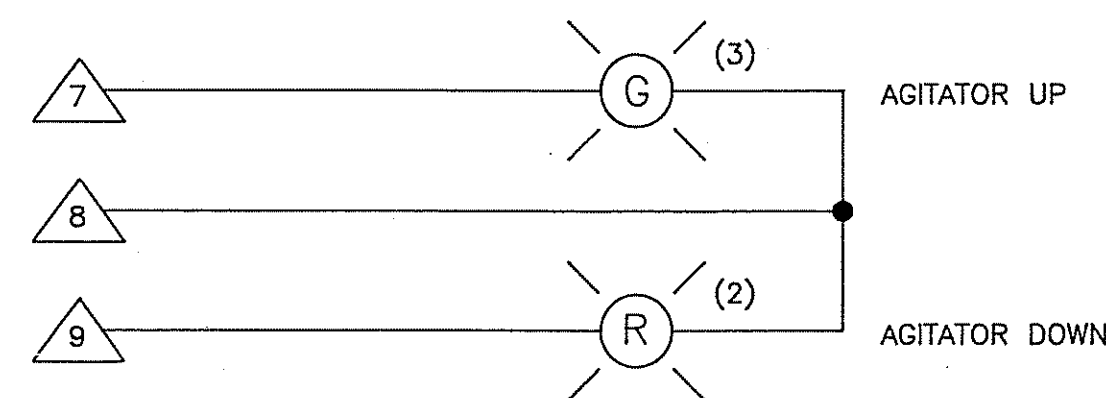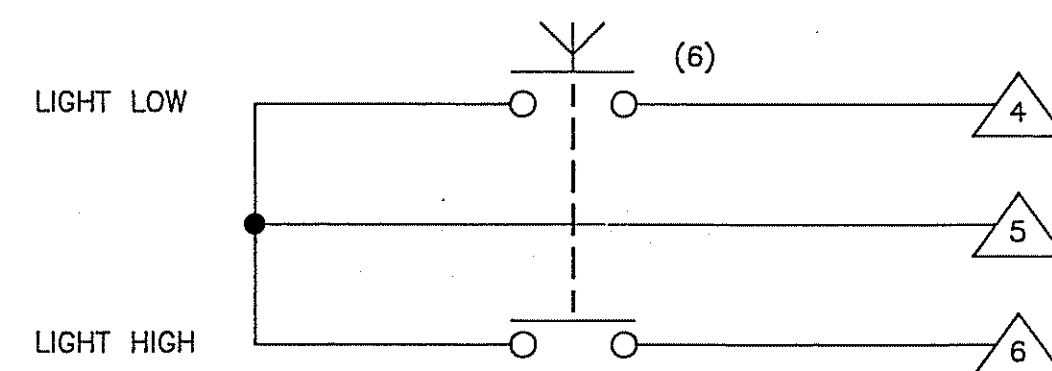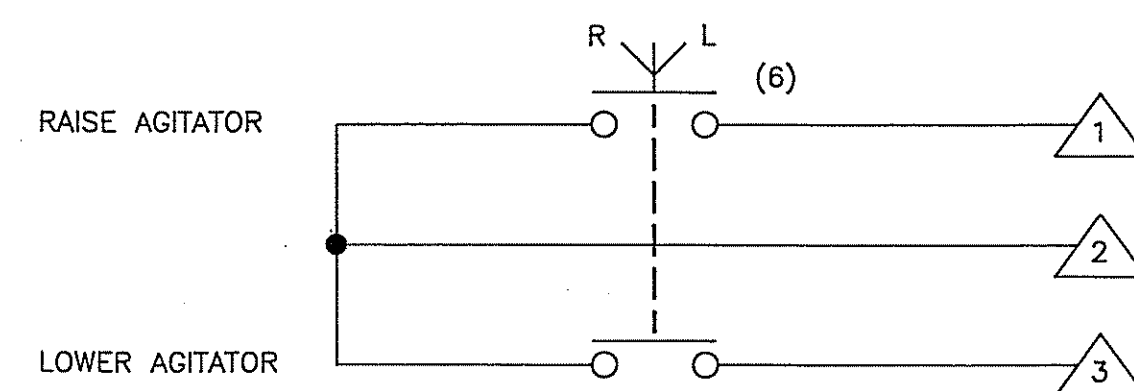

NOTE:

1. NUMBERS IN PARENTHESES REFER TO ITEM NO. IN BILL OF MATERIALS.

RECEIVED
AUG 02 1991
H. L. WILLIAMS

CERTIFIED PRINT
Customer Order No. 90-00001
Shop Order No. 90-RF-171
ROSENMUND
Charlotte, N. C.

The copyright for this drawing remains Rosenmund's. The use of this drawing is strictly limited to the purposes we have agreed to in writing. It may neither be reproduced nor copied nor brought to any third party's notice without our written consent.


SOFIX P.D. #90-00001

0	CERTIFIED FOR FABRICATION	7/31/91	RSB
A	FOR APPROVAL	4/9/91	RSB
No.	REVISION	Date	Approv.


ROSENMUND INC. 2969 INTERSTATE STREET P.O. BOX 668625
CHEMICAL PROCESS EQUIPMENT CHARLOTTE, N.C. 28266-8625

SOFIX CORPORATION
SCHEMATICS AND PANEL DRAWINGS

Scale NTS
Drawn C/CAD
Checked ESB
DWG. No. 90-RF-171-K2

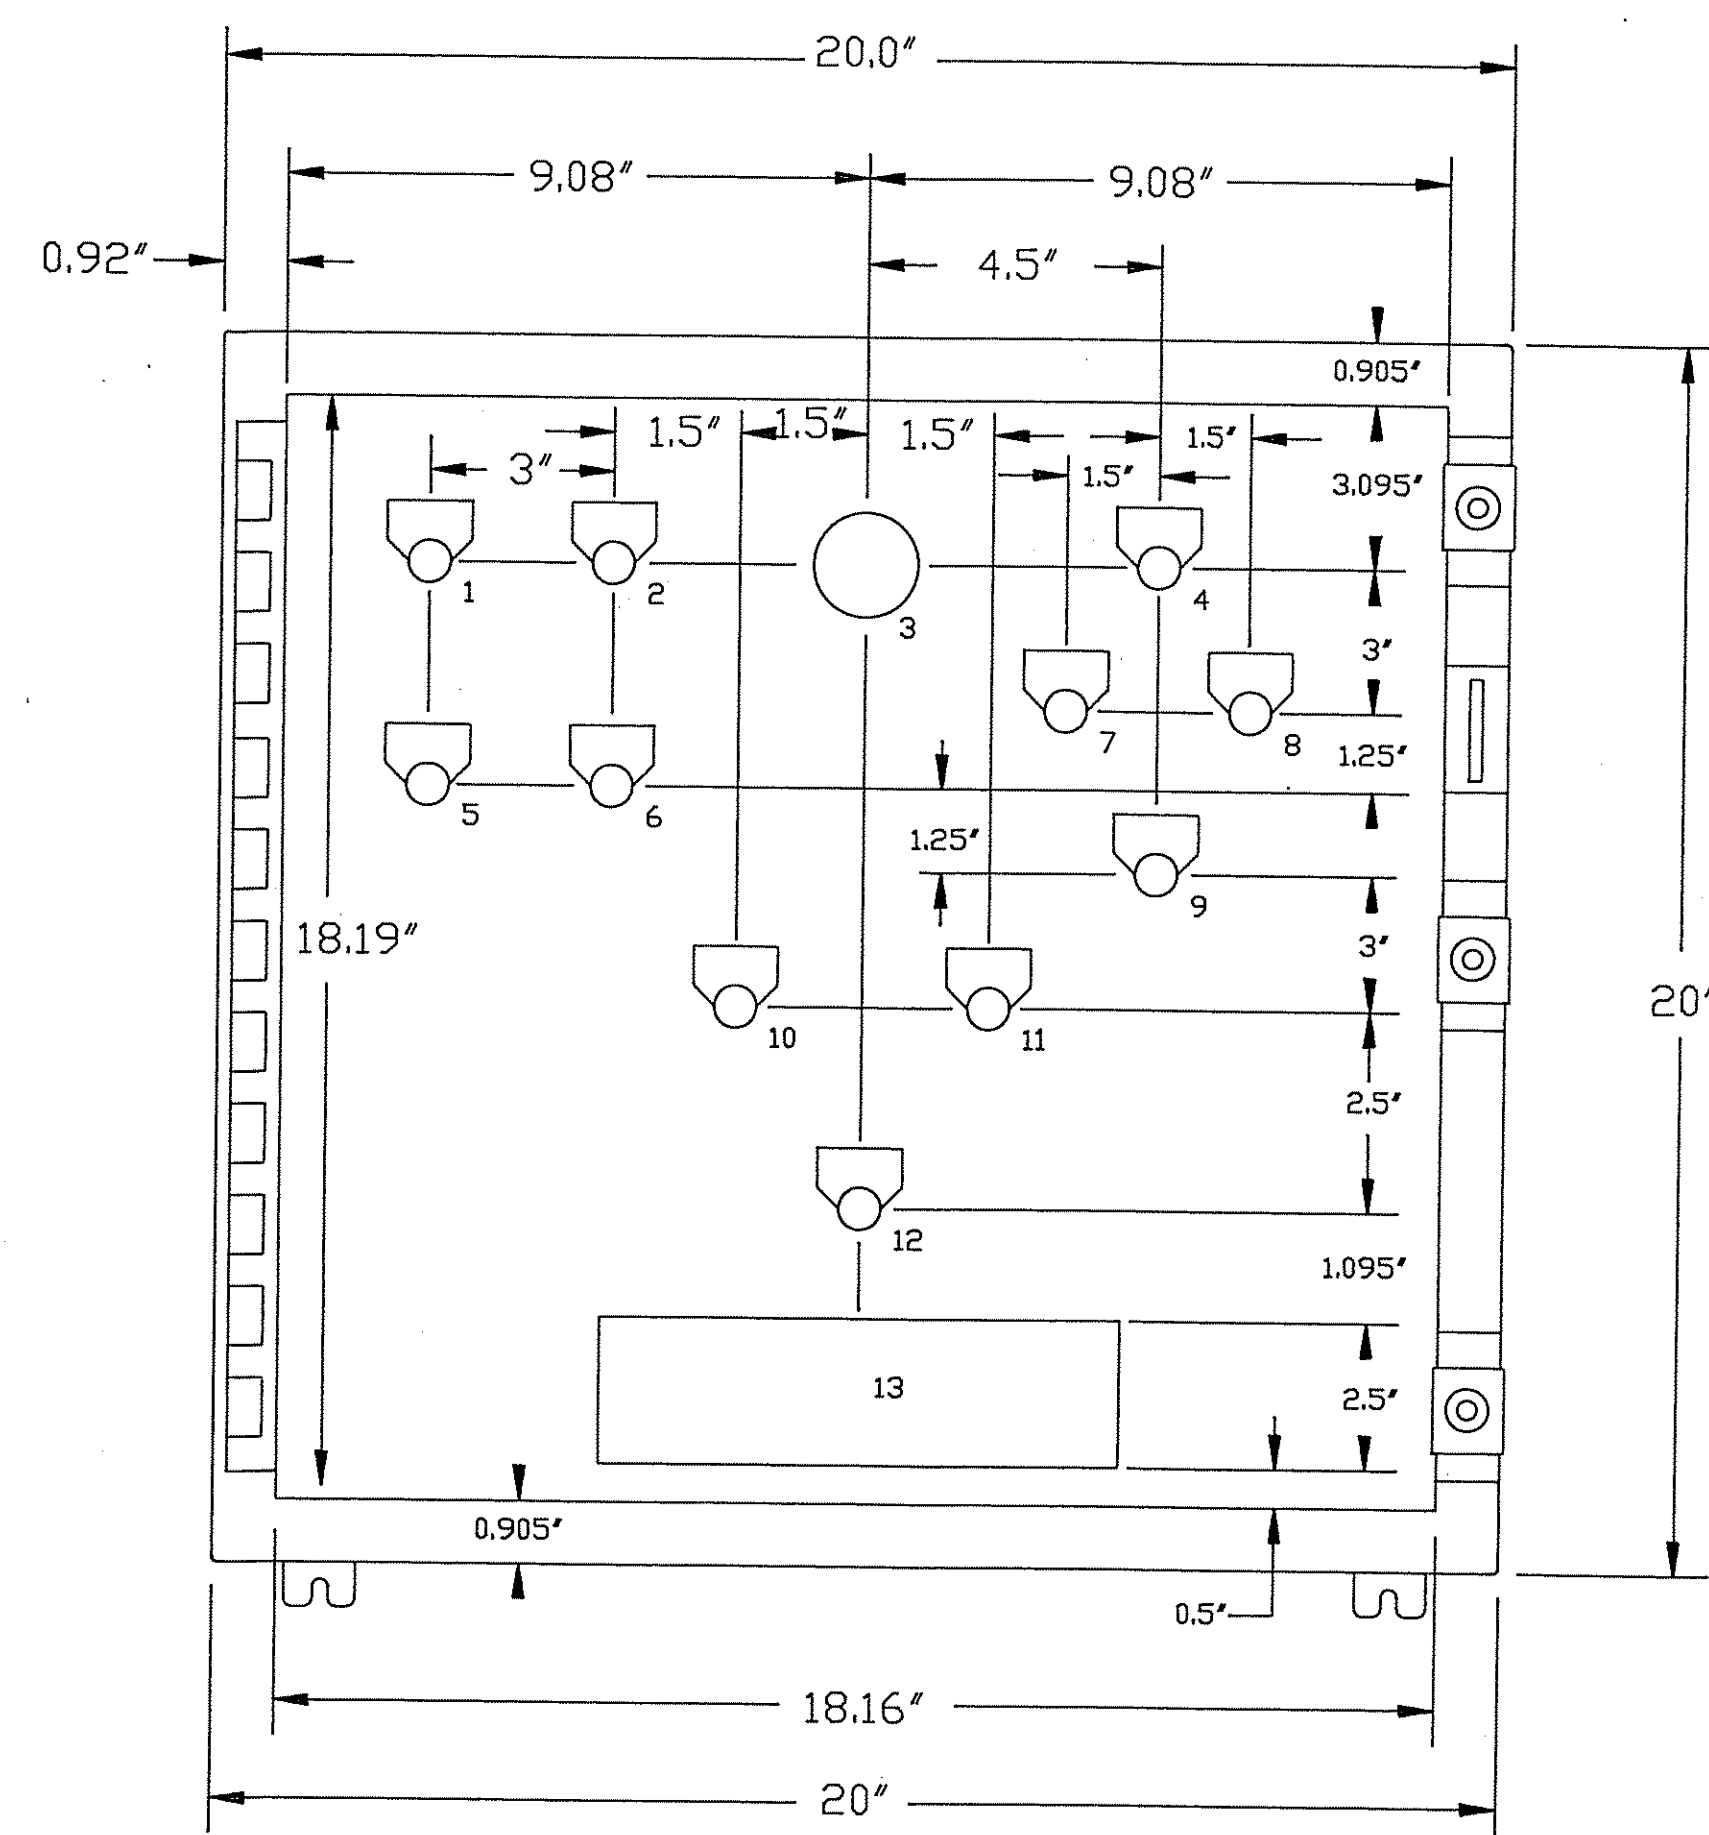

LOCAL CONTROL PANEL
INTERIOR MOUNTING PANEL
17" H. X 17" W.

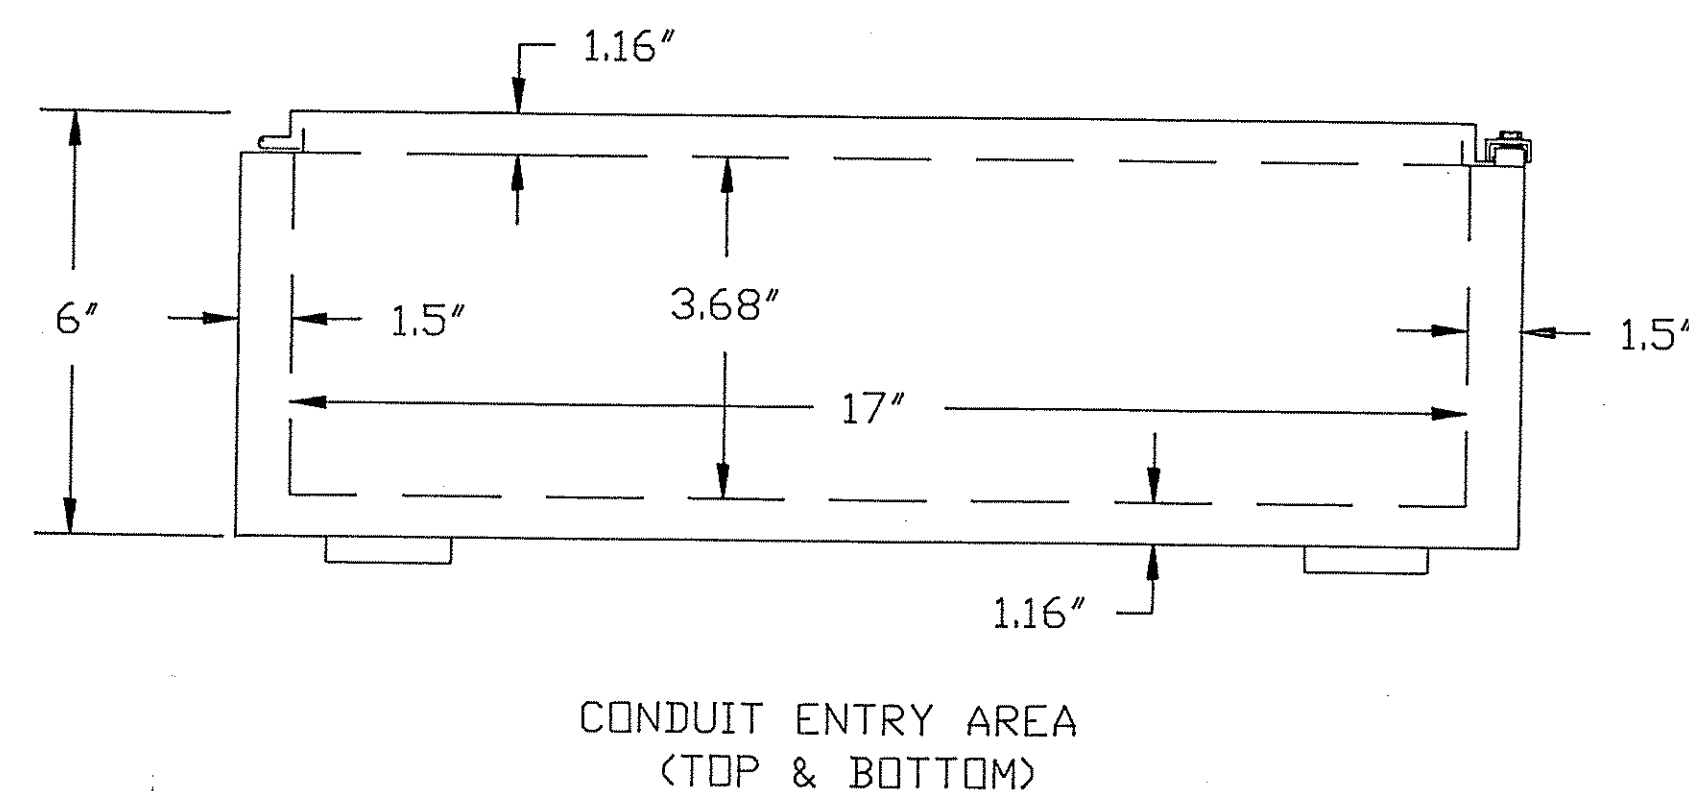

CONDUIT ENTRY AREA
(TOP & BOTTOM)

NOTE:
ENCLOSURE SIZE 20" X 20" X 6"
PANEL BACKPLATE - 17" X 17"
NEMA 4X, 304 STAINLESS STEEL

LEGEND

- 3 POS. SEL. SW. (6) N/P ENGRAVING: 'HYDRAULICS / STOP-RUN'
- RED LIGHT (2) ENGRAVING: 'HYDRAULICS RUNNING'
- PUSH - PULL SWITCH (4) N/P ENGRAVING: 'EMERGENCY STOP'
- MOMENTARY PUSHBUTTON (5) N/P ENGRAVING: 'LAMP TEST'
- 3 POS. SEL. SW. (7) N/P ENGRAVING: 'AGITATOR ROTATION / CCW-STOP-CW'
- RED LIGHT (2) N/P ENGRAVING: 'AGITATOR ROTATING'
- GREEN LIGHT (3) N/P ENGRAVING: 'UP'
- RED LIGHT (2) N/P ENGRAVING: 'DOWN'
- 3 POS. SEL. SW. (6) N/P ENGRAVING: 'AGITATOR POSITION / UP-STOP-DOWN'
- GREEN LIGHT (3) N/P ENGRAVING: 'CLOSE'
- RED LIGHT (2) N/P ENGRAVING: 'OPEN'
- 3 POS. SEL. SW. (6) N/P ENGRAVING: 'DISCHARGE VALVE'
- 6.5' X 2.5' ROSENMUND NAMEPLATE

NOTES:

- (1) NUMBERS IN PARENTHESES REFERS TO ITEMS IN BILL OF MATERIAL

RECEIVED
AUG 02 1991
H. L. WILLIAMS

CERTIFIED PRINT
Customer Order No. 90-00001
Shop Order No. 90-RC-171
ROSENMUND
Charlotte, N. C.

The copyright for this drawing remains Rosenmund's. The use of this drawing is strictly limited to the purposes we have agreed to in writing. It may neither be reproduced nor copied nor brought to any third party's notice without our written consent.


SOFIX P.O. # 90-00001

No.	REVISION	Date	Apprv.
0	CERTIFIED FOR FABRICATION	7/31/91	RSB
A	FOR APPROVAL	4/9/91	RSB


ROSENMUND INC. 2969 INTERSTATE STREET P.O. BOX 668625
CHEMICAL PROCESS EQUIPMENT CHARLOTTE, N.C. 28266-8625

SOFIX CORPORATION
LOCAL CONTROL PANEL LAYOUT

Scale NTS
Drawn C/CAD
Checked RS/3
DWG. No. 90-RF-171-K3

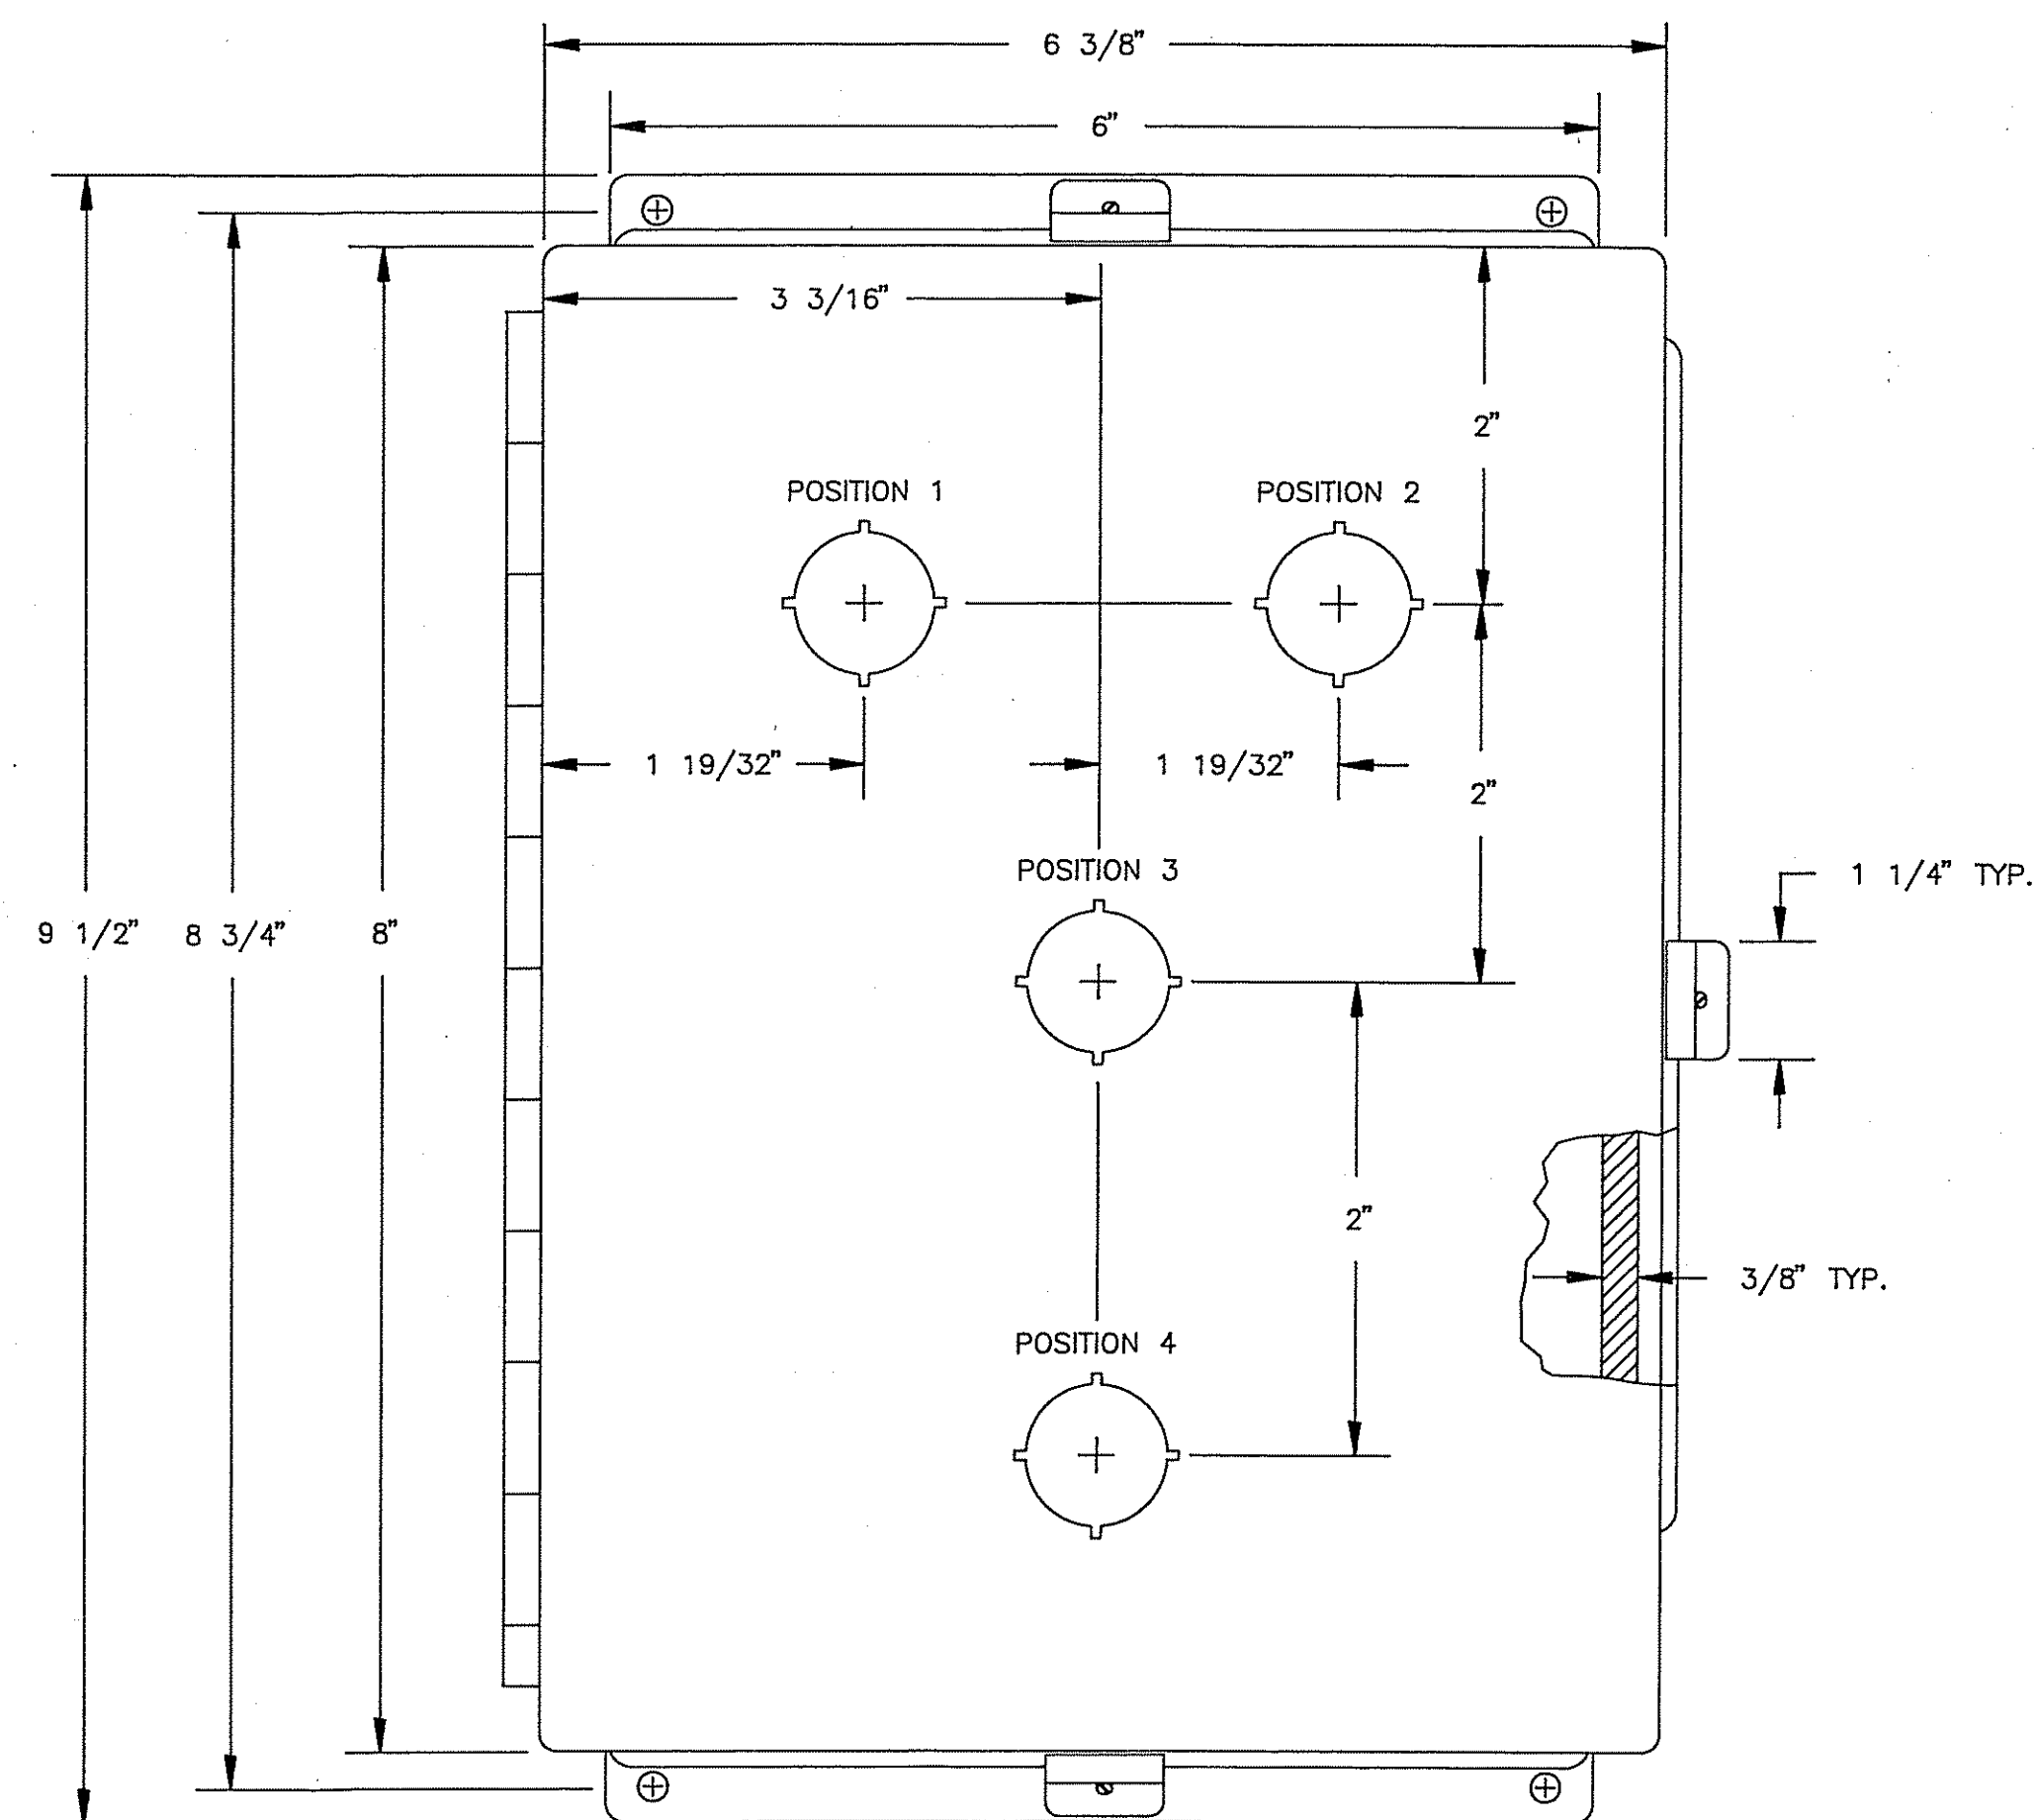

AGITATOR CONTROL PANEL LAYOUT

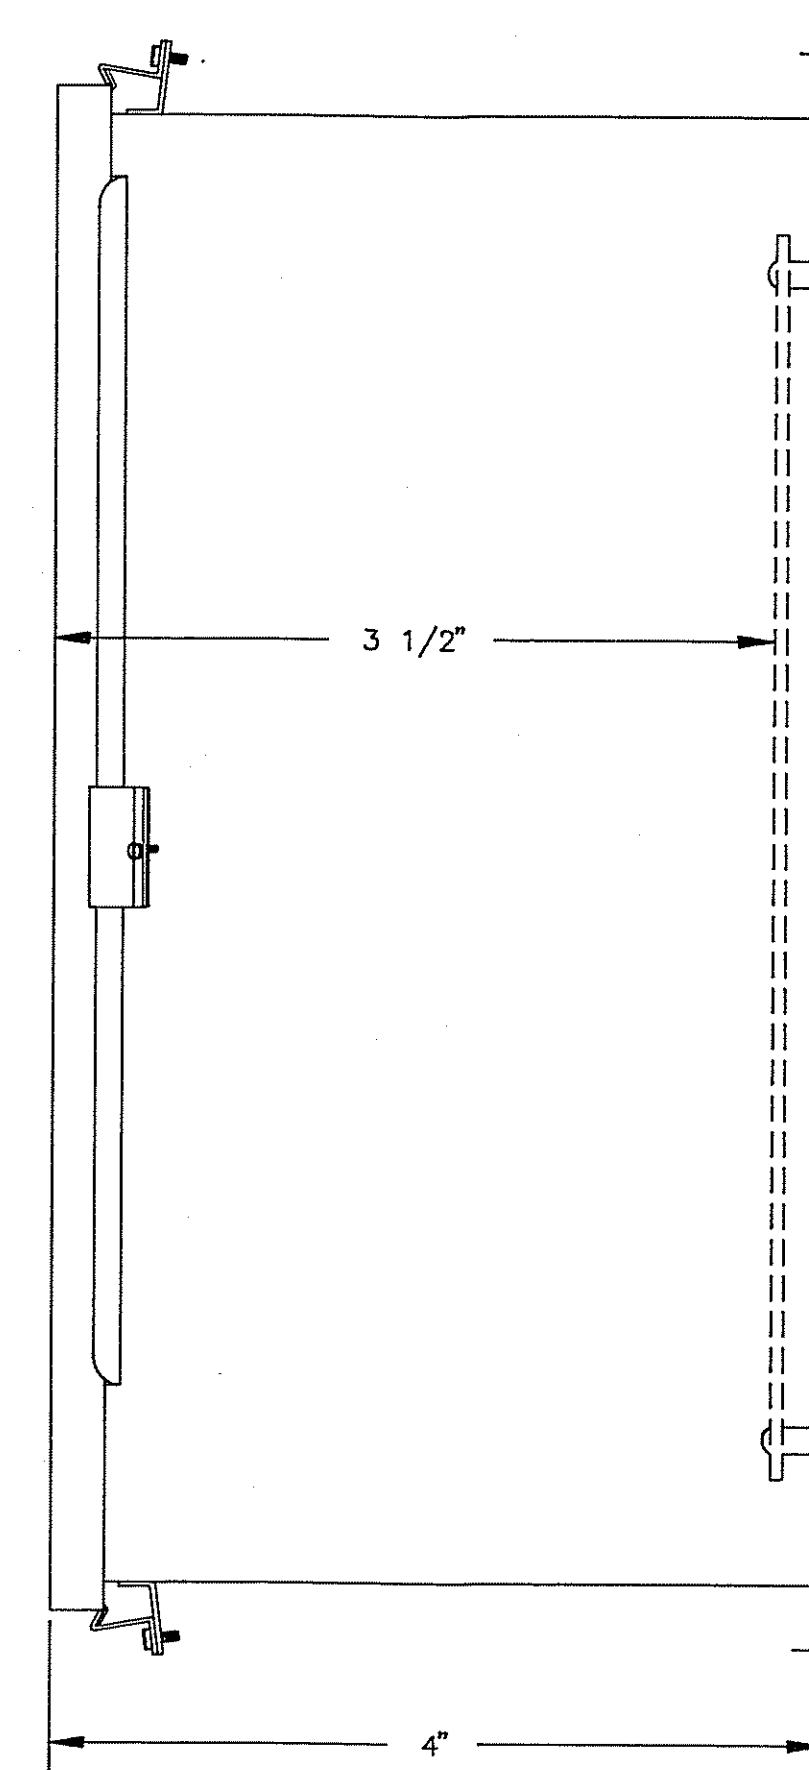

LEGEND

- CONSTRUCTION NEMA 4X, 304 STAINLESS.
- POSITIONS 1 THROUGH 4:
POS. 1 - GREEN LIGHT (3), N/P ENGRAVING "UP"
POS. 2 - RED LIGHT (2), N/P ENGRAVING "DOWN"
POS. 3 - 3-POS. SELECTOR SWITCH (6), N/P ENGRAVING "AGITATOR POSITION/UP-STOP-DOWN"
POS. 4 - 3-POS. SELECTOR SWITCH (6), N/P ENGRAVING "LIGHT/LO-HI"

NOTES:

- (1) NUMBERS IN PARENTHESES REFERS TO ITEMS IN BILL OF MATERIAL.

RECEIVED

AUG 02 1991

H. L. WILLIAMS

CERTIFIED PRINT
RSB
Customer Order No. 90-00001
Shop Order No. 90-RF-171
ROSENMUND
Charlotte, N. C.

The copyright for this drawing remains Rosenmund's. The use of this drawing is strictly limited to the purposes we have agreed to in writing. It may neither be reproduced nor copied nor brought to any third party's notice without our written consent.

SDFIX P.O. #90-00001


0	CERTIFIED FOR FABRICATION				
A	FOR APPROVAL	4/9/91	RSB		
No.	REVISION	Date	Approv.		

ROSENMUND INC. 2969 INTERSTATE STREET P.O. BOX 668625
CHEMICAL PROCESS EQUIPMENT CHARLOTTE, N.C. 28266-8625

SOFIX CORPORATION

AGITATOR CONTROL PANEL LAYOUT

Scale	Drawn	C/CAD
NTS	Checked	
DWG. No.	90-RF-171-K4	

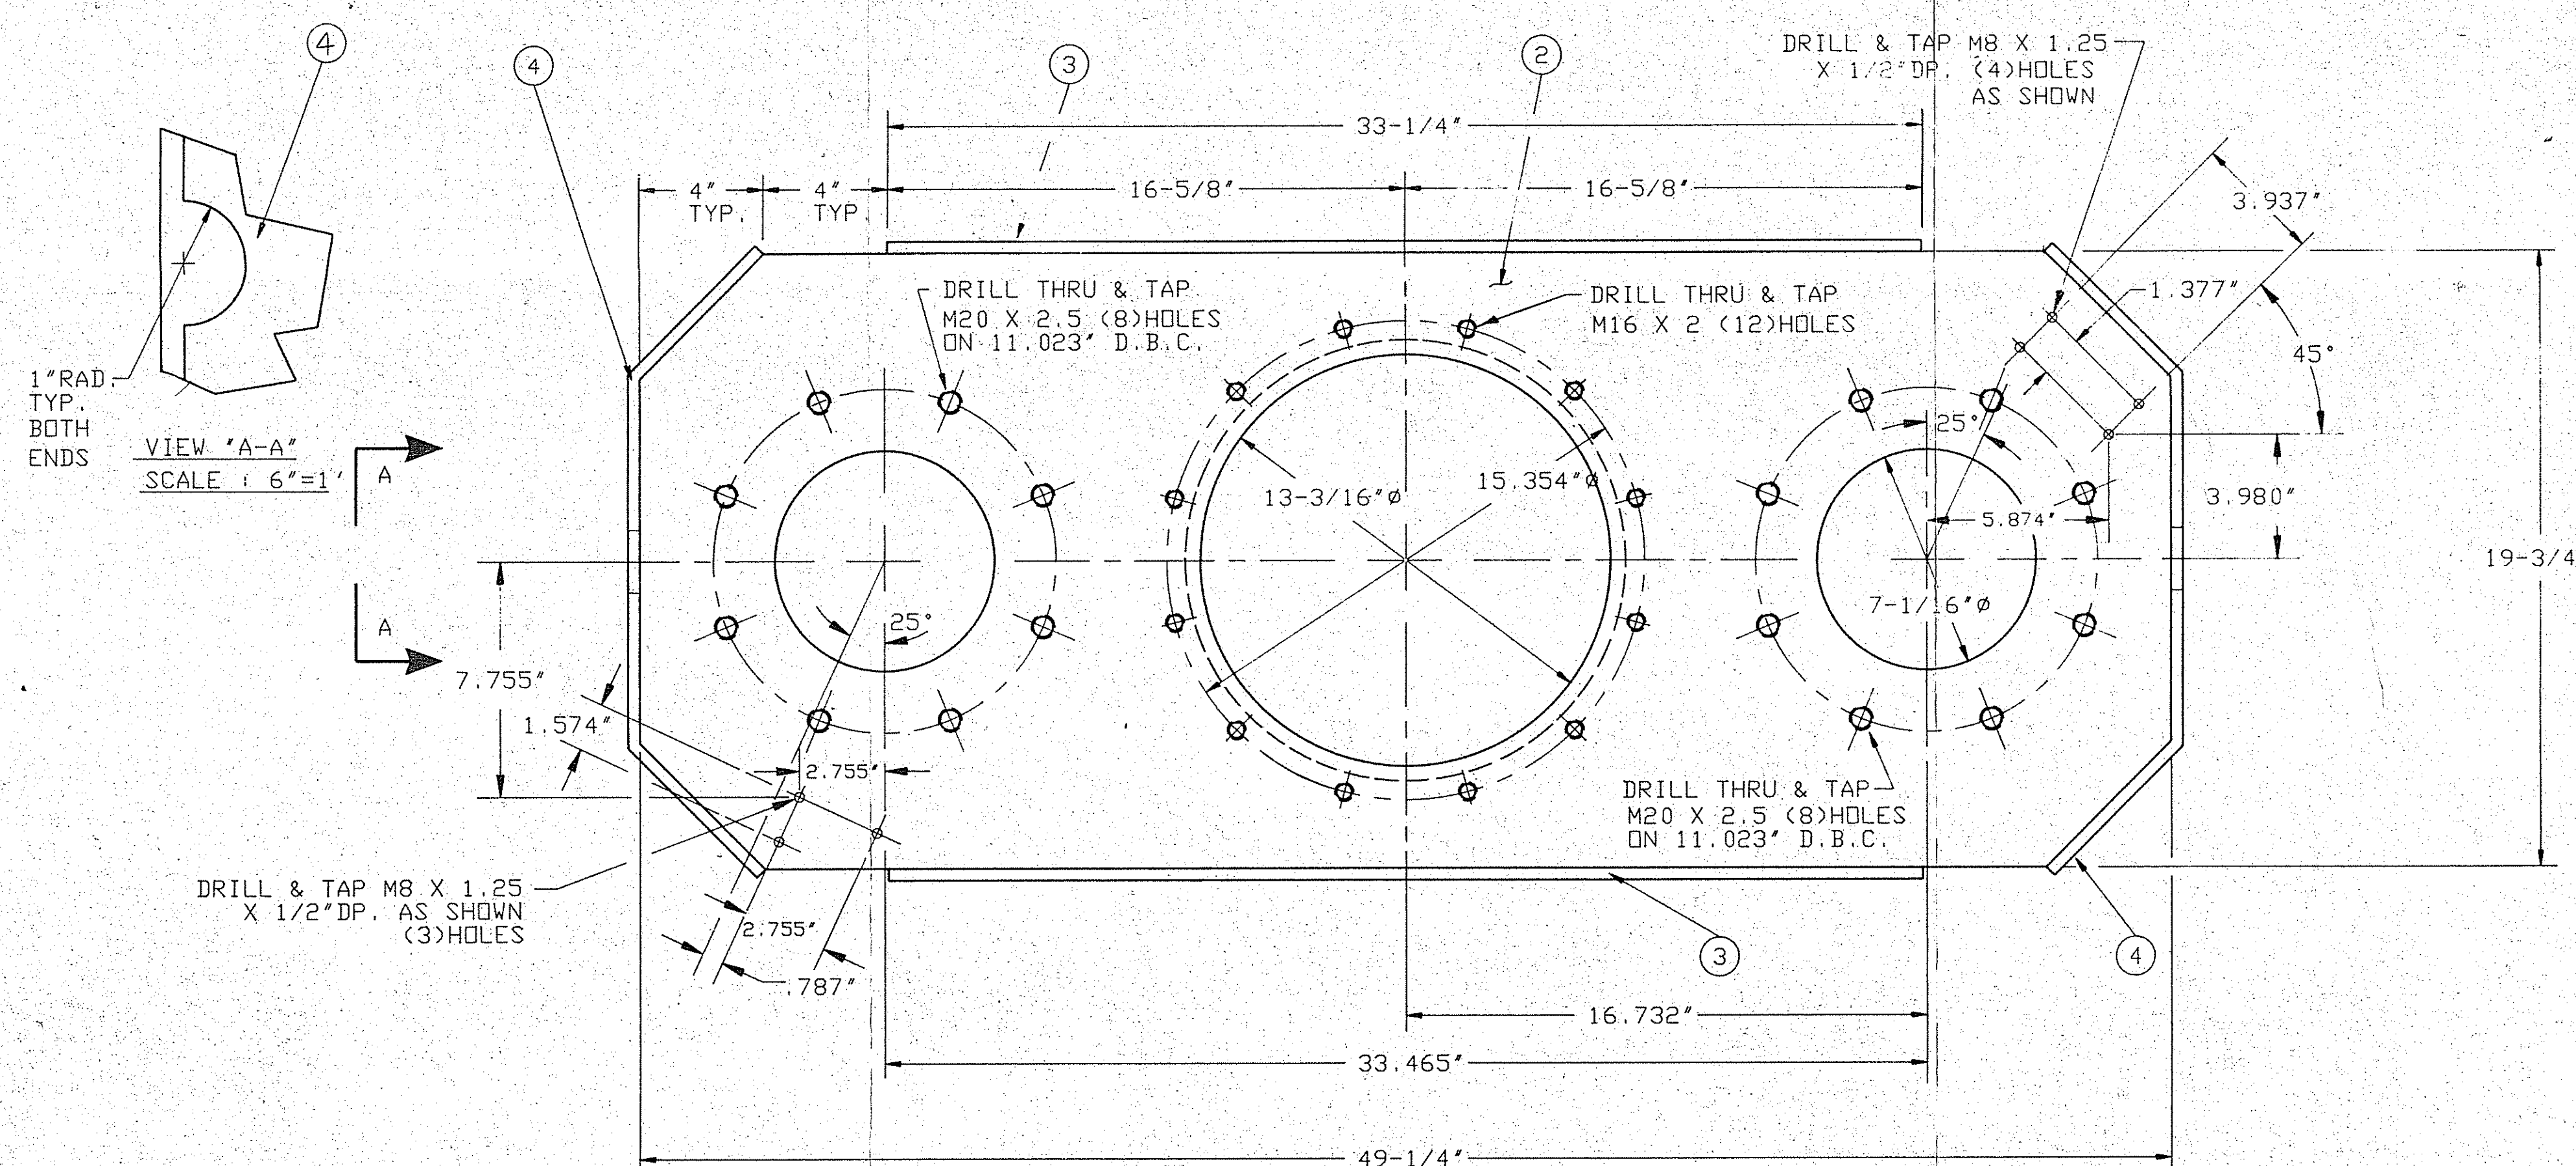









PRINT FOR APPROVAL
Clarence S. Samuel
 Customer Order No. 90.00001
 Shop Order No. 90.PF.171
 ROSENMUND
 Charlotte, NC 21.91

ASME CODE	
APPROVAL	DATE
APPROVAL	DATE

SIMONS-NESTOR CONSULTANTS, INC.
 P. 5325A
 E-3600597 001 UF 001
 SHINTZU AMERICA CORP.
 SDEX CORPORATION
 RECEIVED OCTOBER 1 COPIES 3+1
 RG 90-00001 FILED 01
 EQUIP# C-5100
 REVIEWED:
 FOR GENERAL CONSTRUCTION AND DESIGN CONCEPT
 OF THE PROJECT AND CONTRACT DOCUMENTS
 (SPECIFICATIONS & ASSUMPTIONS) FOR THE PROJECT
 (SEE ATTACHED FOR DETAILS)
 BY DATE 2/15/81
☐ NOT ACCEPTABLE (ALL RELEASES FOR PRODUCTION) AND RESUME
☐ SUBJECT TO REVISIONS AS INDICATED (RELEASED FOR PRODUCTION) AFTER
 REVISIONS
☐ NO EXCEPTION TAKEN - RELEASED FOR PRODUCTION - (CERT. SUFFICIENT)
☐ CERTIFIED DRAWING ADAPTED - RELEASED FOR PRODUCTION
 (NO REVISIONS BY ARCHITECT FOR PROGRESSIVE SETTING)

GASTON COUNTY DYED MACHINE CO
CHECK REMITS
MAY 25 1961 PM 7.5
[1] NO CORRECTIONS NOTED
[1] MAKE CORRECTIONS NOTED
[1] REVISE AND RESUBMIT
[1] REJECTED-SEE REMARKS

[illegible]

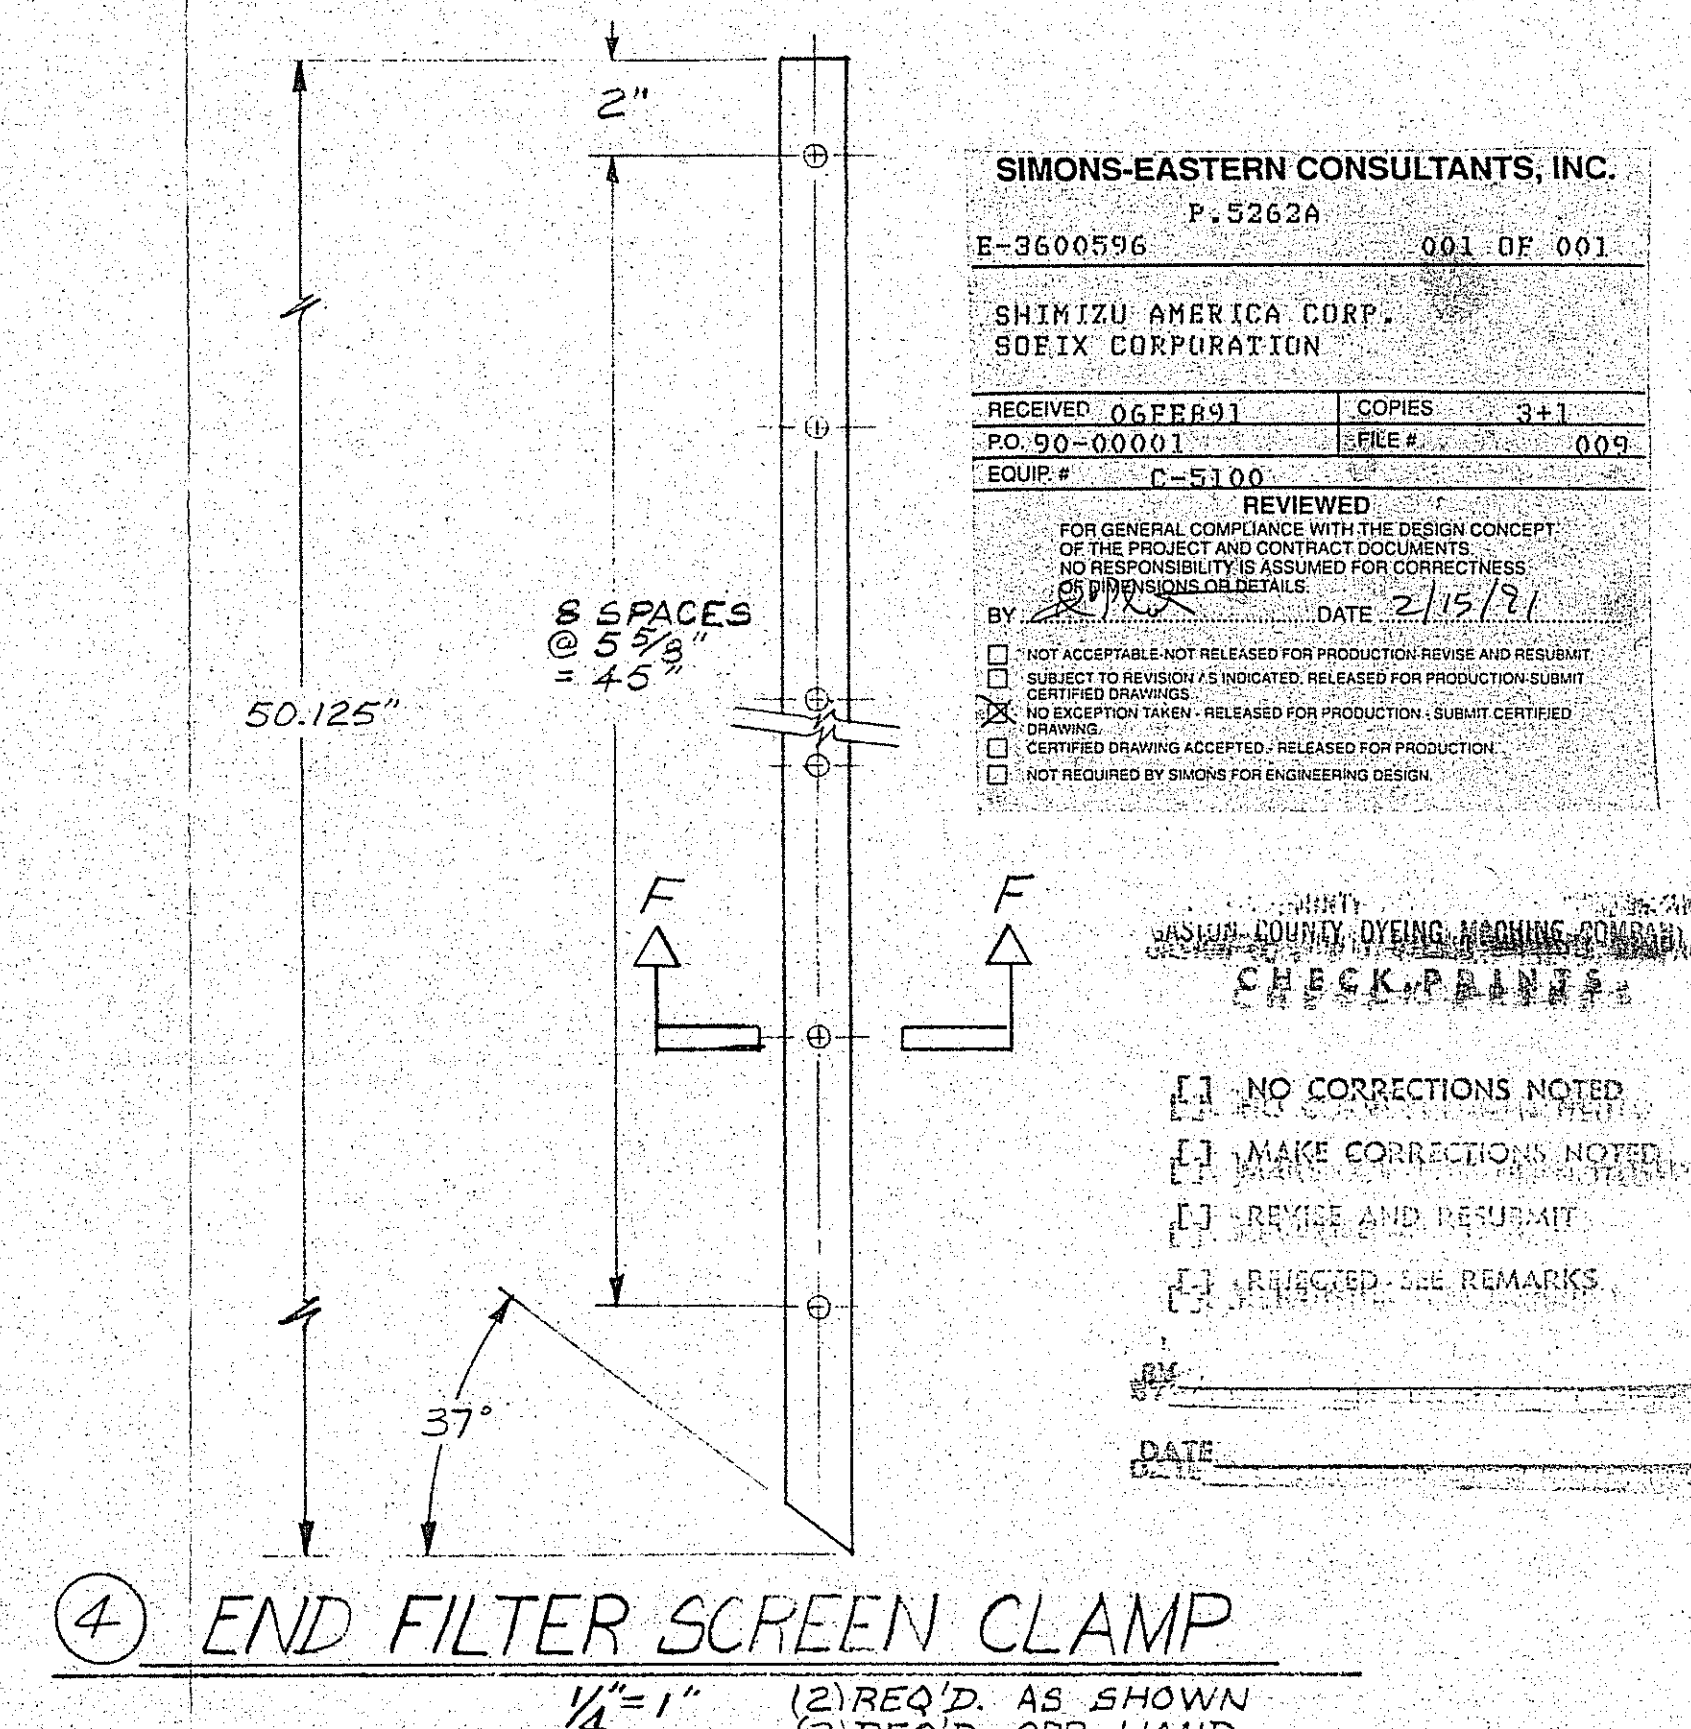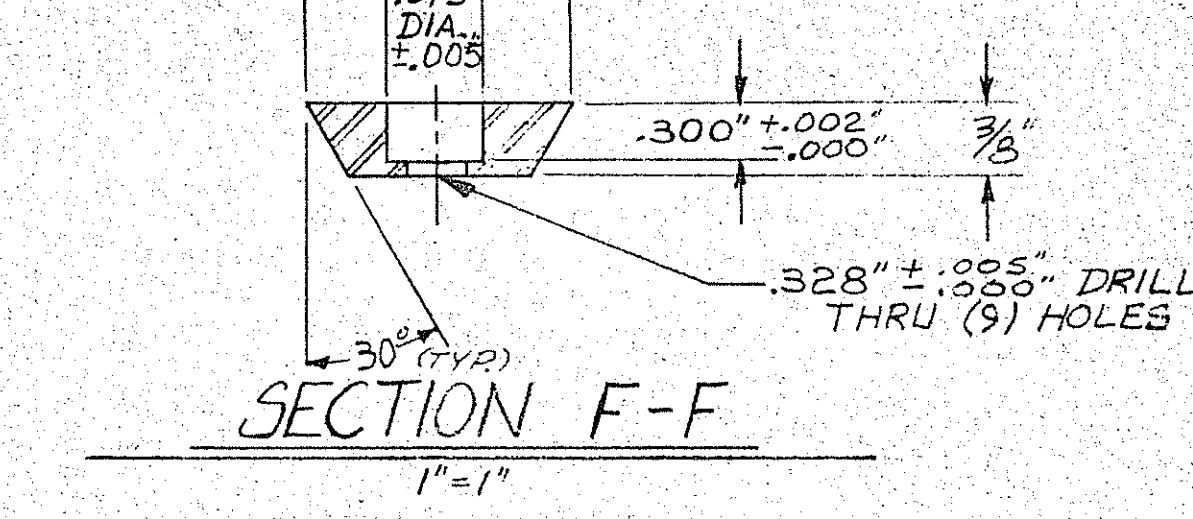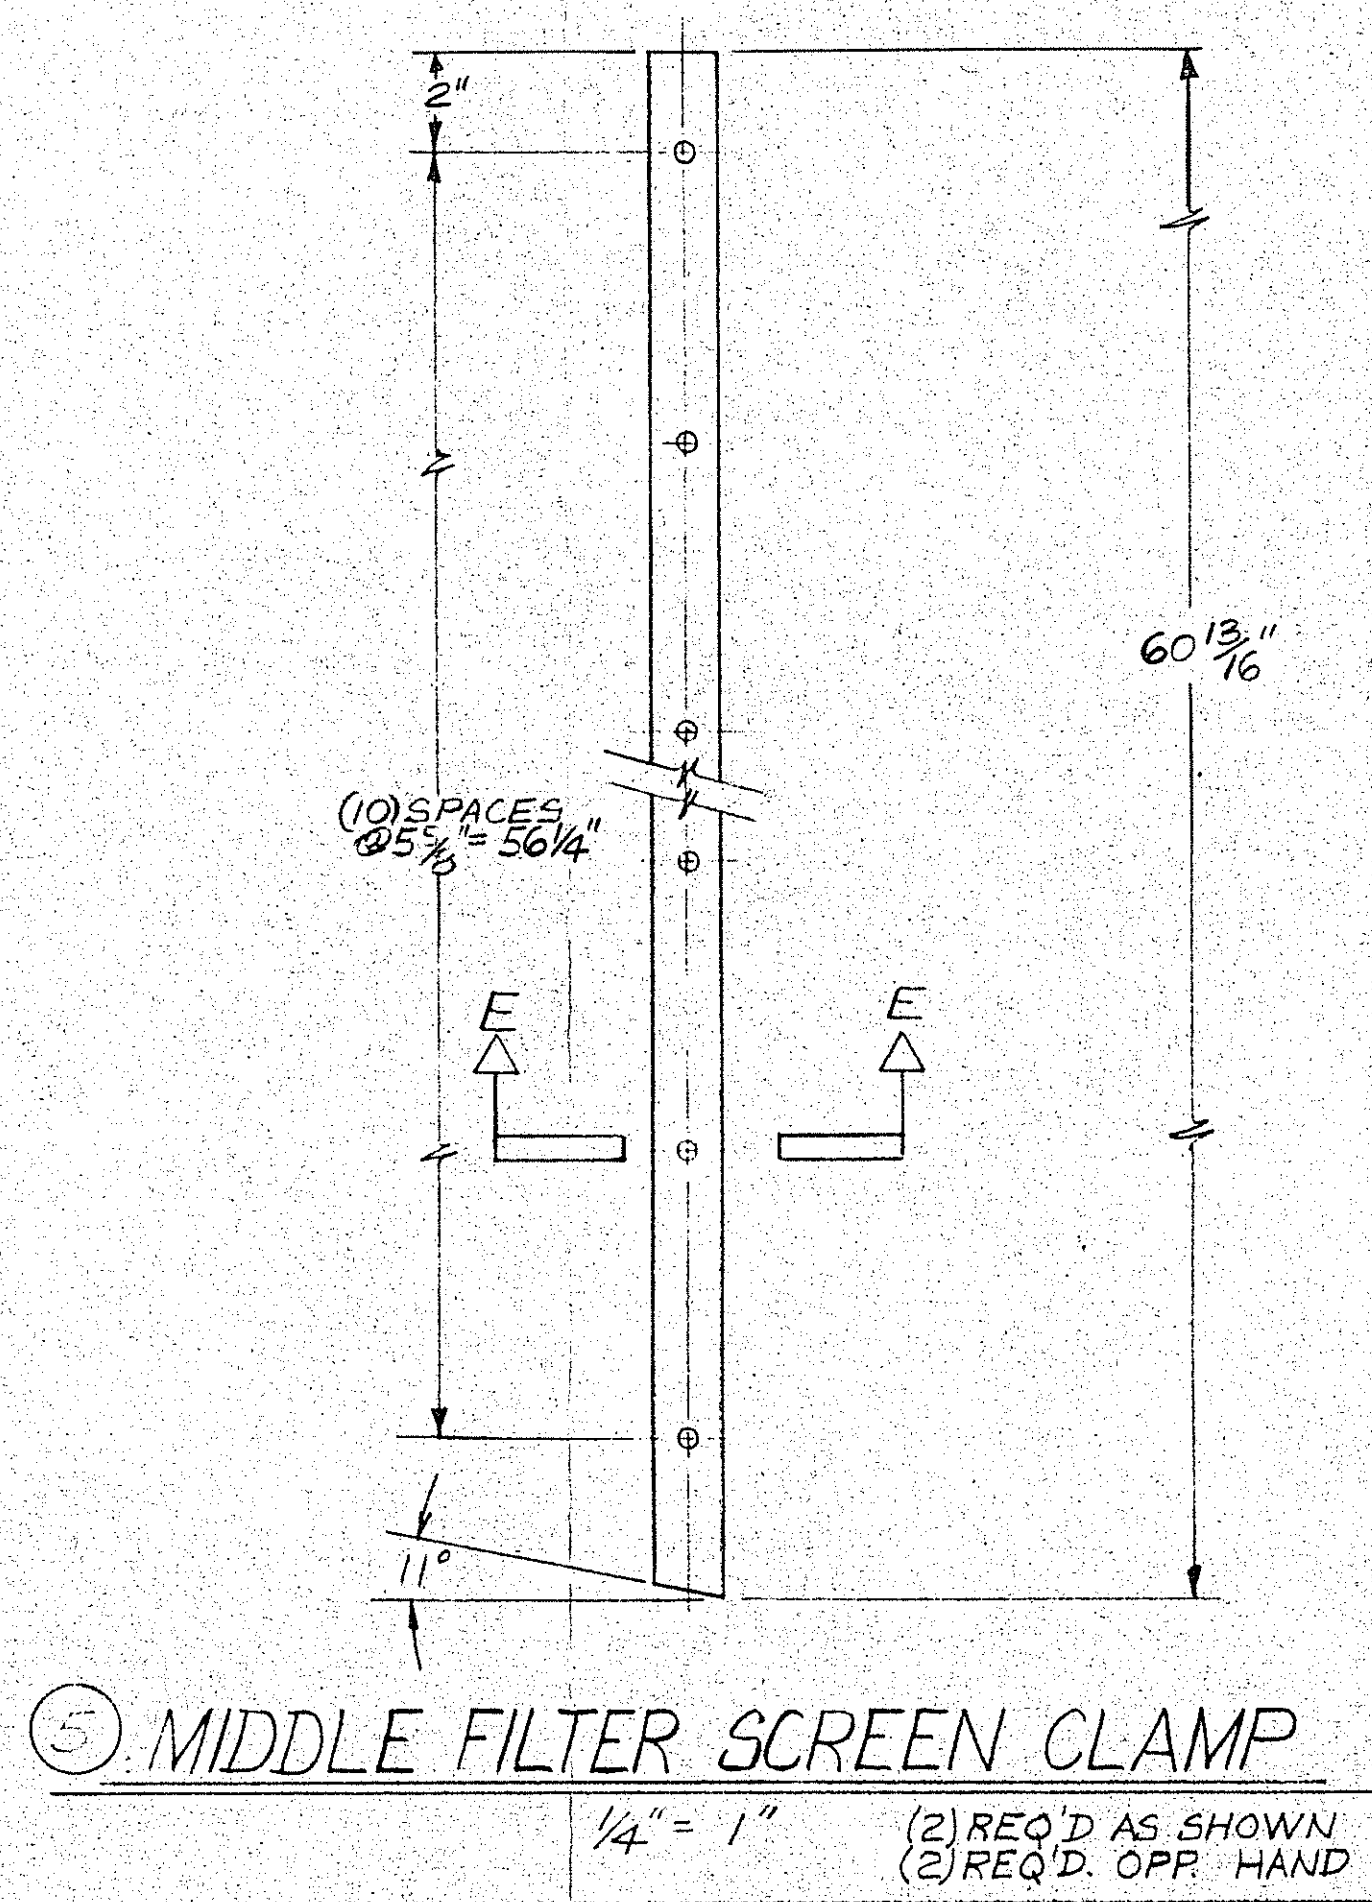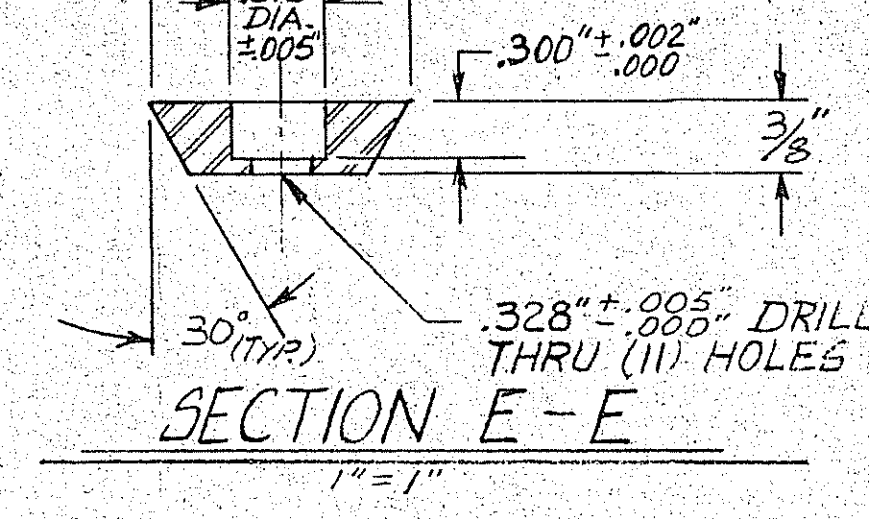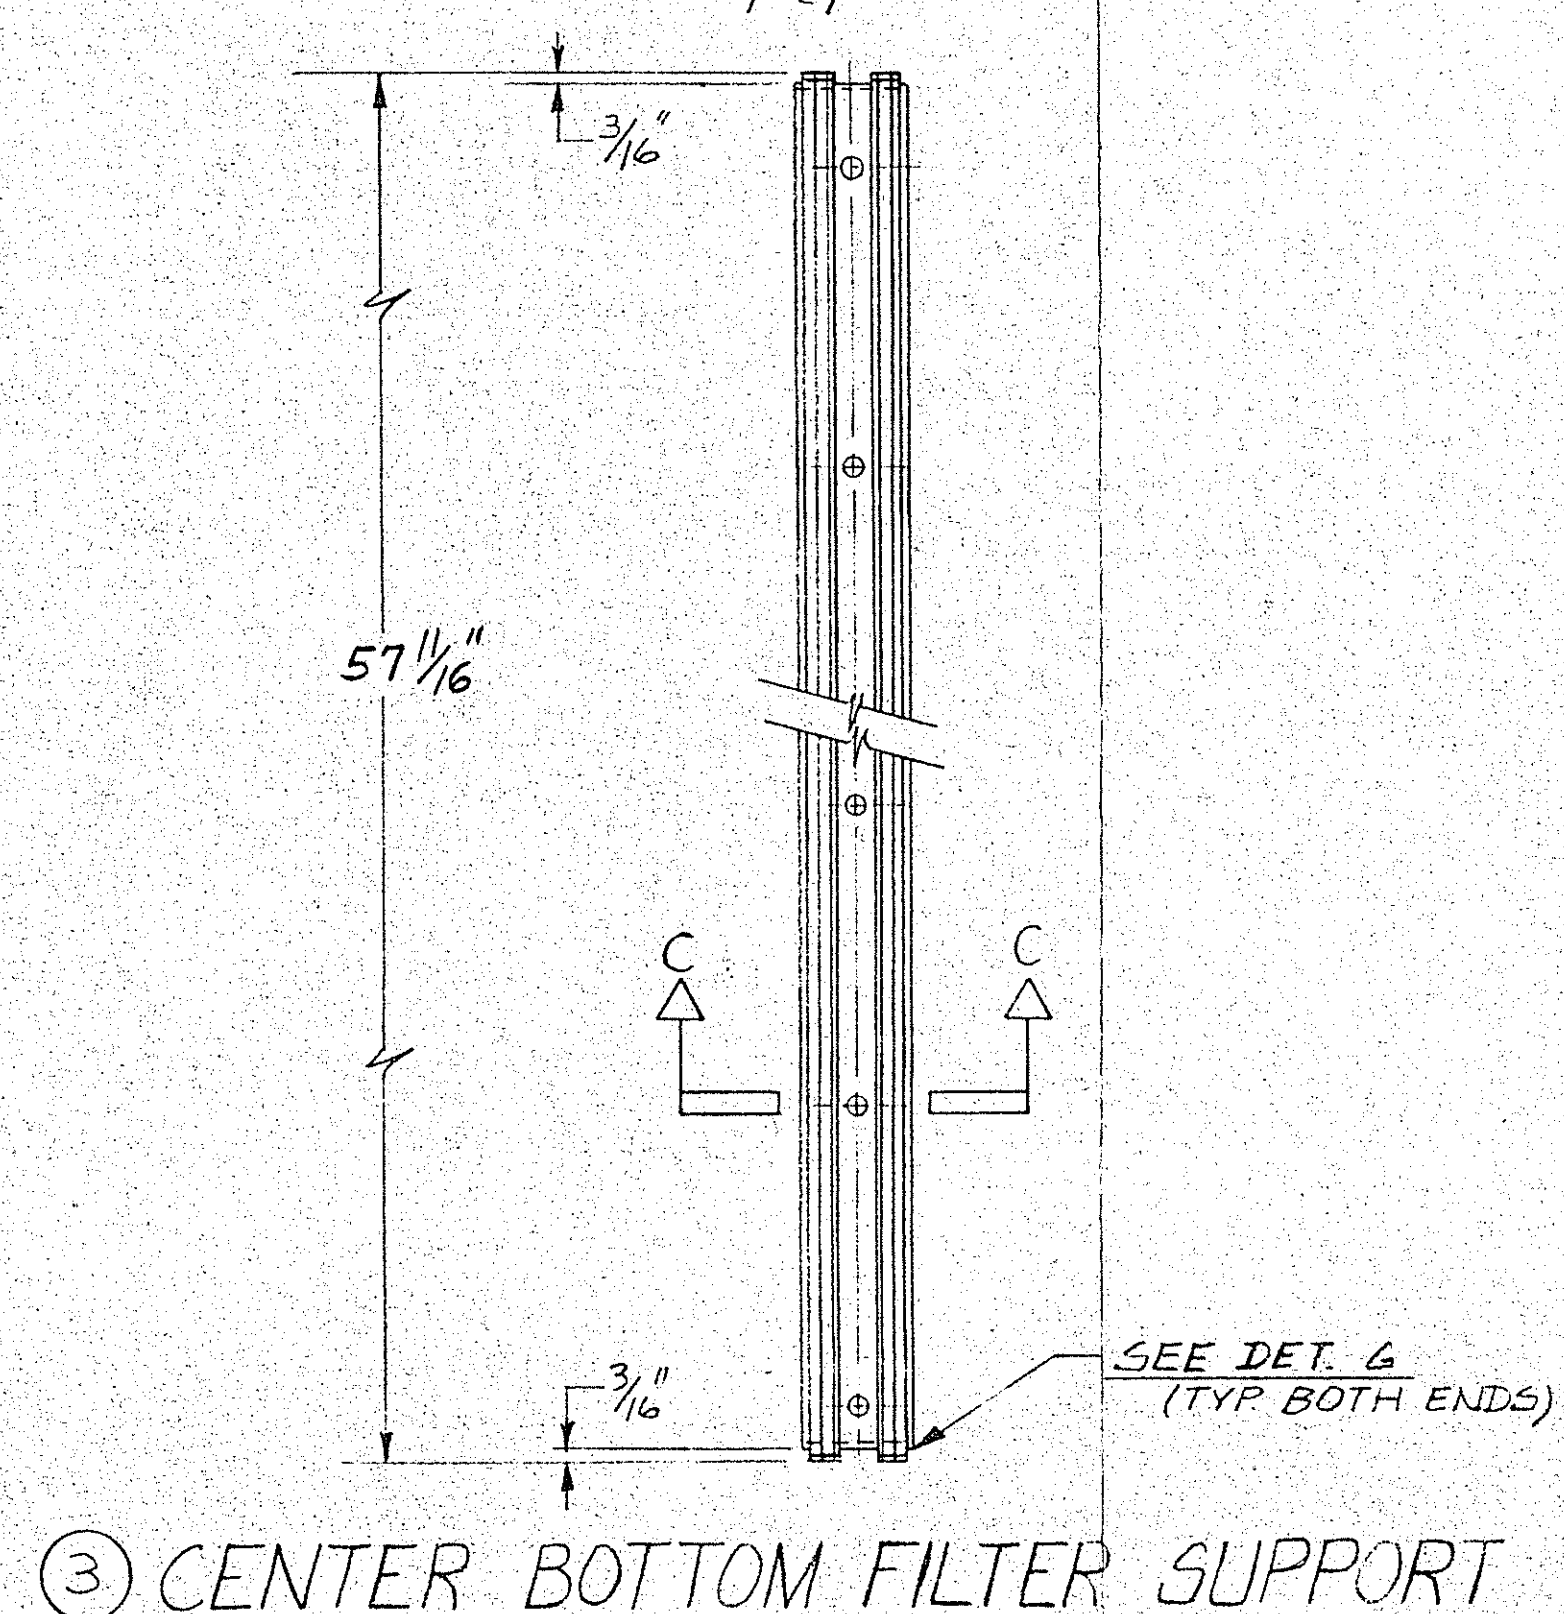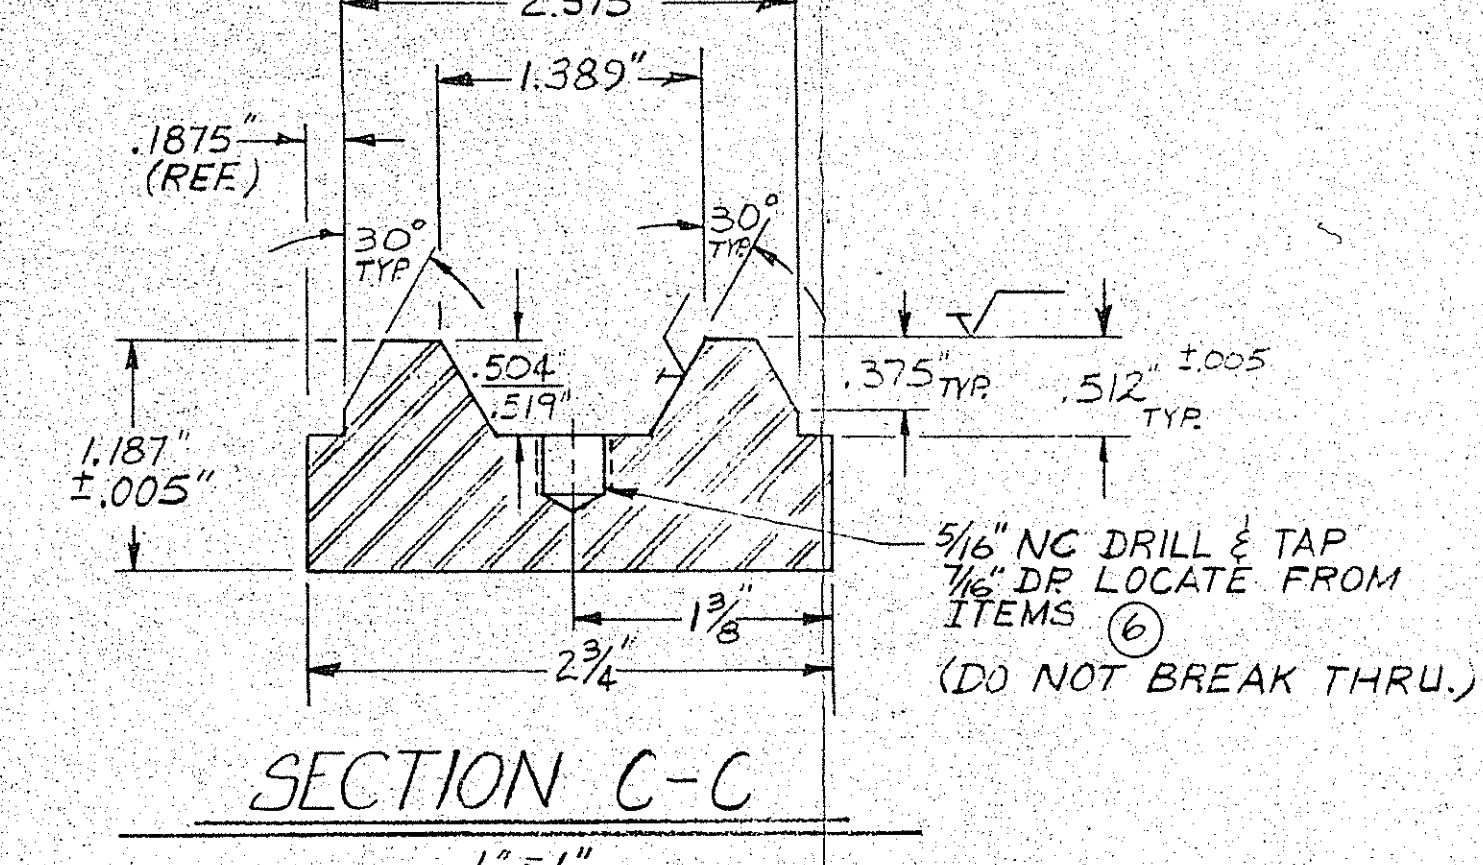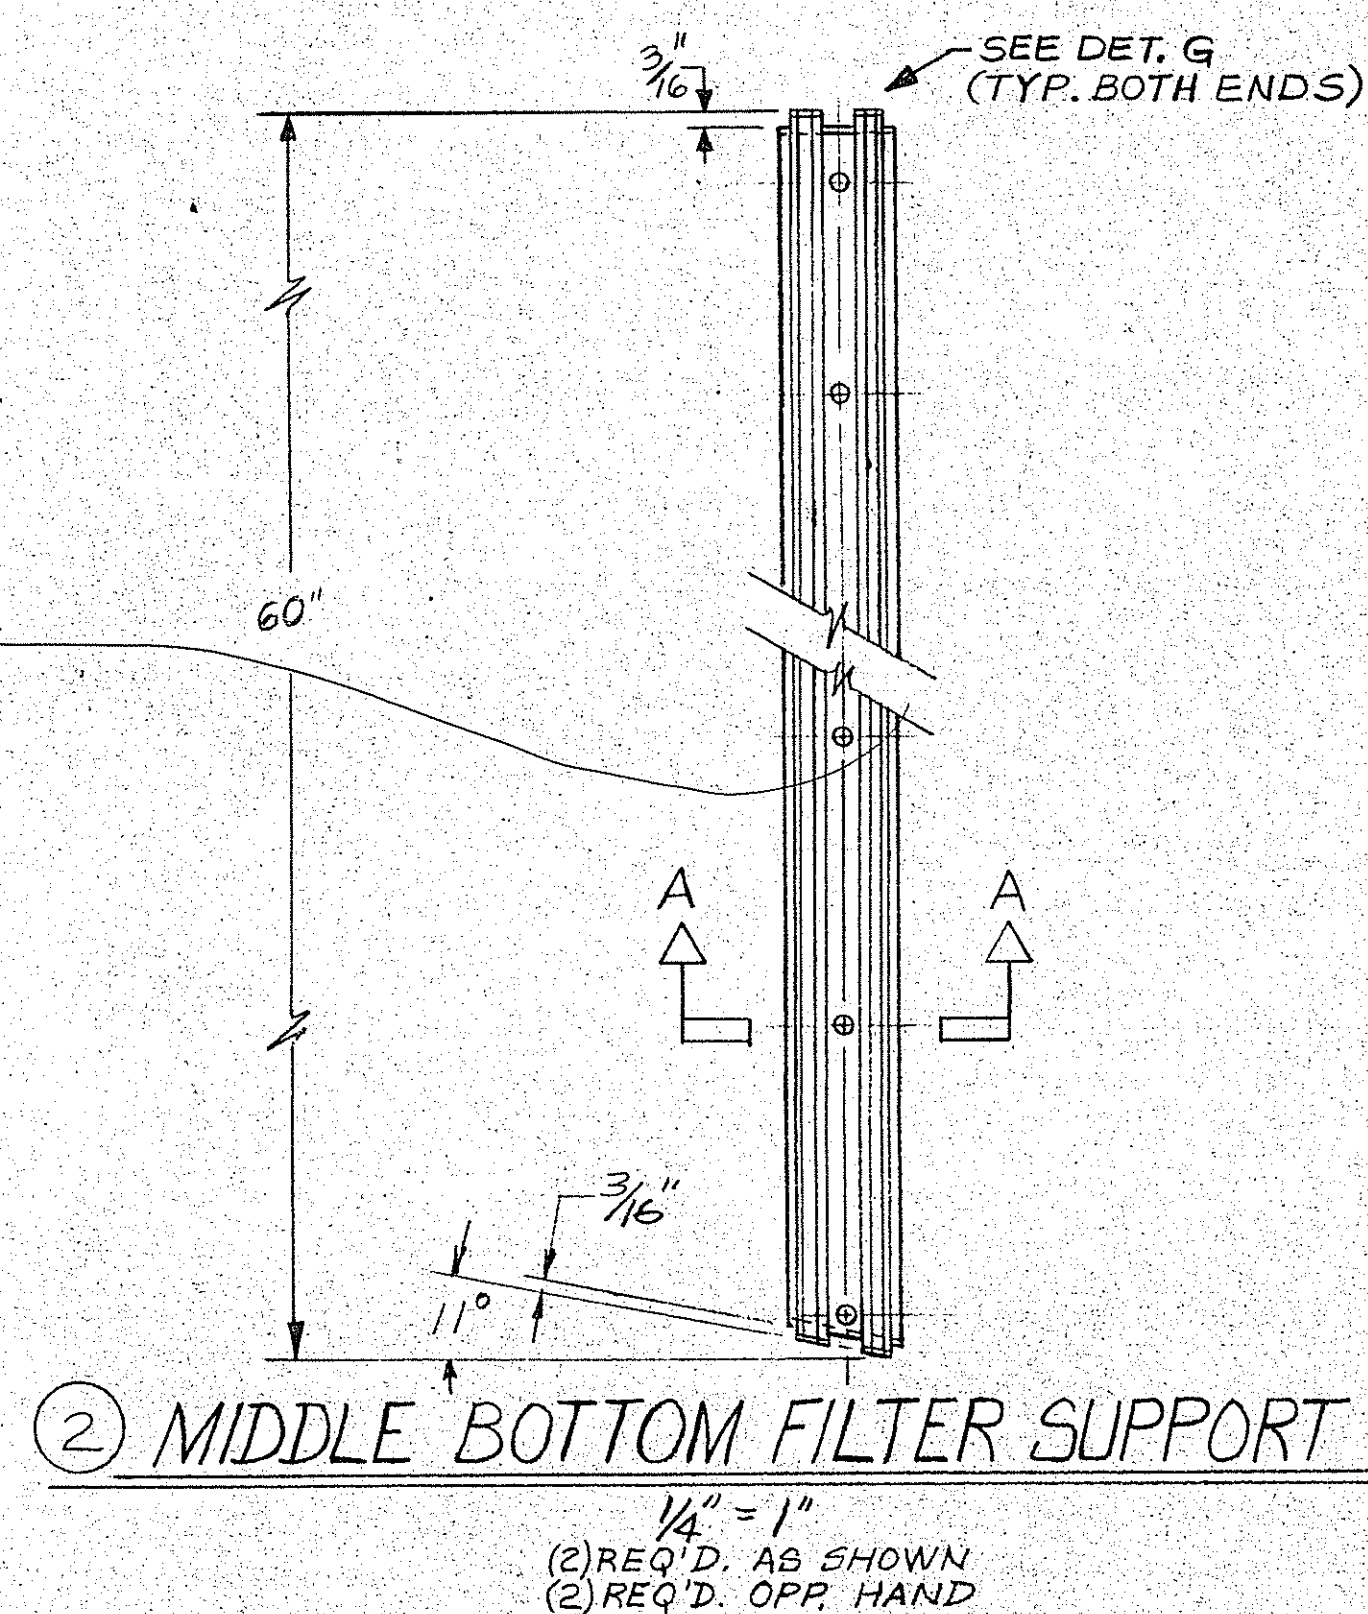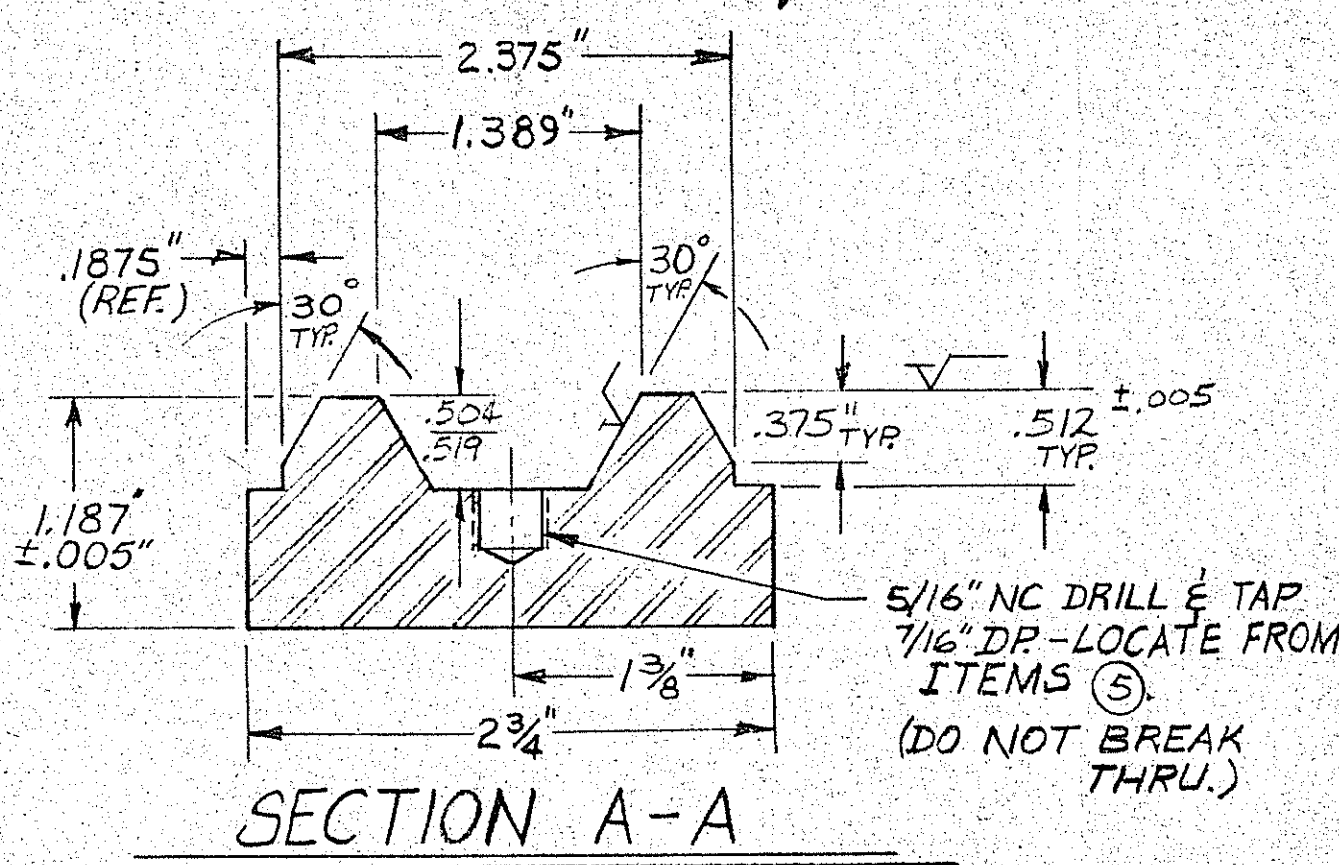

SIMONS-EASTERN CONSULTANTS, INC.
P. 5262A
E-3600596 001 OF 001

SHIMIZU AMERICA CORP.
SOFIX CORPORATION

RECEIVED: 04/28/91
PO. 90-00001
EQUIP. # C-5100






REVIEWED: 2/15/91
DATE: 2/15/91

FOR GENERAL COMPLIANCE WITH THE DESIGN CONCEPT OF THE PRODUCT AND CONTRACT DOCUMENTS, NO RESPONSIBILITY IS ASSUMED FOR CORRECTNESS OF THE DRAWING. THE USER OF THIS DRAWING SHALL BE RESPONSIBLE FOR THE PRODUCTION OF THE FINAL PRODUCT. THE USER OF THIS DRAWING SHALL BE RESPONSIBLE FOR THE PRODUCTION OF THE FINAL PRODUCT. THE USER OF THIS DRAWING SHALL BE RESPONSIBLE FOR THE PRODUCTION OF THE FINAL PRODUCT.

DATE: 2/15/91

① NO CORRECTIONS NOTED
② MAKE CORRECTIONS NOTED
③ REVISE AND RESUBMIT
④ REVISED - SEE REMARKS



DATE: 2/15/91

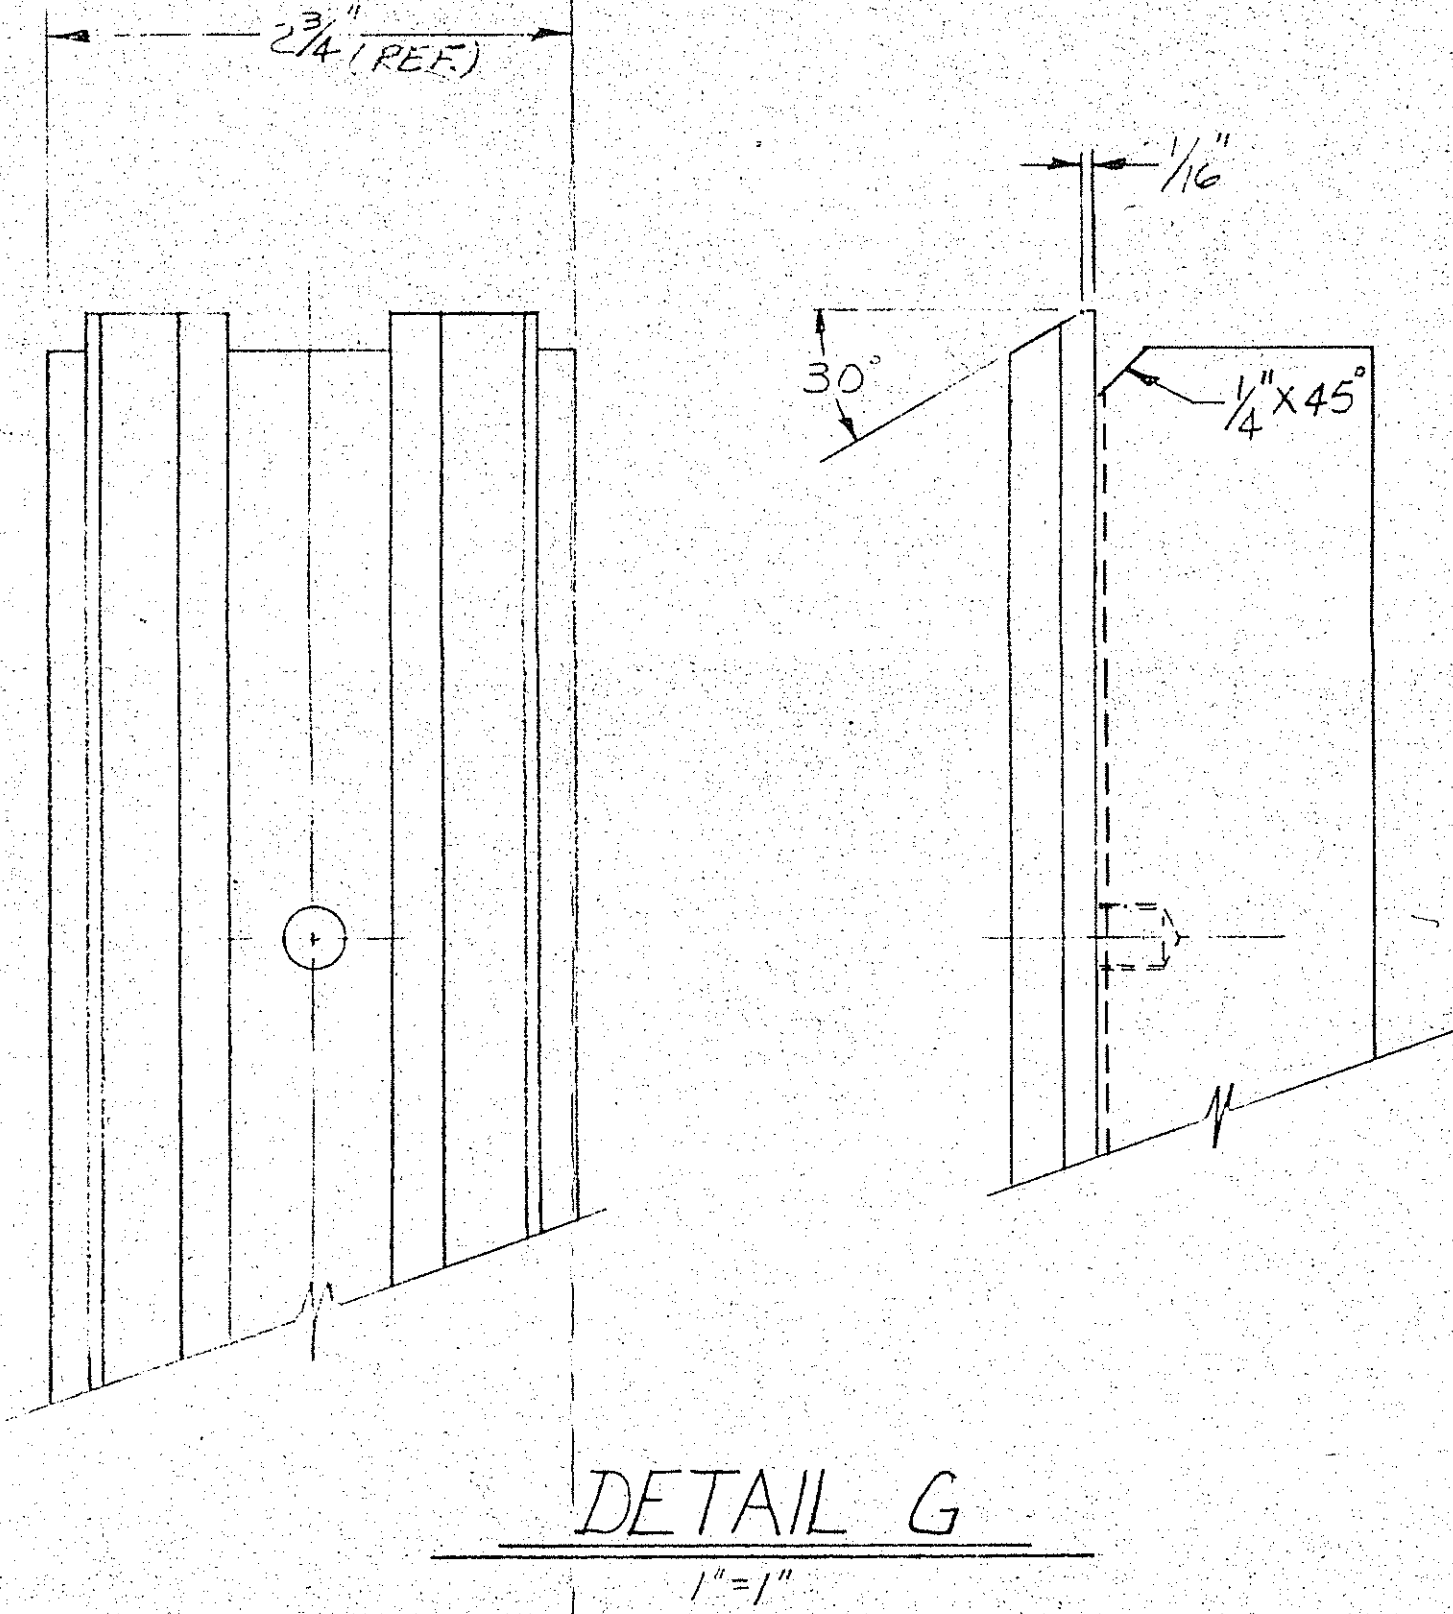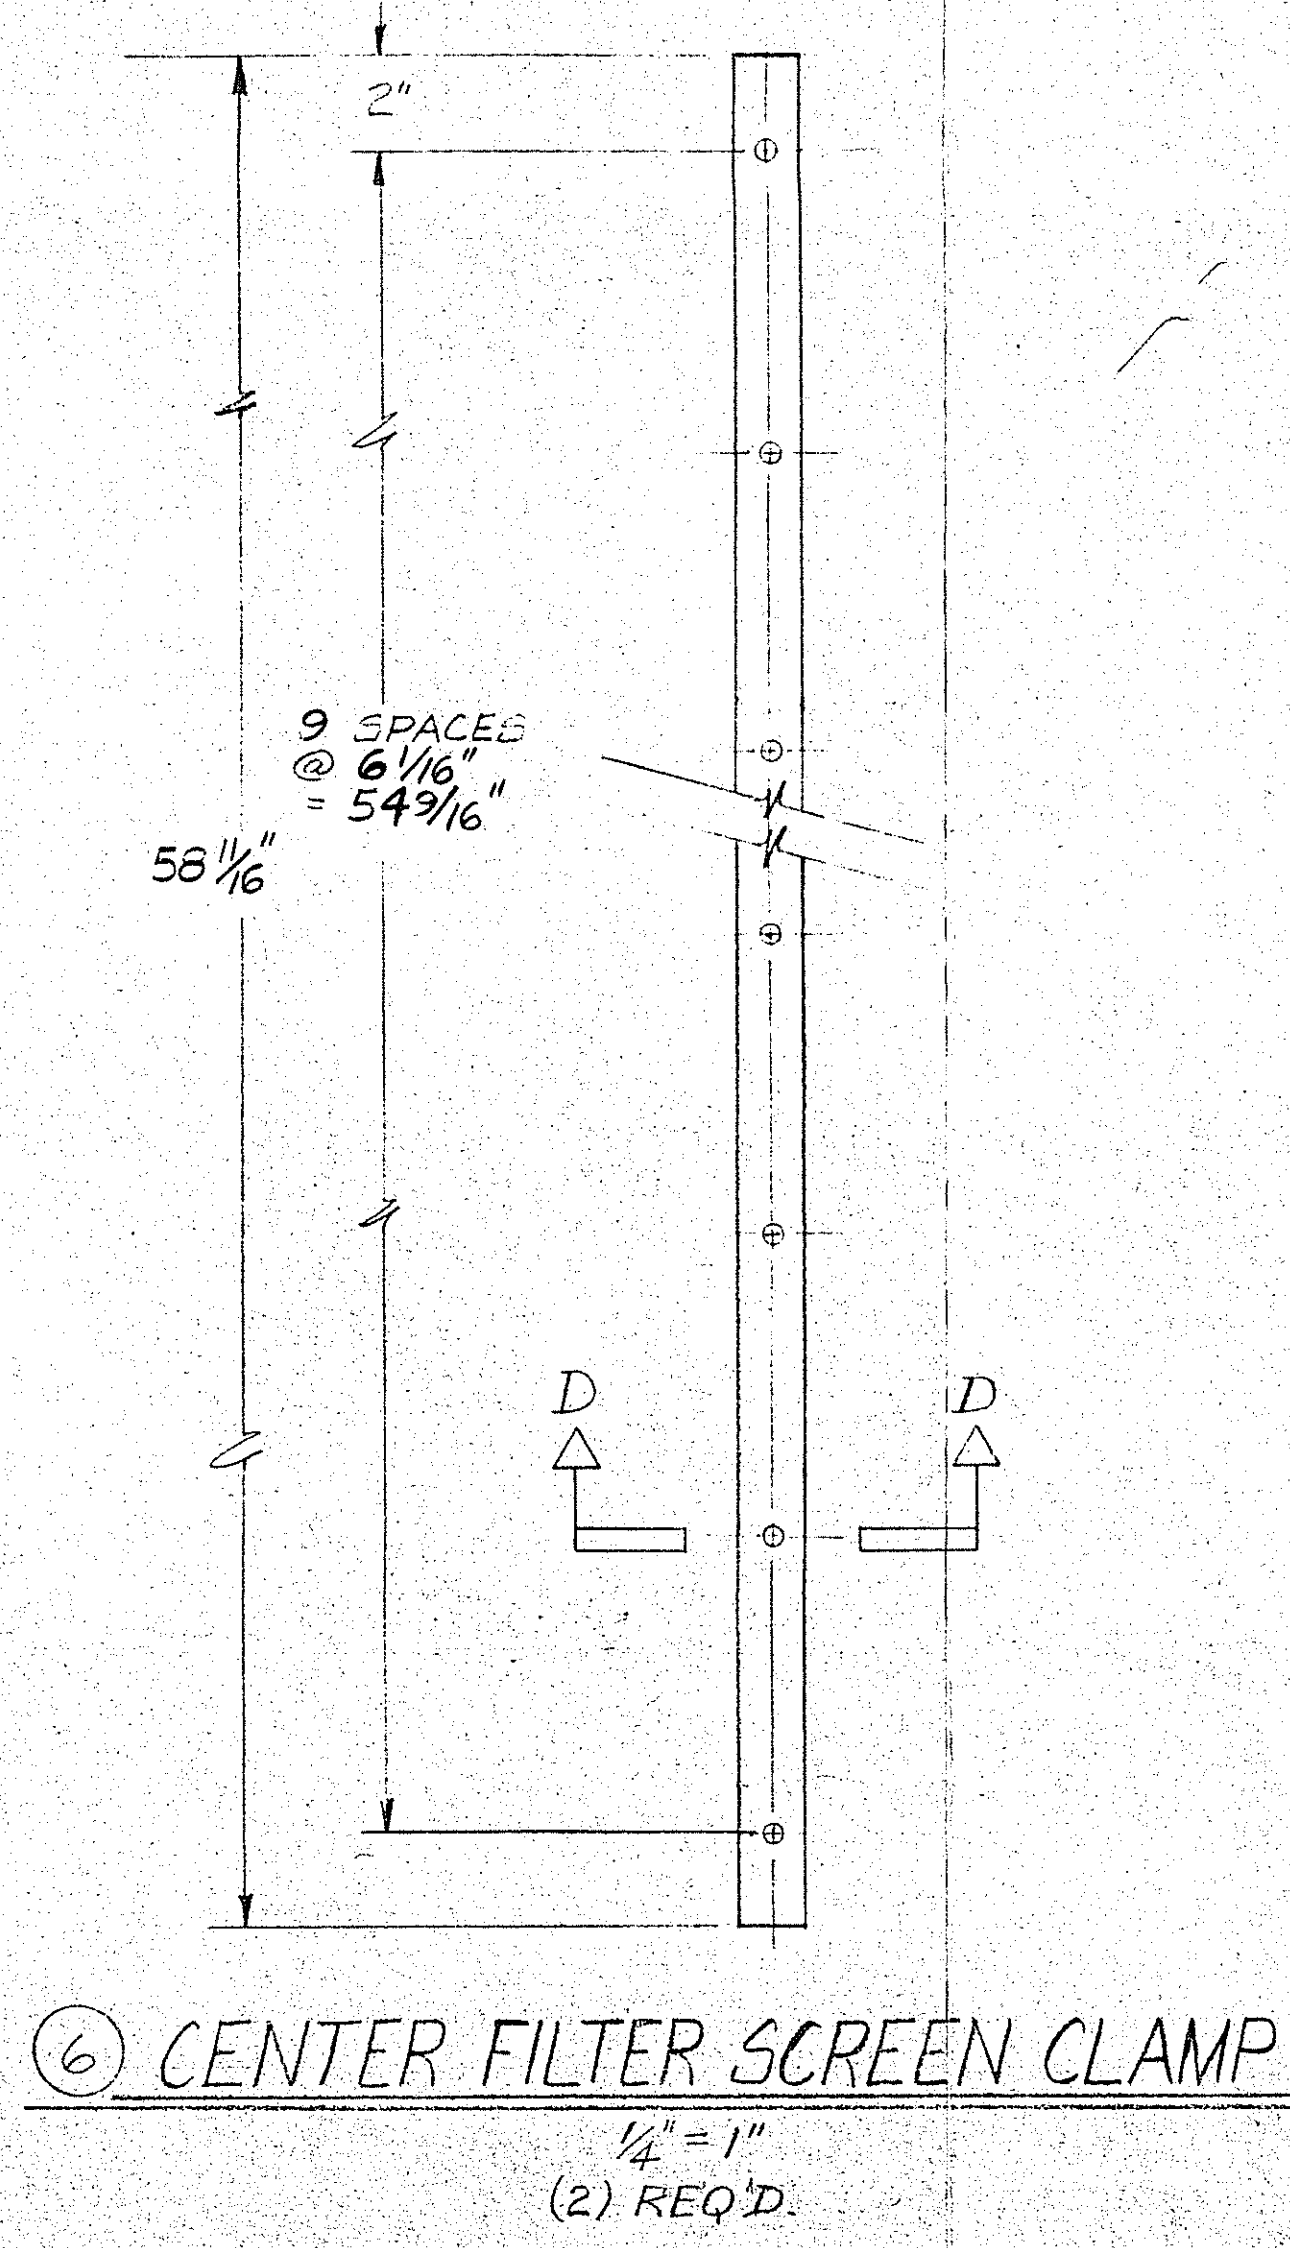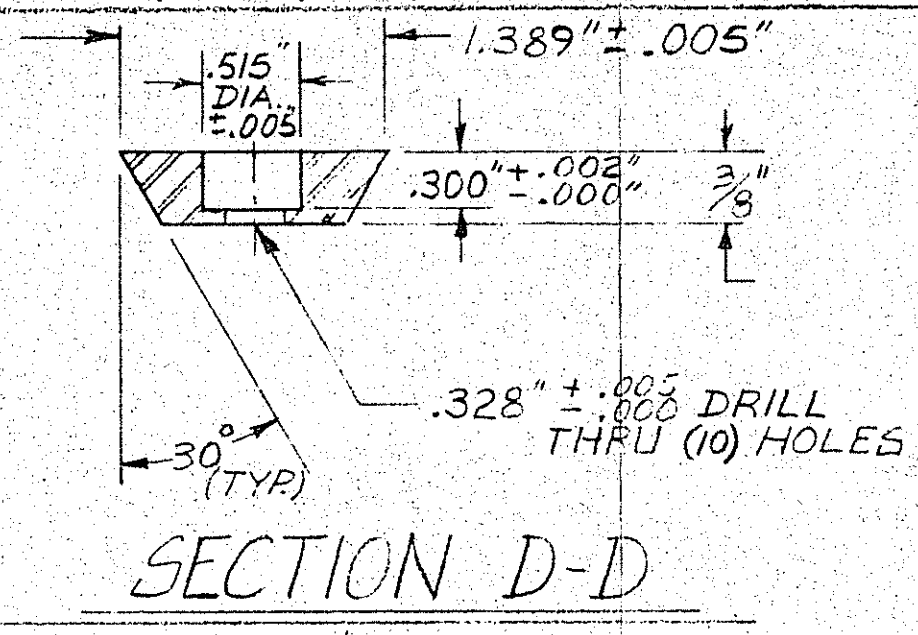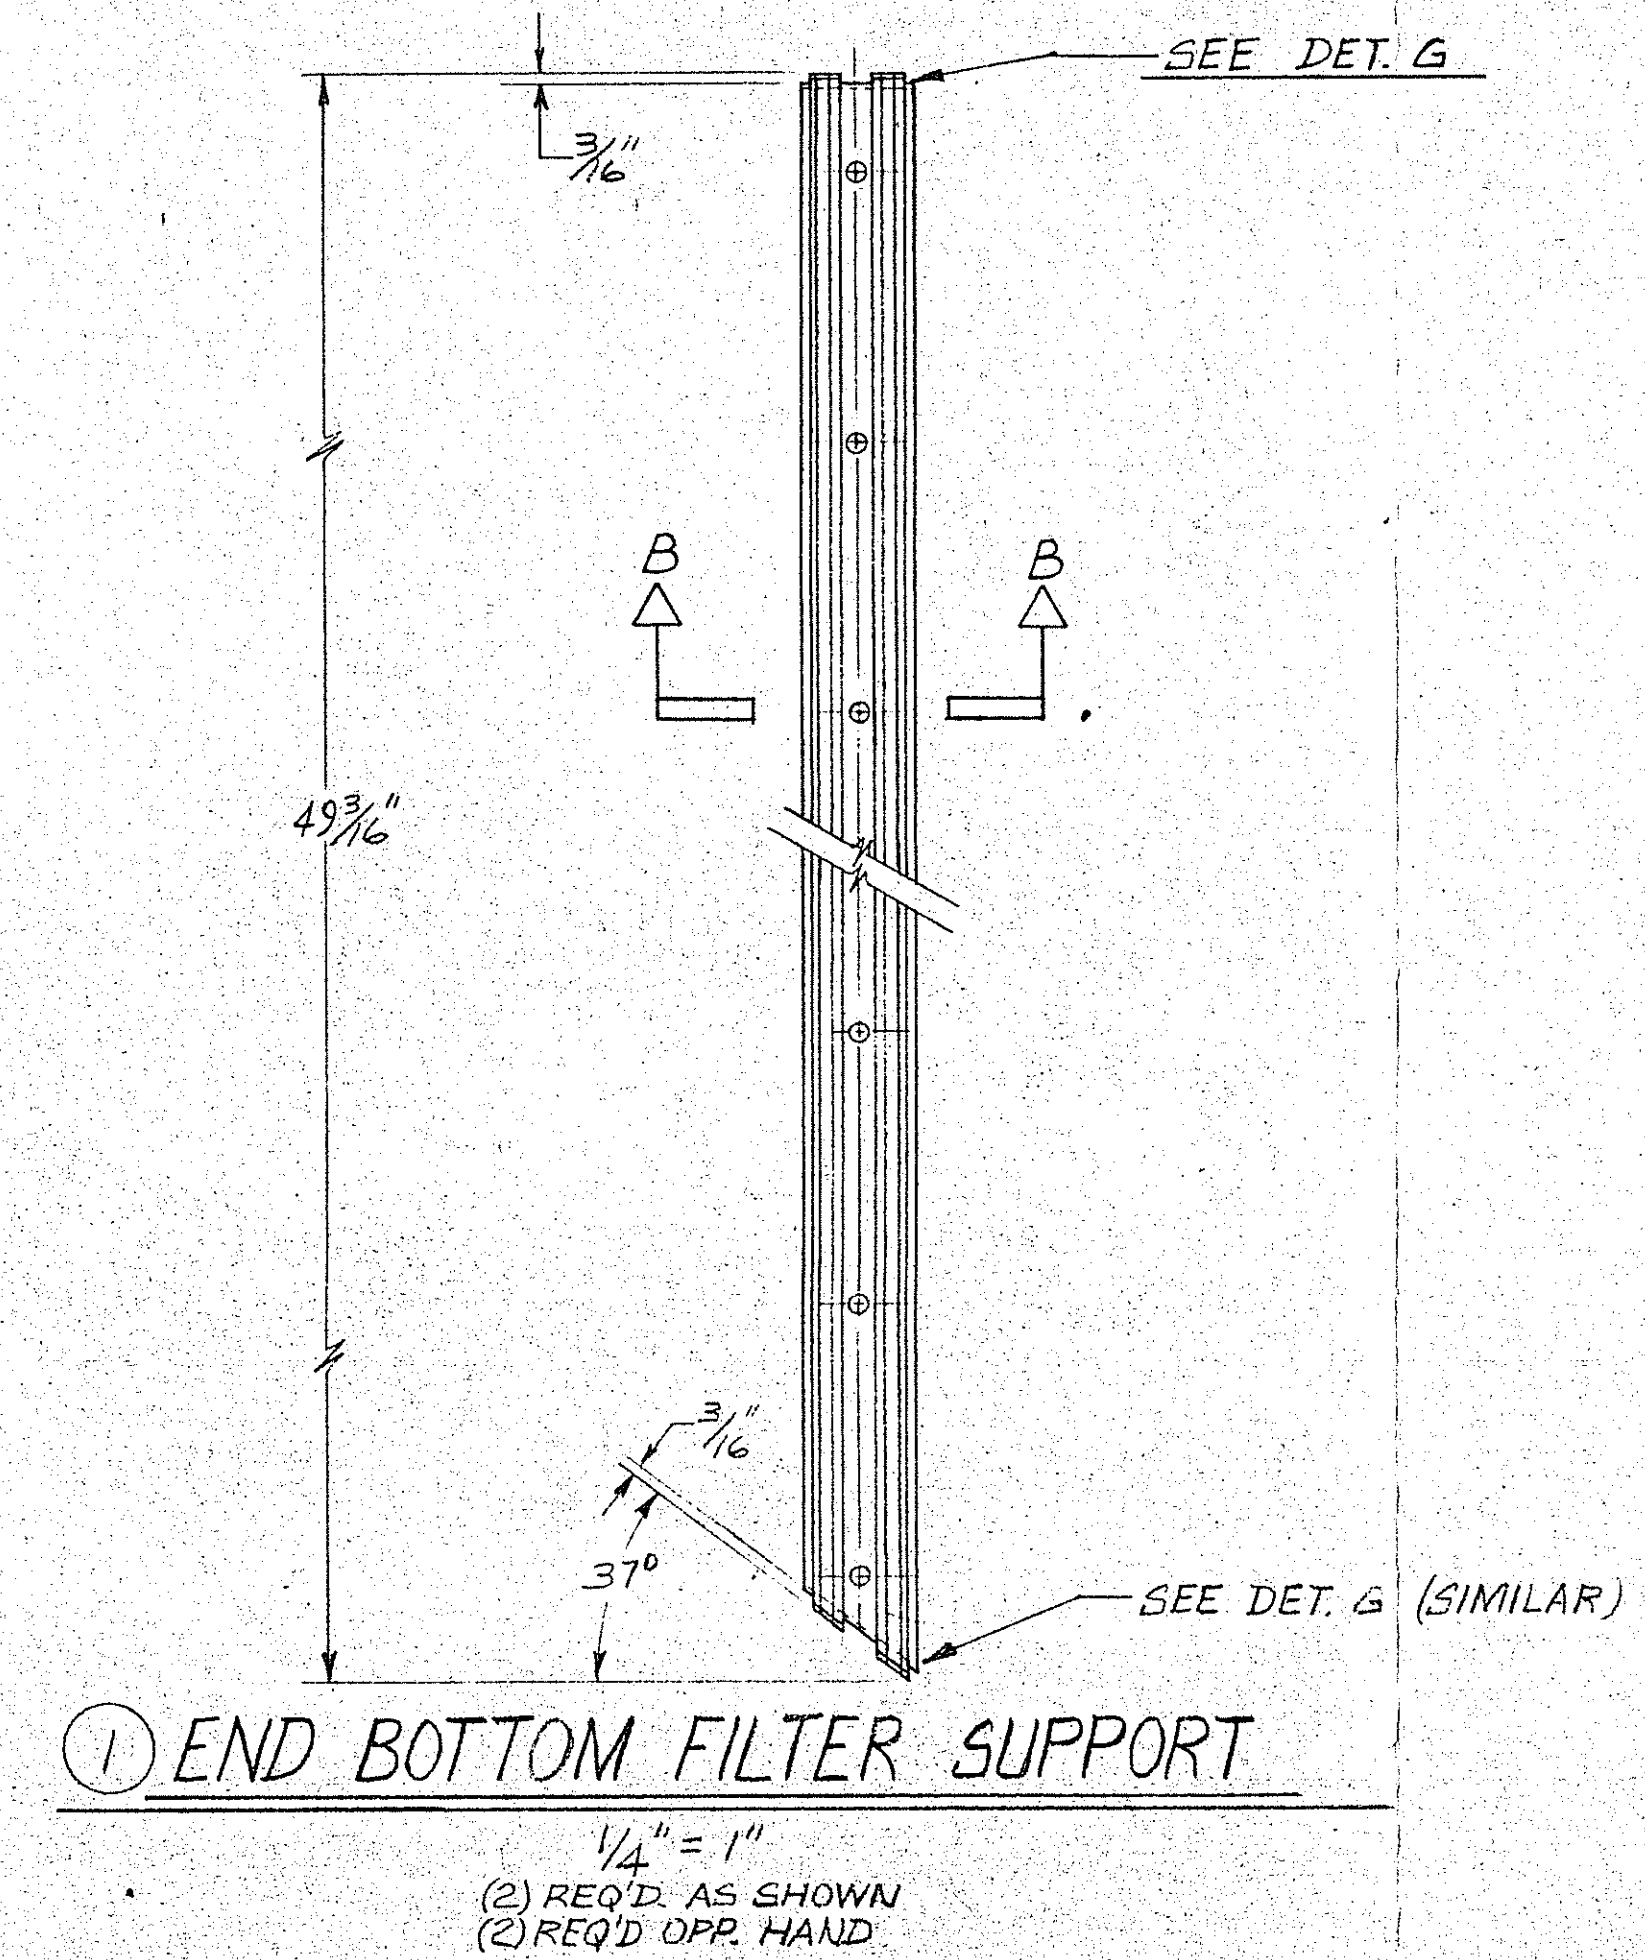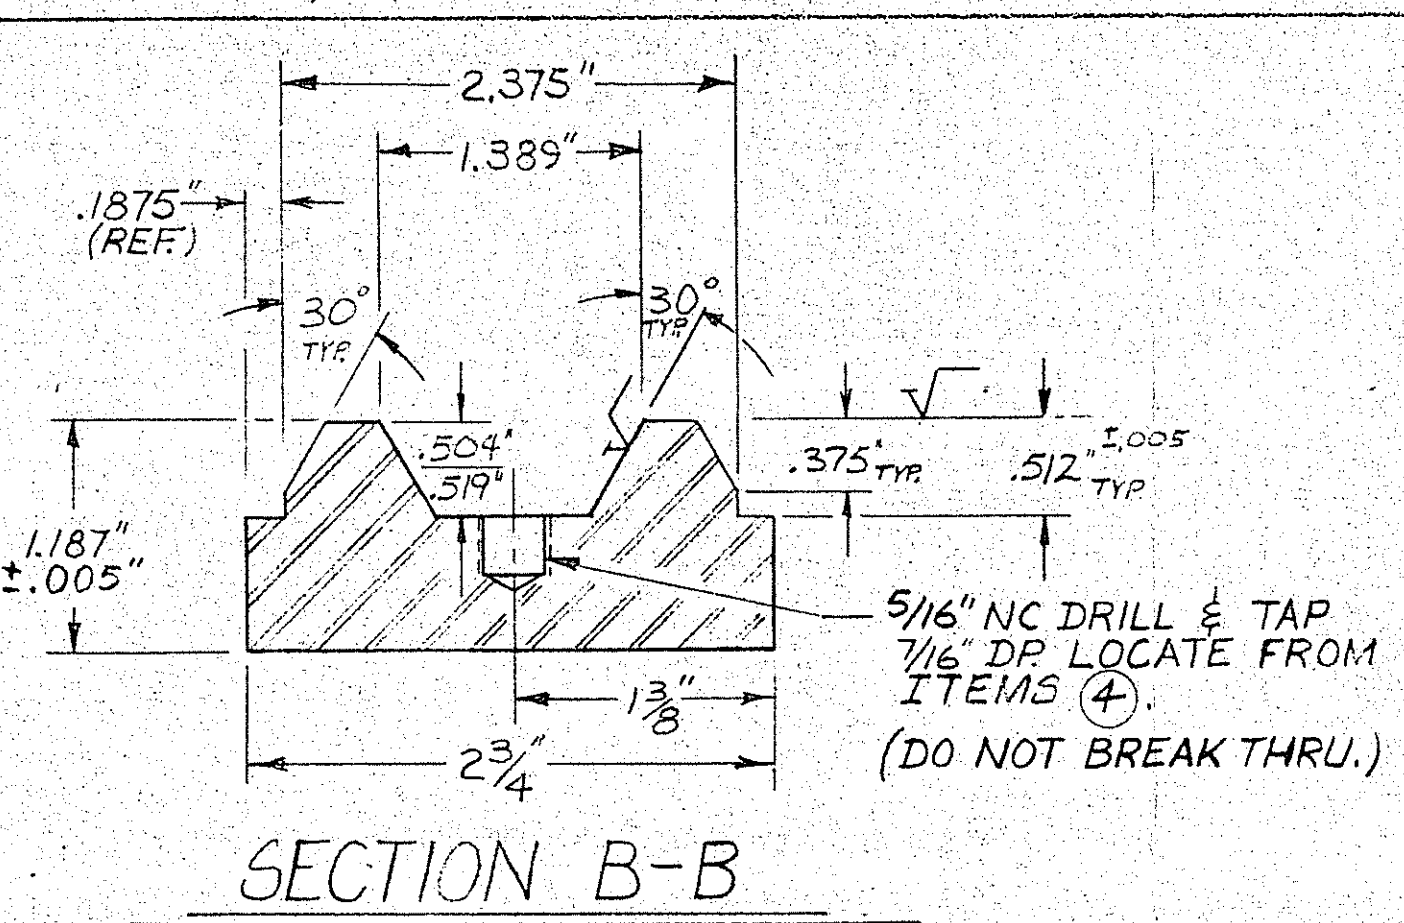

PRINT FOR APPROVAL
Customer Order No. 90-00001
Shop Order No. 90-RF-171
ROSEMUND
Charlotte, NC 28191



NO.	QTY.	SIZE	RATING	TYPE	SCH.	SERVICE/DESCRIPTION
NOZZLE SCHEDULE						

REV.	DESCRIPTION	DATE	BY	CHECKED	APPROVED
G					
F					
E					
D					
C					
B					
A					
RETURN TO VENDOR					
GASTON COUNTY FABRICATION					
A DIVISION OF GASTON COUNTY DRYING MACHINE COMPANY					
STATION, NORTH CAROLINA 28134-1760					
TITLE: SUPPORT & CLAMP BARS					
CUSTOMER: 3M ROSEMUND FILTER VESSEL FOR SOFIX					
CUSTOMER P.O. NO. 1747 CUSTOMER ITEM NO. C5100					
DRAWN BY: M. McIntosh (F-9) DATE: 1/21/91					
SHOP ORDER NO. 90816A NO. REQUIRED: 1 SHEET OF: 1					
SCALE: NOTED No. E-3600596					

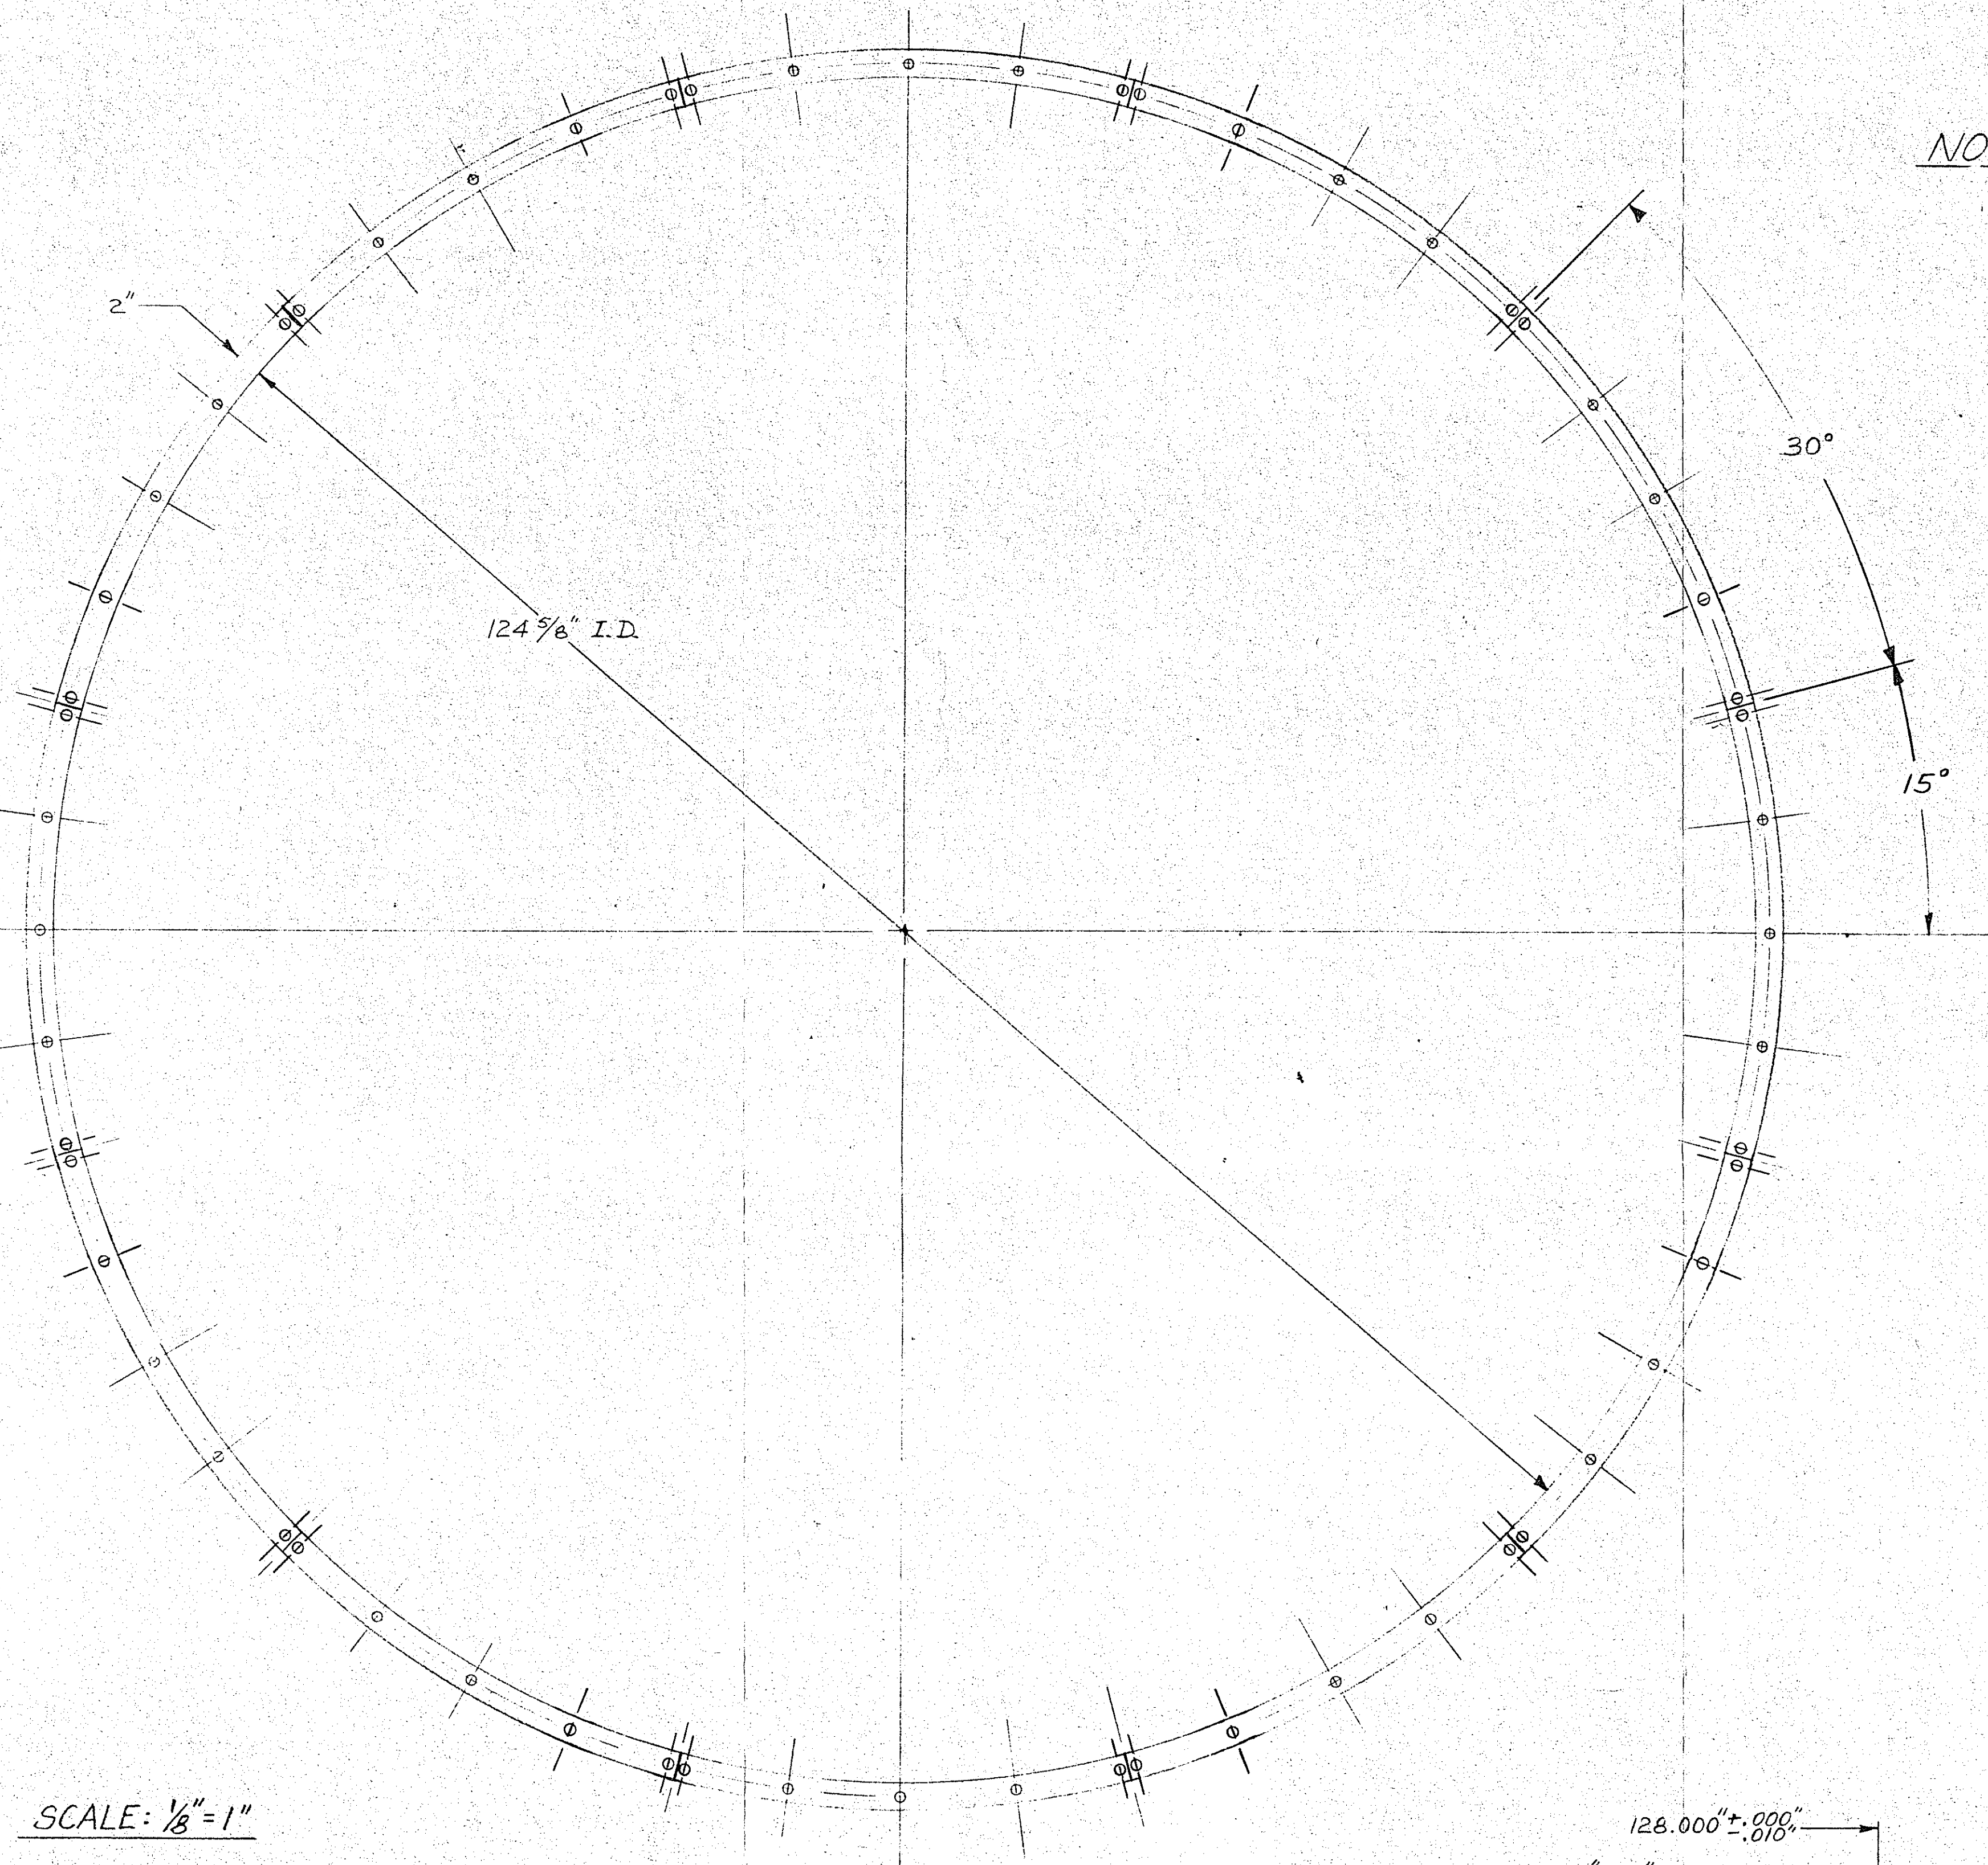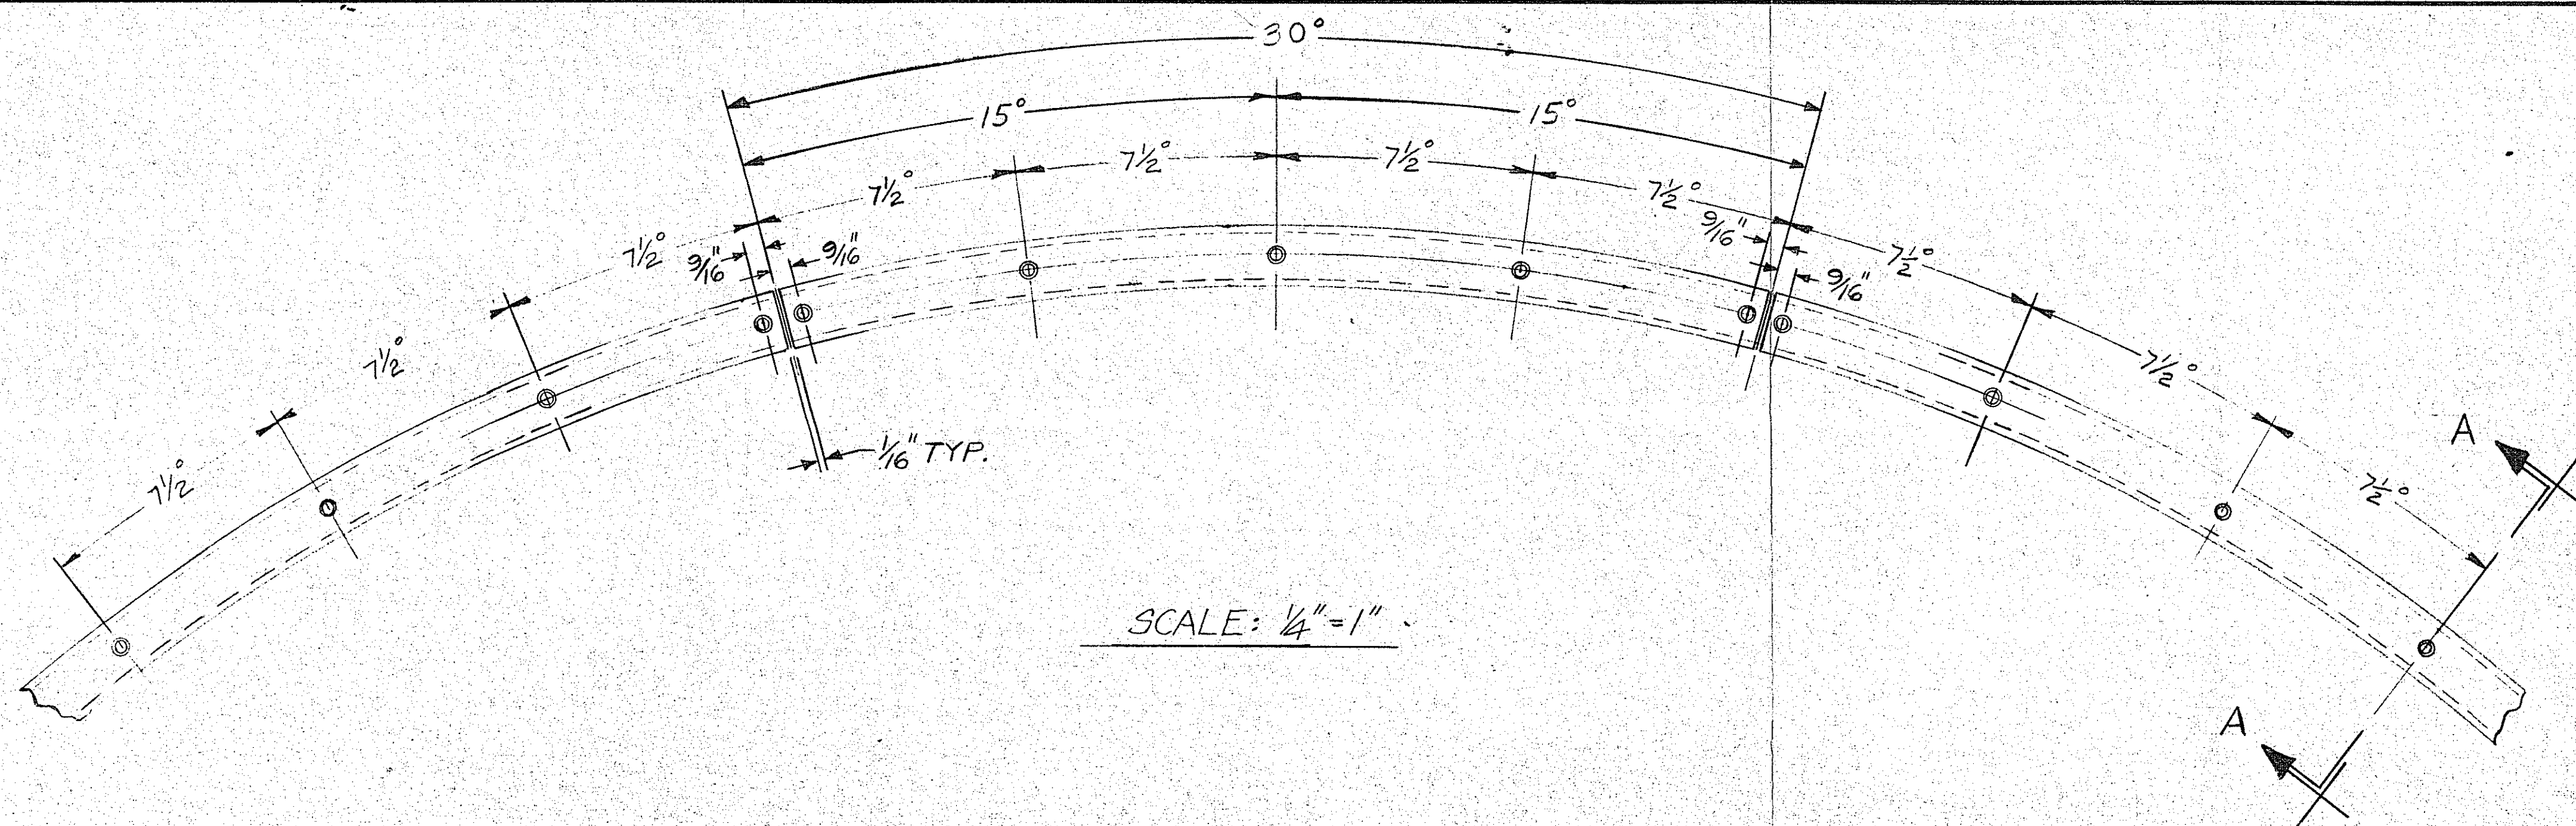


NOTE:

BURN SEGMENTS FROM PLATE TO GIVEN I.D. & O.D. - (12) SECTIONS; DRILL & C-BORE HOLES; BOLT TO JIG & MACHINE TAPERS.

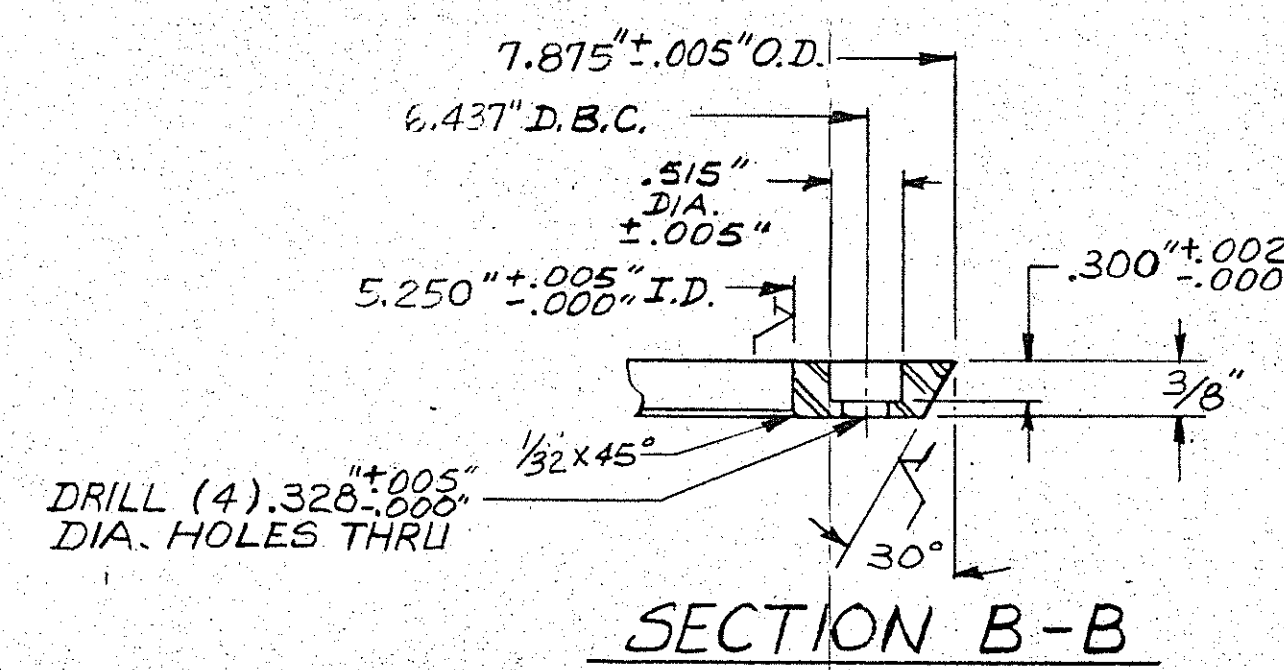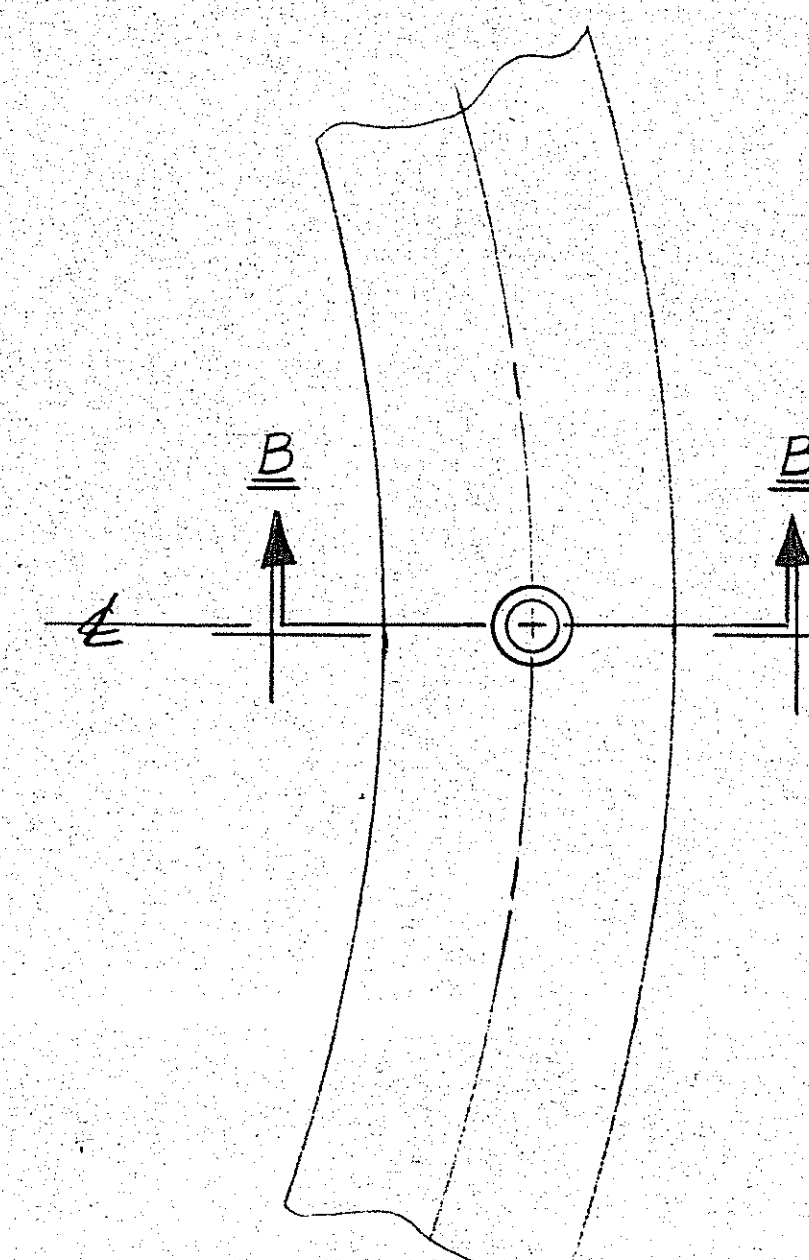

② INNER TIGHTENING RING 3/4" = 1"

① OUTER TIGHTENING RING

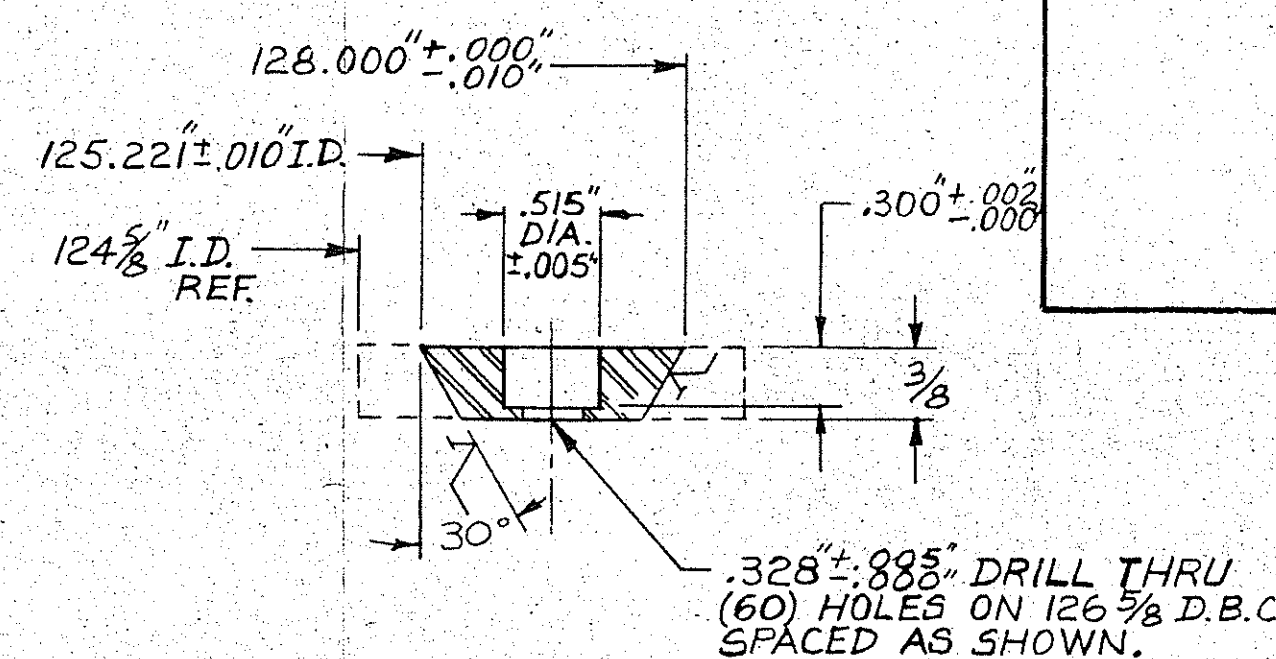

SECTION A-A 1" = 1"

NO.	QTY.	SIZE	RATING	TYPE	SCH.	SERVICE/DESCRIPTION
NOZZLE SCHEDULE						

SIMONS-EASTERN CONSULTANTS, INC.
P.5262A
E-3600595 001 OF 001

SHINJII AMERICA CORP.
SOFIX CORPORATION

RECEIVED 05/29/91 COPIES 311
P.O. NO. 00001 FILE# 000
EQUIP# E-5100

FOR GENERAL COMPLIANCE WITH THE DESIGN CONCEPT OF THE PROJECT AND CONTRACT DOCUMENTS, NO RESPONSIBILITY TO ASSURE FOR CORRECTNESS OF THE DESIGN IS ASSUMED.

DATE 2/12/91

NOT ACCEPTABLE AND NOT RELEASED FOR PRODUCTION REVISION AND REVISION.
SUBJECT TO REVISIONS AS PROVIDED FOR PRODUCTION REVISION.
NOT ACCEPTABLE AND NOT RELEASED FOR PRODUCTION REVISION.
NOT ACCEPTABLE AND NOT RELEASED FOR PRODUCTION REVISION.
NOT ACCEPTABLE AND NOT RELEASED FOR PRODUCTION REVISION.
NOT ACCEPTABLE AND NOT RELEASED FOR PRODUCTION REVISION.

GASTON COUNTY DYING MACHINE COMPANY
CHECKED BY: [Signature]

- ☐ NO CORRECTIONS NOTED
- ☐ MAKE CORRECTIONS NOTED
- ☐ REVISE AND RESUBMIT
- ☐ REJECTED-SEE REMARKS

REV.	QTY.	DESCRIPTION	DATE	BY	CHECKED	APPROVED
2	1	RING, 8" O.D. x 1/8" THK.	9/24/98			
1	1	PLATE - 3/8" THK. X 64" X 64" LG.	9/24/98			

RETURN TO VENDOR

GASTON COUNTY FABRICATION
A DIVISION OF GASTON COUNTY DYING MACHINE COMPANY
STANLEY, NORTH CAROLINA 274 263-3765

CUSTOMER 8M² ROSENMUND FILTER VESSEL
FOR SOFIX


TITLE FILTER PLATE RING 5

CUSTOMER P.O. NO. 1747 CUSTOMER ITEM NO. C5100


DRAWN BY M.M. INTOSH 1-2-91 CHECKED BY [Signature] DATE 1/17/91

SHIP ORDER NO. 20816A NO. REQUIRED SHEET 10

SCALE NOTED No. E-3600595 REV.

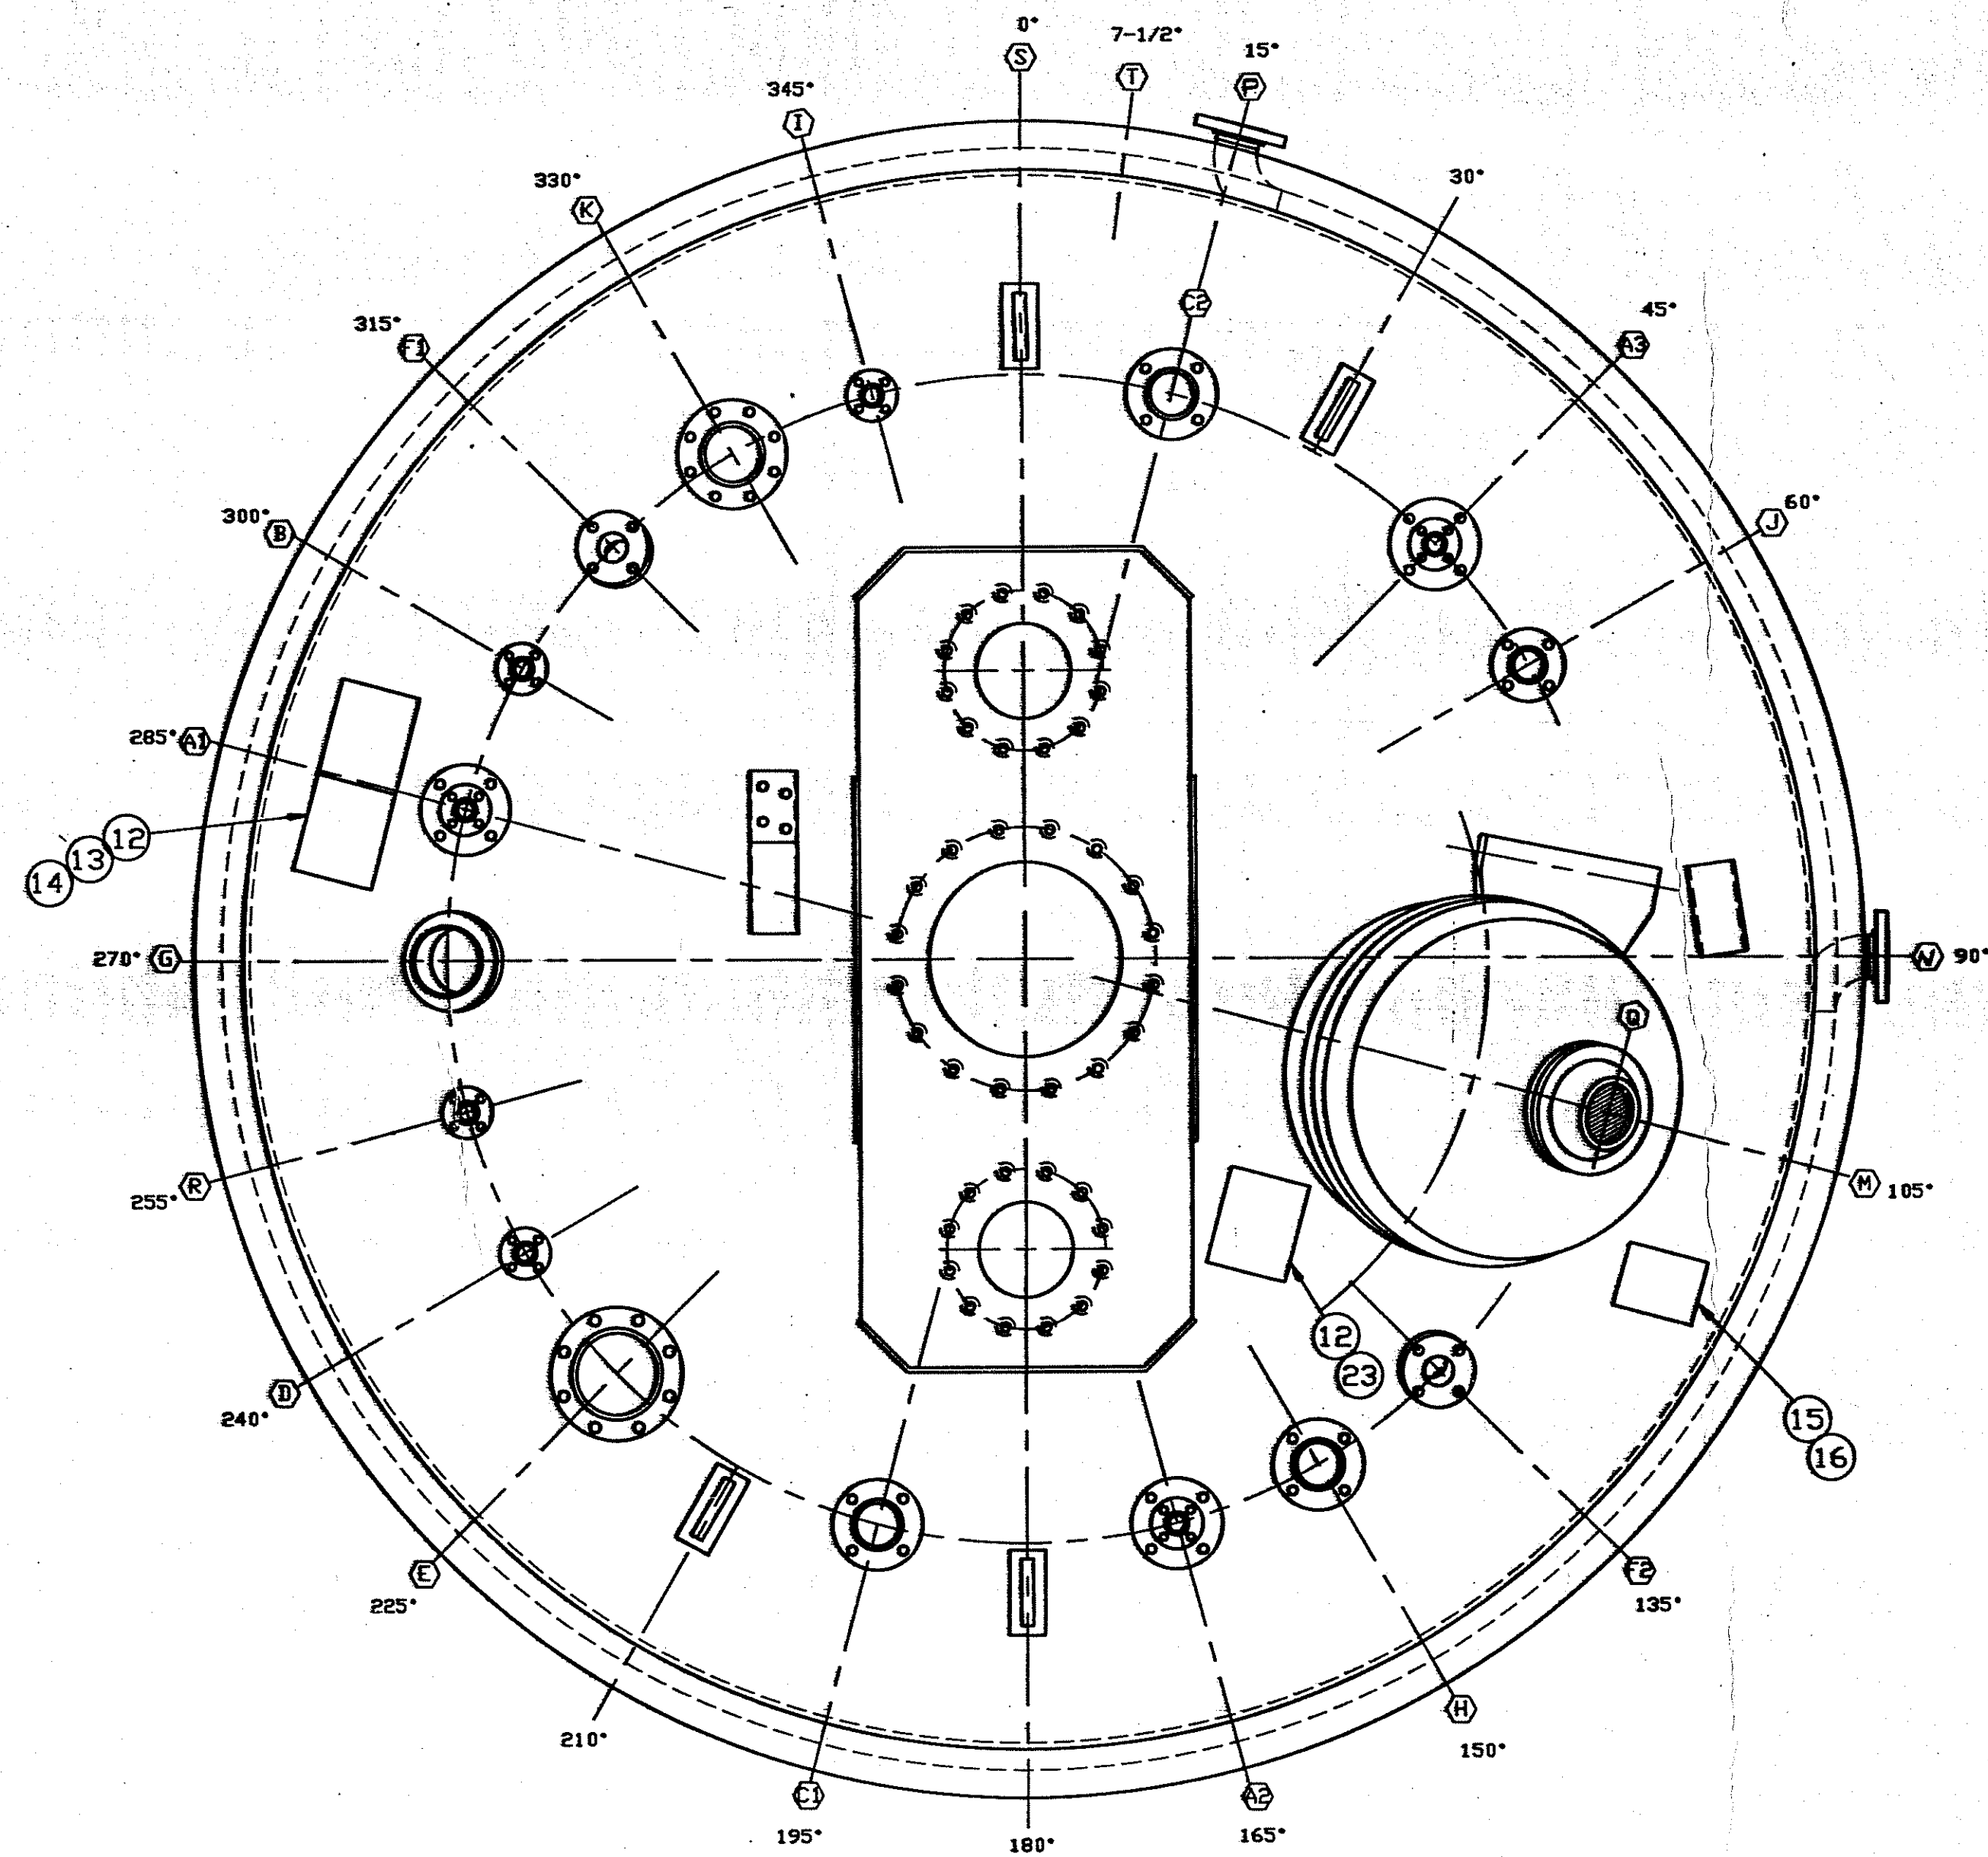


PLAN VIEW

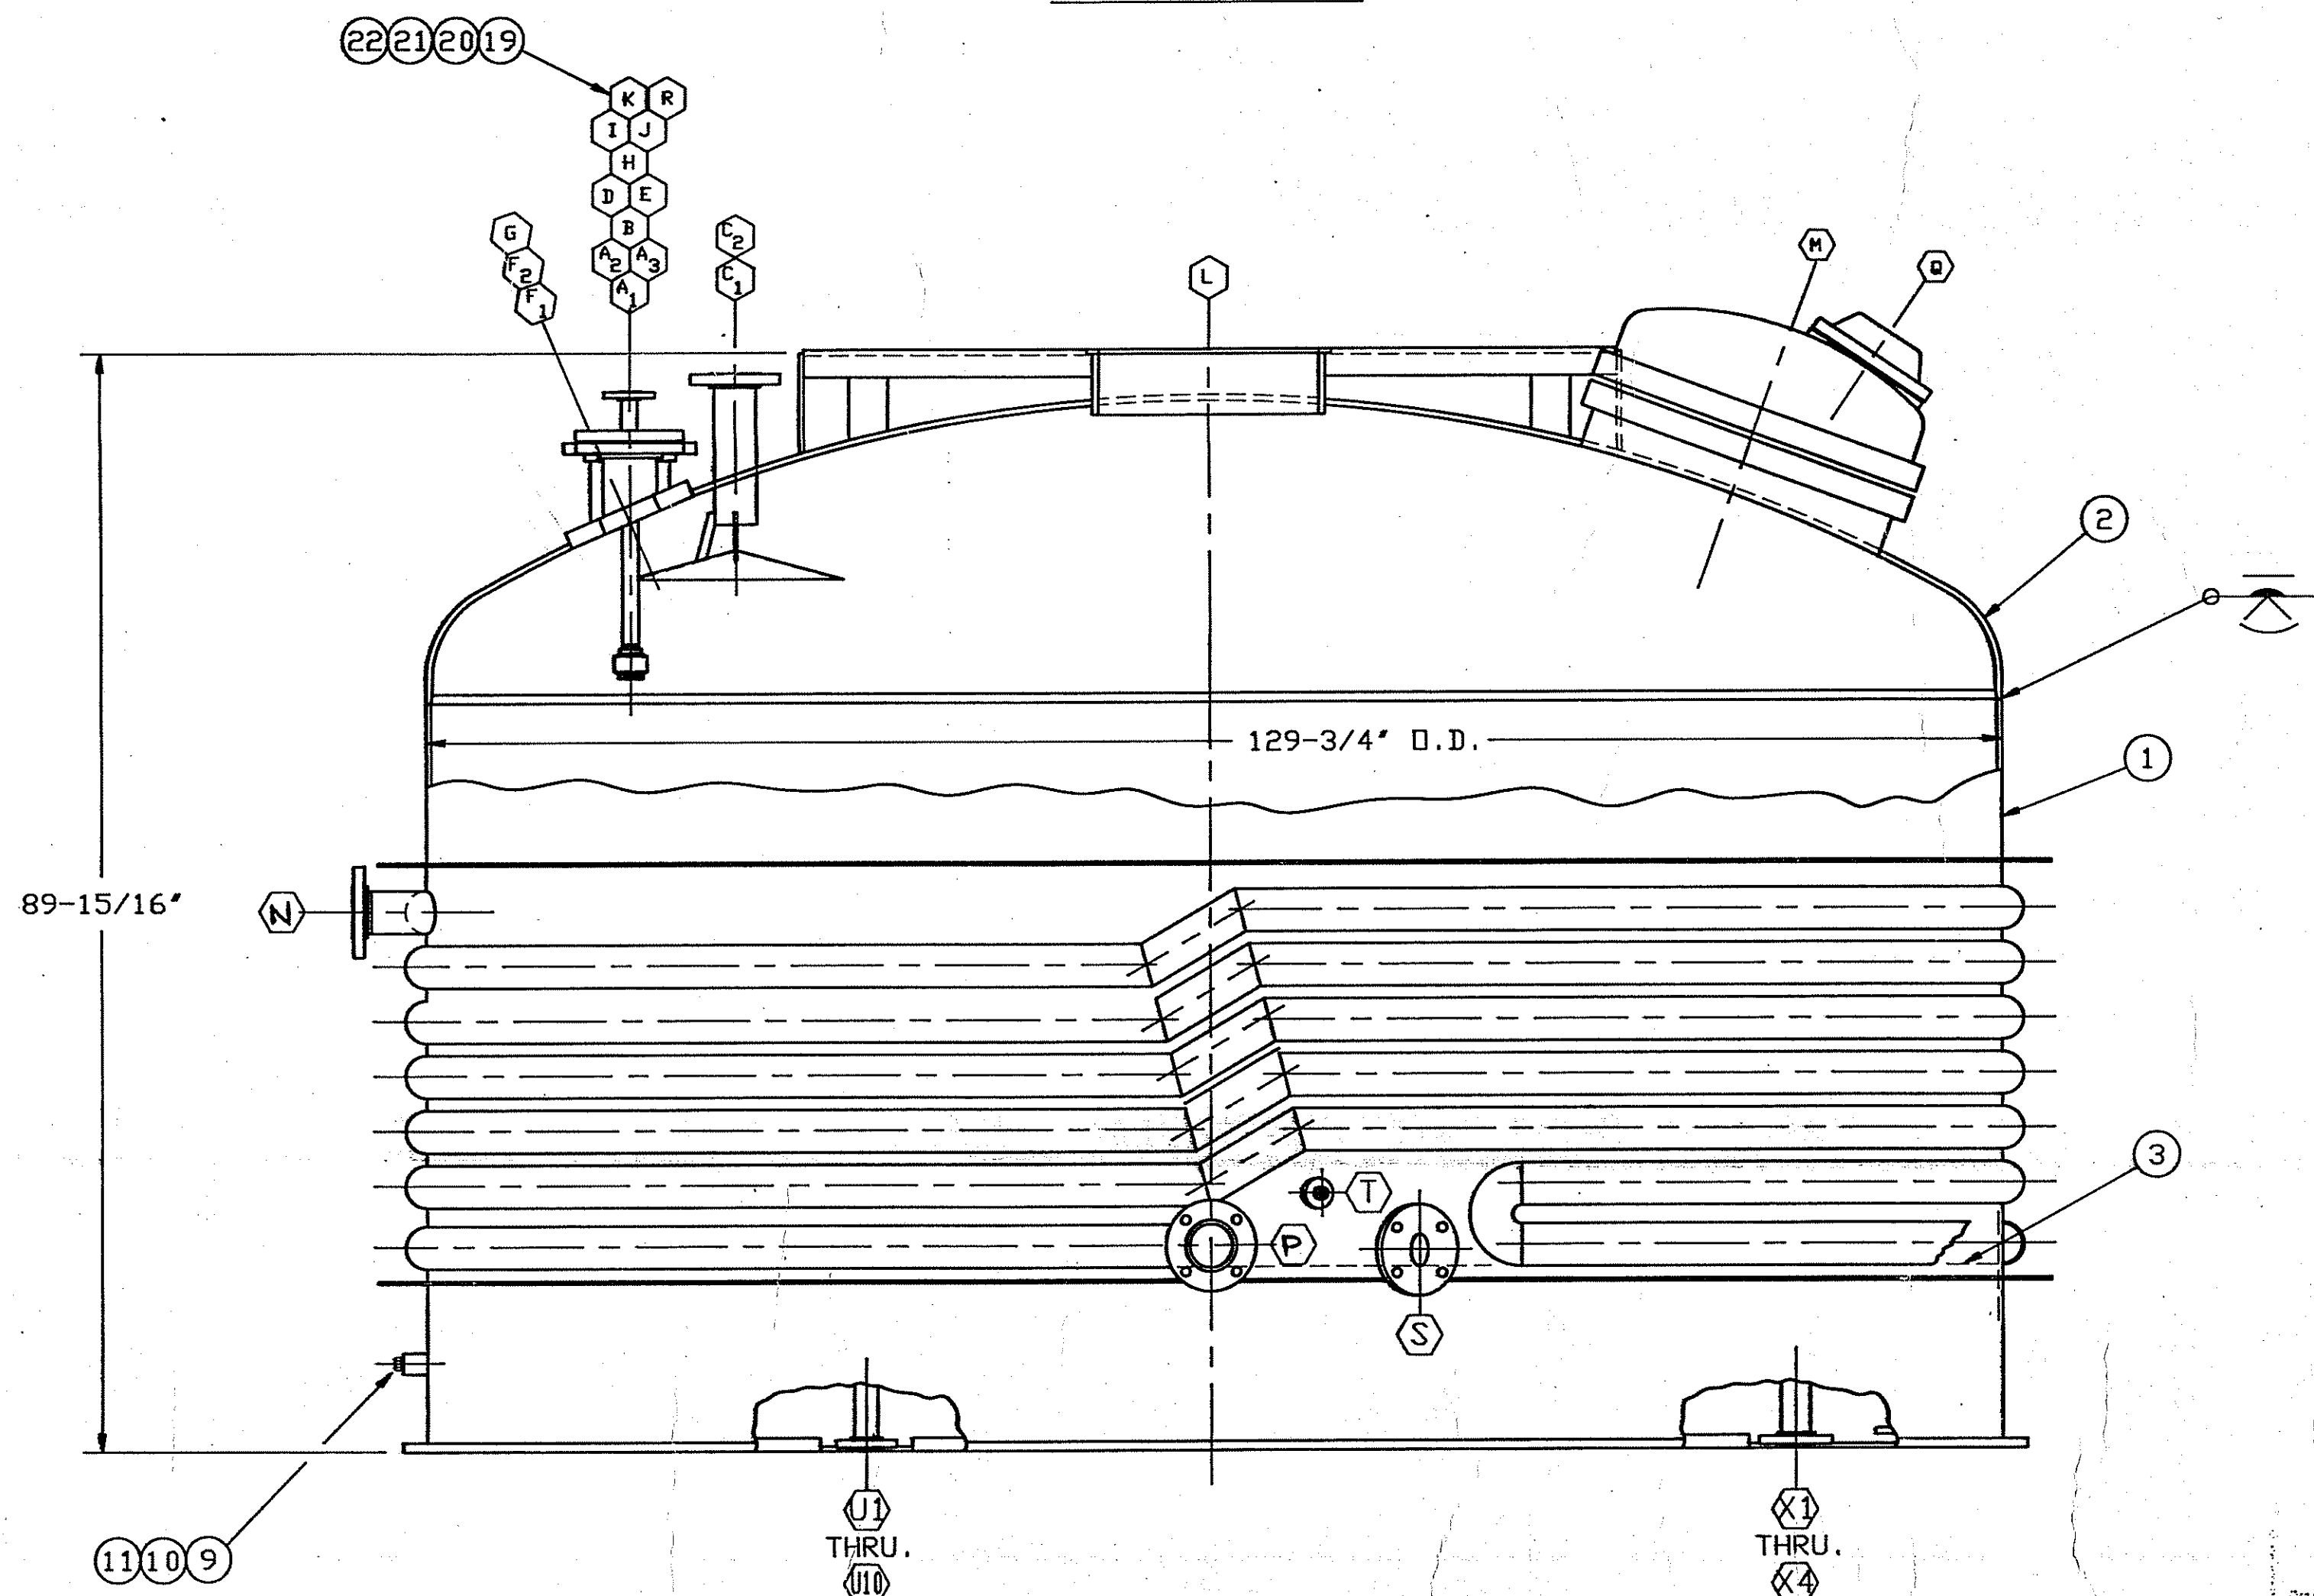

ELEVATION VIEW

SCALE: 1"=1'

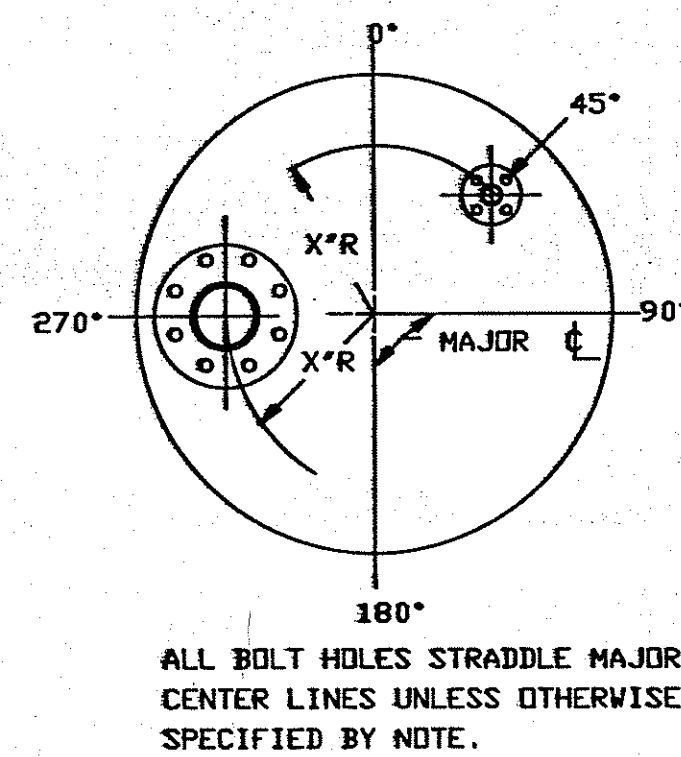

REVIEW		ASME CODE SPECIFICATION		Approval: <u>10/10/02</u>
Date:		Date:	<u>3/5/91</u>	
SHELLSIDE OR VESSEL		TUBESIDE OR JACKET		
DESIGN CONDITIONS:	50 PSIG -20/370 °F	DESIGN CONDITIONS:	150 PSIG -20/370 °F	
OPERATING CONDITIONS:	30 in HG -20/370 °F	OPERATING CONDITIONS:	30 in HG -20/370 °F	
CORROSION ALLOWANCE: NONE		CORROSION ALLOWANCE: NONE		
HYDROSTATIC TEST PRESSURE: 7.5 P.S.I.G.		HYDROSTATIC TEST PRESSURE: 240 P.S.I.G.		
RADIOGRAPHY: (SEE NOTE #9) NONE		RADIOGRAPHY: NONE		
POST WELD H.T.: NONE		POST WELD H.T.: NONE		
JOINT EFF. HEAD: 1.0		JOINT EFF. HEAD: 1.0		
SHELL: 0.7		SHELL: 0.7		
MATERIALS		MATERIALS		
SHELL: SA-240 304		SHELL: SA-240 304		
HEAD: SA-240 304		HEAD: SA-240 304		
FLANGES: SA-182 304		FLANGES: SA-182 304		
BOLTING: SA-193-B7 (CAD PLATED)		BOLTING: SA-193-B7 (CAD PLATED)		
GASKET: JETON ENCAP. VITON/EPDM		GASKET: JETON ENCAP. VITON/EPDM		
INTERVALS: 30°F		INTERVALS: 30°F		
SUPPORT: SA-36 C.S.		SUPPORT: SA-36 C.S.		
INSULATION: NONE		INSULATION: NONE		
PAINTING: SEE NOTE #8		PAINTING: SEE NOTE #8		
SHIPPING WEIGHT: 18000 LBS.		WEIGHT FULL OF WATER: 42,000 LBS.		

TRAVELER No. R3
PARA. UHA-51, USC-66(a), UG-20(f)
CALC. ASSY No. CA-RB-E

- NOTES:
- ALL NOZZLES TO BE COVERED PRIOR TO SHIPPING VESSEL.
 - THIS VESSEL DESIGNED FOR NON LETHAL SERVICE.
 - 1/8 NPT WEEP HOLES TO BE AT LOWEST POINT WHERE INDICATED.
 - FURNISH CUSTOMER WITH 2 SETS OF MILL TEST REPORTS.
 - REMOVE ALL BURRS, WELDS, SLAG, GREASE AND BREAK SHARP EDGES.
 - PROTECT GASKET SURFACES AND POLISHED MATERIAL SURFACES AT ALL TIMES.
 - ALL INTERIOR WELDS BELOW KR AND ABOVE FILTER PLATES TO BE FLUSH.
 - BEAD BLAST ALL EXTERIOR SURFACES AND APPLY (1) COAT OF SHERVIN-VILLIAMS E65A4 GRAY POLYANE PRIMER-SEALER MAX MIL. DFT. AND (2) COAT OF SHERVIN-VILLIAMS POLANE B, No. F63BX-L2270-4373 (ROSENMUND BLUE No.2, MAX MIL. DFT. TO ALL C.S. SURFACES.
 - SPOT X-RAY BOTTOM HEAD E=85, FULL X-RAY TOP HD. E=1.0, SPOT X-RAY TOP HD. TO SHELL JOINT.
 - FABRICATE PER ROSENMUND SPEC. MES-15175 REV. 3
 - SWEPT INFO: MAX. DEV. = .29%, CHORD = 20.64, RADIUS = 64.875
 - DESIGN PER SEISMIC ZONE 2A.
 - THE HEATED FILTER BED CHAMBER IS NOT INCLUDED IN THE CODE STAMPING AND CERTIFICATION.

***16, BLUE #2 POLANE B.							
***15, GRAY POLANE SEALER.							
34	3600609	B-3600609	TEMPLATE-FILTER CLOTH (CENTER)	B/M		1	EA
33	3600608	B-3600608	TEMPLATE-SUPPORTING SCREEN (CENTER)	B/M		1	EA
32	3600607	B-3600607	TEMPLATE-METAL FILTER CLOTH (CENTER)	B/M		2	EA
31	3600606	B-3600606	TEMPLATE-FILTER CLOTH (MIDDLE)	B/M		1	EA
30	3600605	B-3600605	TEMPLATE-SUPPORTING SCREEN (MIDDLE)	B/M		1	EA
29	3600604	B-3600604	TEMPLATE-METAL FILTER CLOTH (MIDDLE)	B/M		2	EA
28	3600603	B-3600603	TEMPLATE-FILTER CLOTH (END)	B/M		1	EA
27	3600602	B-3600602	TEMPLATE-SUPPORTING SCREEN (END)	B/M		1	EA
26	3600601	B-3600601	TEMPLATE-METAL FILTER CLOTH (END)	B/M		2	EA
25			TEMPLATES 8m2 P/N 9126248				
24							
23			NAMEPLATE, ROSENMUND (FURN. BY ROSENMUND)			1	EA
22	9115372		NUT, HEX 5/8-NC (CBA. PLATED)	SA-194-2H	CS	16	EA
21	9106282		STUD, THRD 5/8-NC X 5-1/2 LG. (CAD. PLATED)	SA-193-37	CS	8	EA
20	9103494		GASKET, 1/8 THK. X 4-1/2 ID X 6-7/8 OD	TEF.		2	EA
19	0100460		FLANGE, BLIND 6 150# ANSI	SA-182	304	1	EA
18	9125085		PAINT, SHERVIN-WILLIAMS #F63BX-C2277-4373 **			1	GAL.
17	9125084		PAINT, SHERVIN-WILLIAMS #F6584 **			1	GAL.
16	7825410		NAMEPLATE, WARNING		304	1	EA
15	7825410	B-7825410	BRACKET, NAMEPLATE		304	1	EA
14	7005261		NAMEPLATE, G.C.D.M.C. FAB. DIV.		304	1	EA
13	7005273	B-7005273	NAMEPLATE, ASME		304	1	EA
12	1610406	B-1610406	BRACKET, NAMEPLATE		304	3	EA
11	6605912		WASHER PLAIN FLAT 1/2"		304	1	EA
10	6605937		WASHER, LOCK 1/2"		304	1	EA
9	6605077		BOLT, HEX 1/2"-13 NC X 1" LG.		304	1	EA
8							
7							
6							
5							
4	9126248		TEMPLATES 8m2	B/M		1	EA
3	3600593	E-3600593	FILTER PLATE ASSEMBLY 8m2	B/M		1	EA
2	3600591	E-3600591	HEAD ASSEMBLY 8m2	B/M		1	EA
1	3600590	E-3600590	BASE & SHELL ASSEMBLY 8m2	B/M		1	EA
				MATERIAL	NAT'L		EA

X1-X4	4	2'	150#	RFSO	40	BASE HEAT IN/OUT
U1-U10	10	1-1/2"	150#	RFSO	40	FILTRATE OUT
T	1	1/2"	—	—	—	THERMOWELL W/PLUG
S	1	3'	150#	PAD	40	SLURRY DUT
R	1	1'	150#	RFSO	40	HEADER VENT
Q	1	6'	150#	WELD-IN	—	SIGHTGLASS
P	1	3"	150#	RFSO	40	JACKET DUT
N	1	3'	150#	RFSO	40	JACKET IN
M	1	26-1/2"	50#	PLATE	.500	MANWAY
L	1	13-3/16"	—	—	—	AGITATOR
K	1	4'	150#	RFSO	40	SPARE W/BLIND
J	1	2"	150#	RFSO	40	STEAM
I	1	2"	150#	RFSO	40	WATER
H	1	3'	150#	RFSO	40	VENT
G	1	6'	150#	WELD-IN	—	SIGHTGLASS
F1-F2	2	2'	150#	PAD	40	LIGHT CONNECTION
E	1	6'	150#	RFSO	40	SAFETY RELIEF
D	1	1"	150#	RFSO	40	PRESSURE GAUGE
C1-C2	2	3"	150#	RFSO	40	PRODUCT INLET
B	1	1'	150#	RFSO	40	PRESSURIZATION
A1-A3	3	3/4"/3"	150#	RFSO	40	WASH-SPRAY BALLS
No.	QTY.	SIZE	RATING	TYPE	SCHD.	SERVICE/DESCRIPTION

NOZZLE SCHEDULE

NOZZLE SCHEDULE


FABRICATION DIVISION NAMEPLATE	
Serial No.	F-80816A-191-1
Size	8m2
Material	SA-240 304
Customer	P.D. No. 1747
Item No.	C-5100

GASTON COUNTY FABRICATION
A DIVISION OF GASTON COUNTY DYING MACHINE COMPANY
STANLEY, NORTH CAROLINA 28153-4765


CUSTOMER ROSENMUND INC., CHARLOTTE, N.C.
FOR SDFIX CORP.

TITLE	FINAL ASSEMBLY 8m2
CUSTOMER P.D. NO. 747	CUSTOMER ITEM NO. C-5100
DRAWN BY G.M.	DATE 1/23/91
SHOP ORDER NO. F-80816A	NO. REQUIRED 1
SCALE 1"=12"	REV. 1
No. F-3600589	B


CAD REFERENCE NO. RD00152A

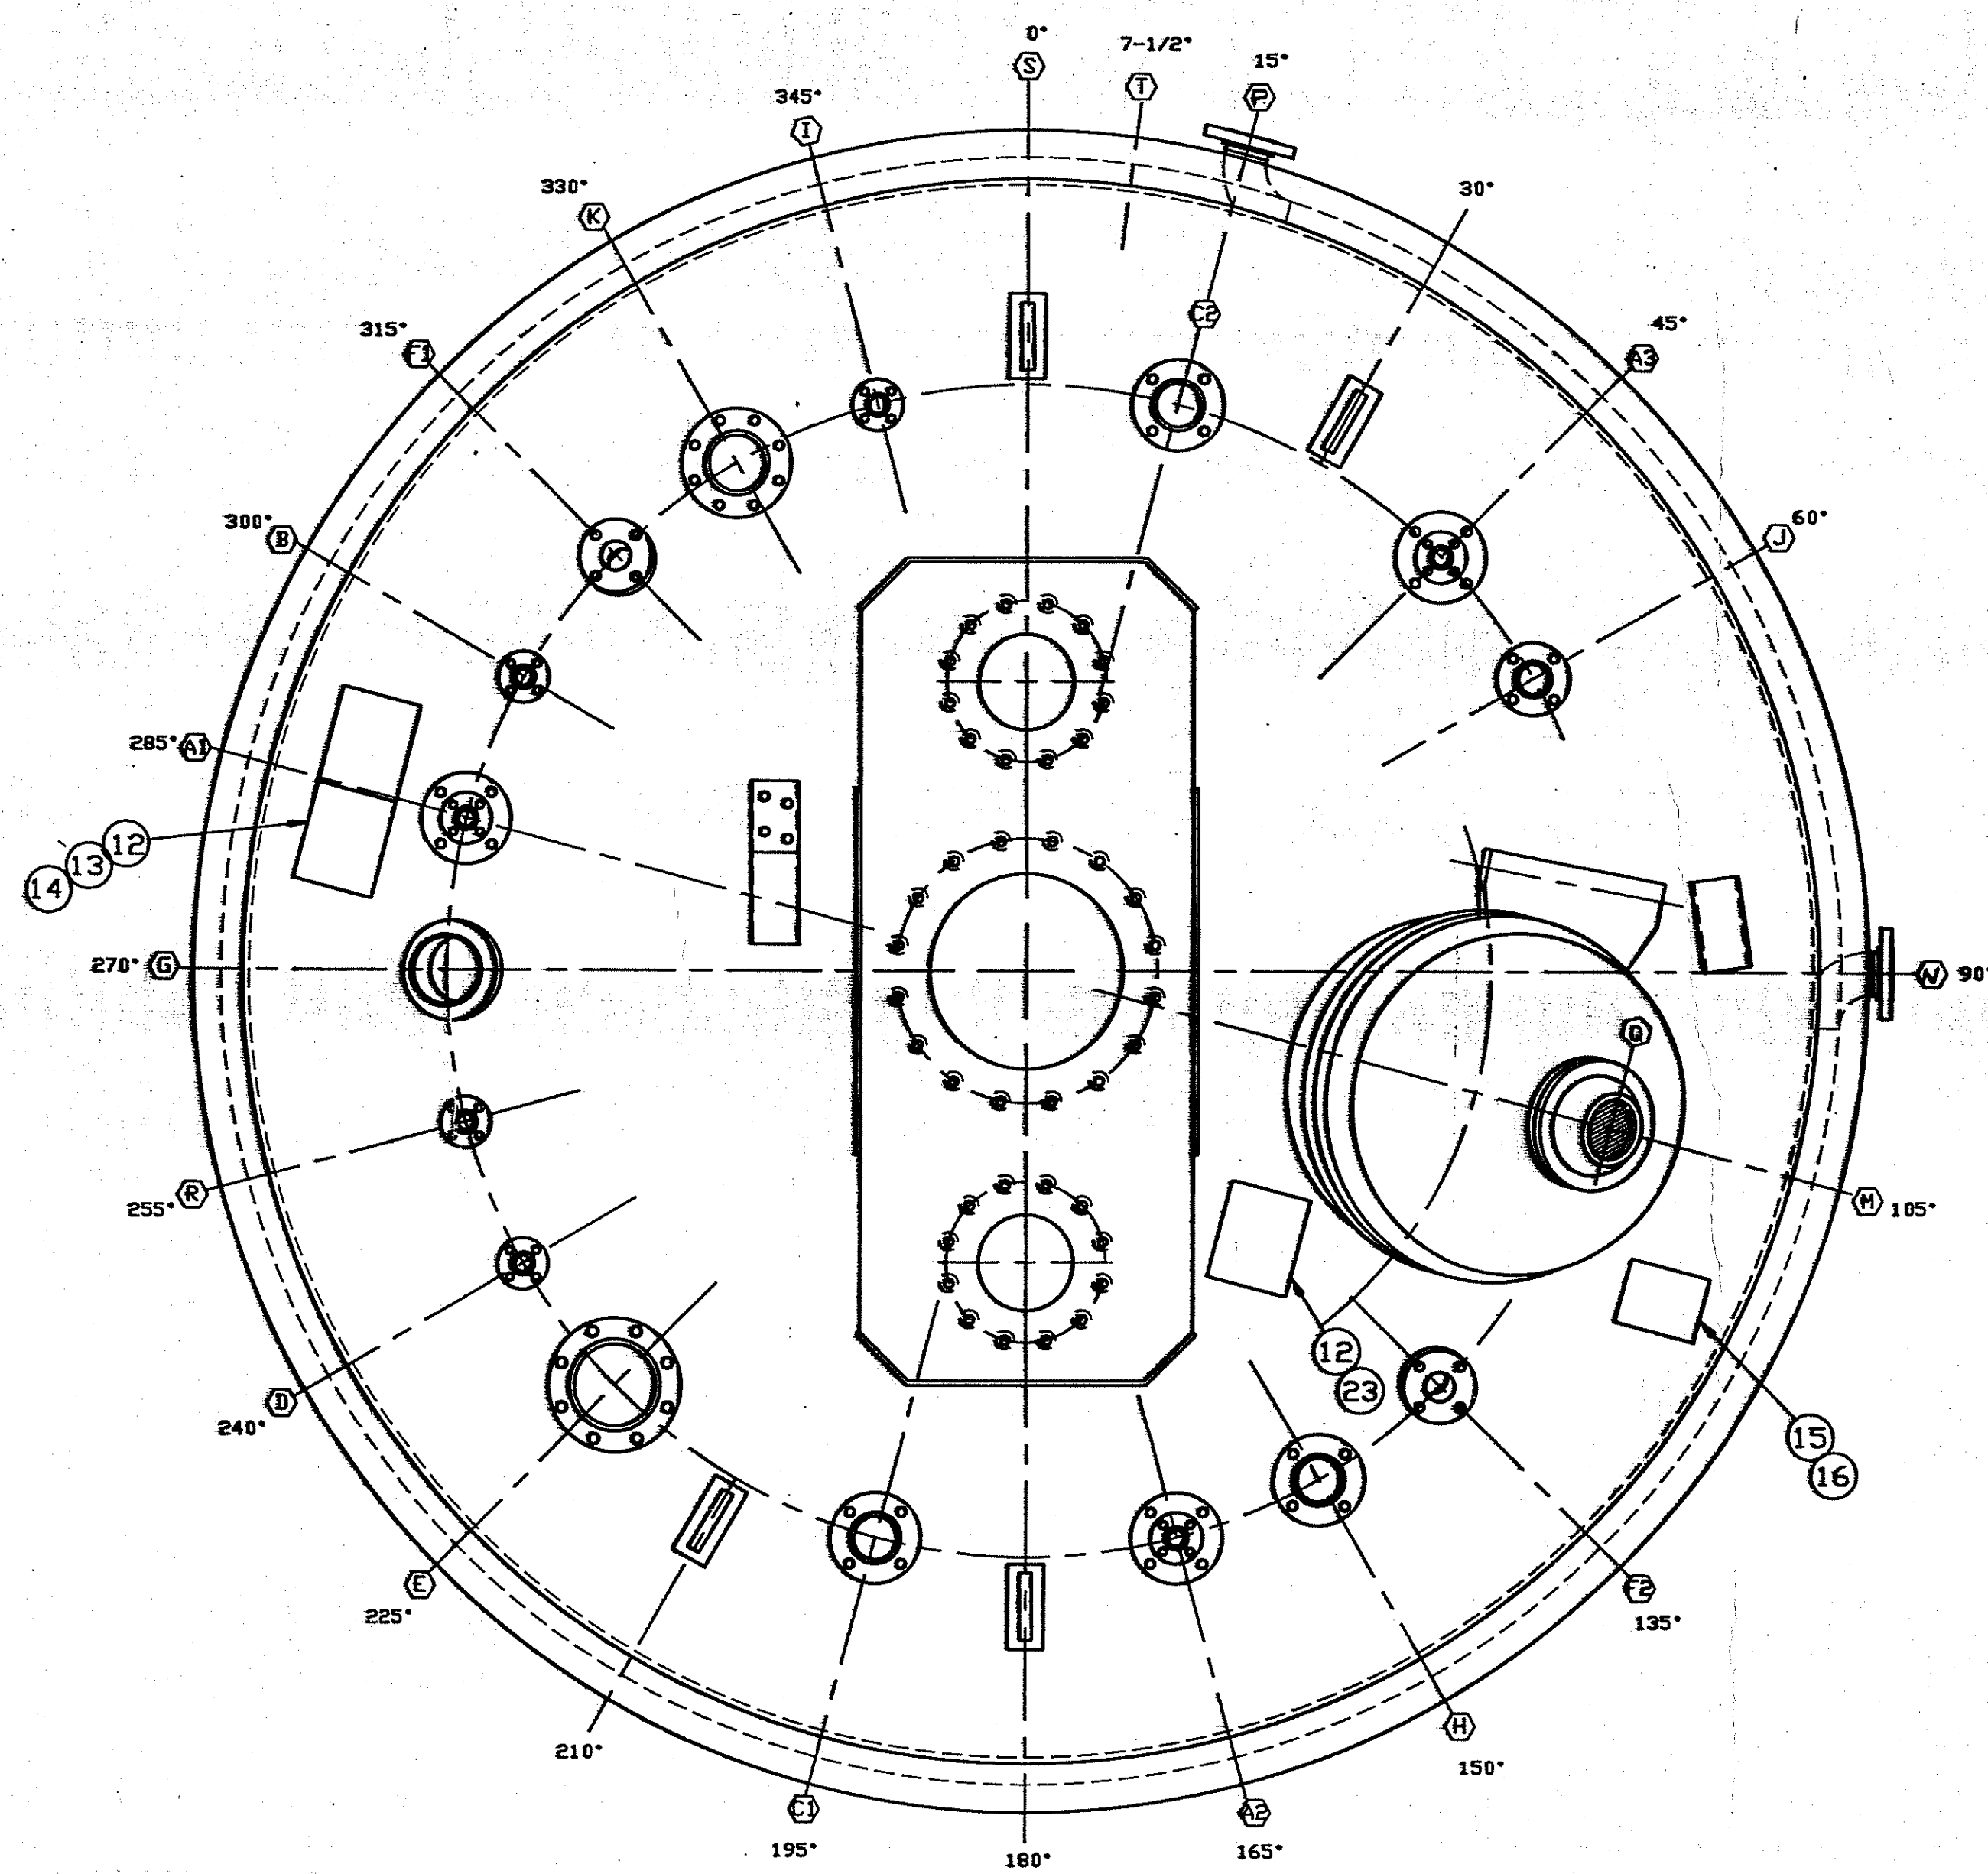

PLAN VIEW

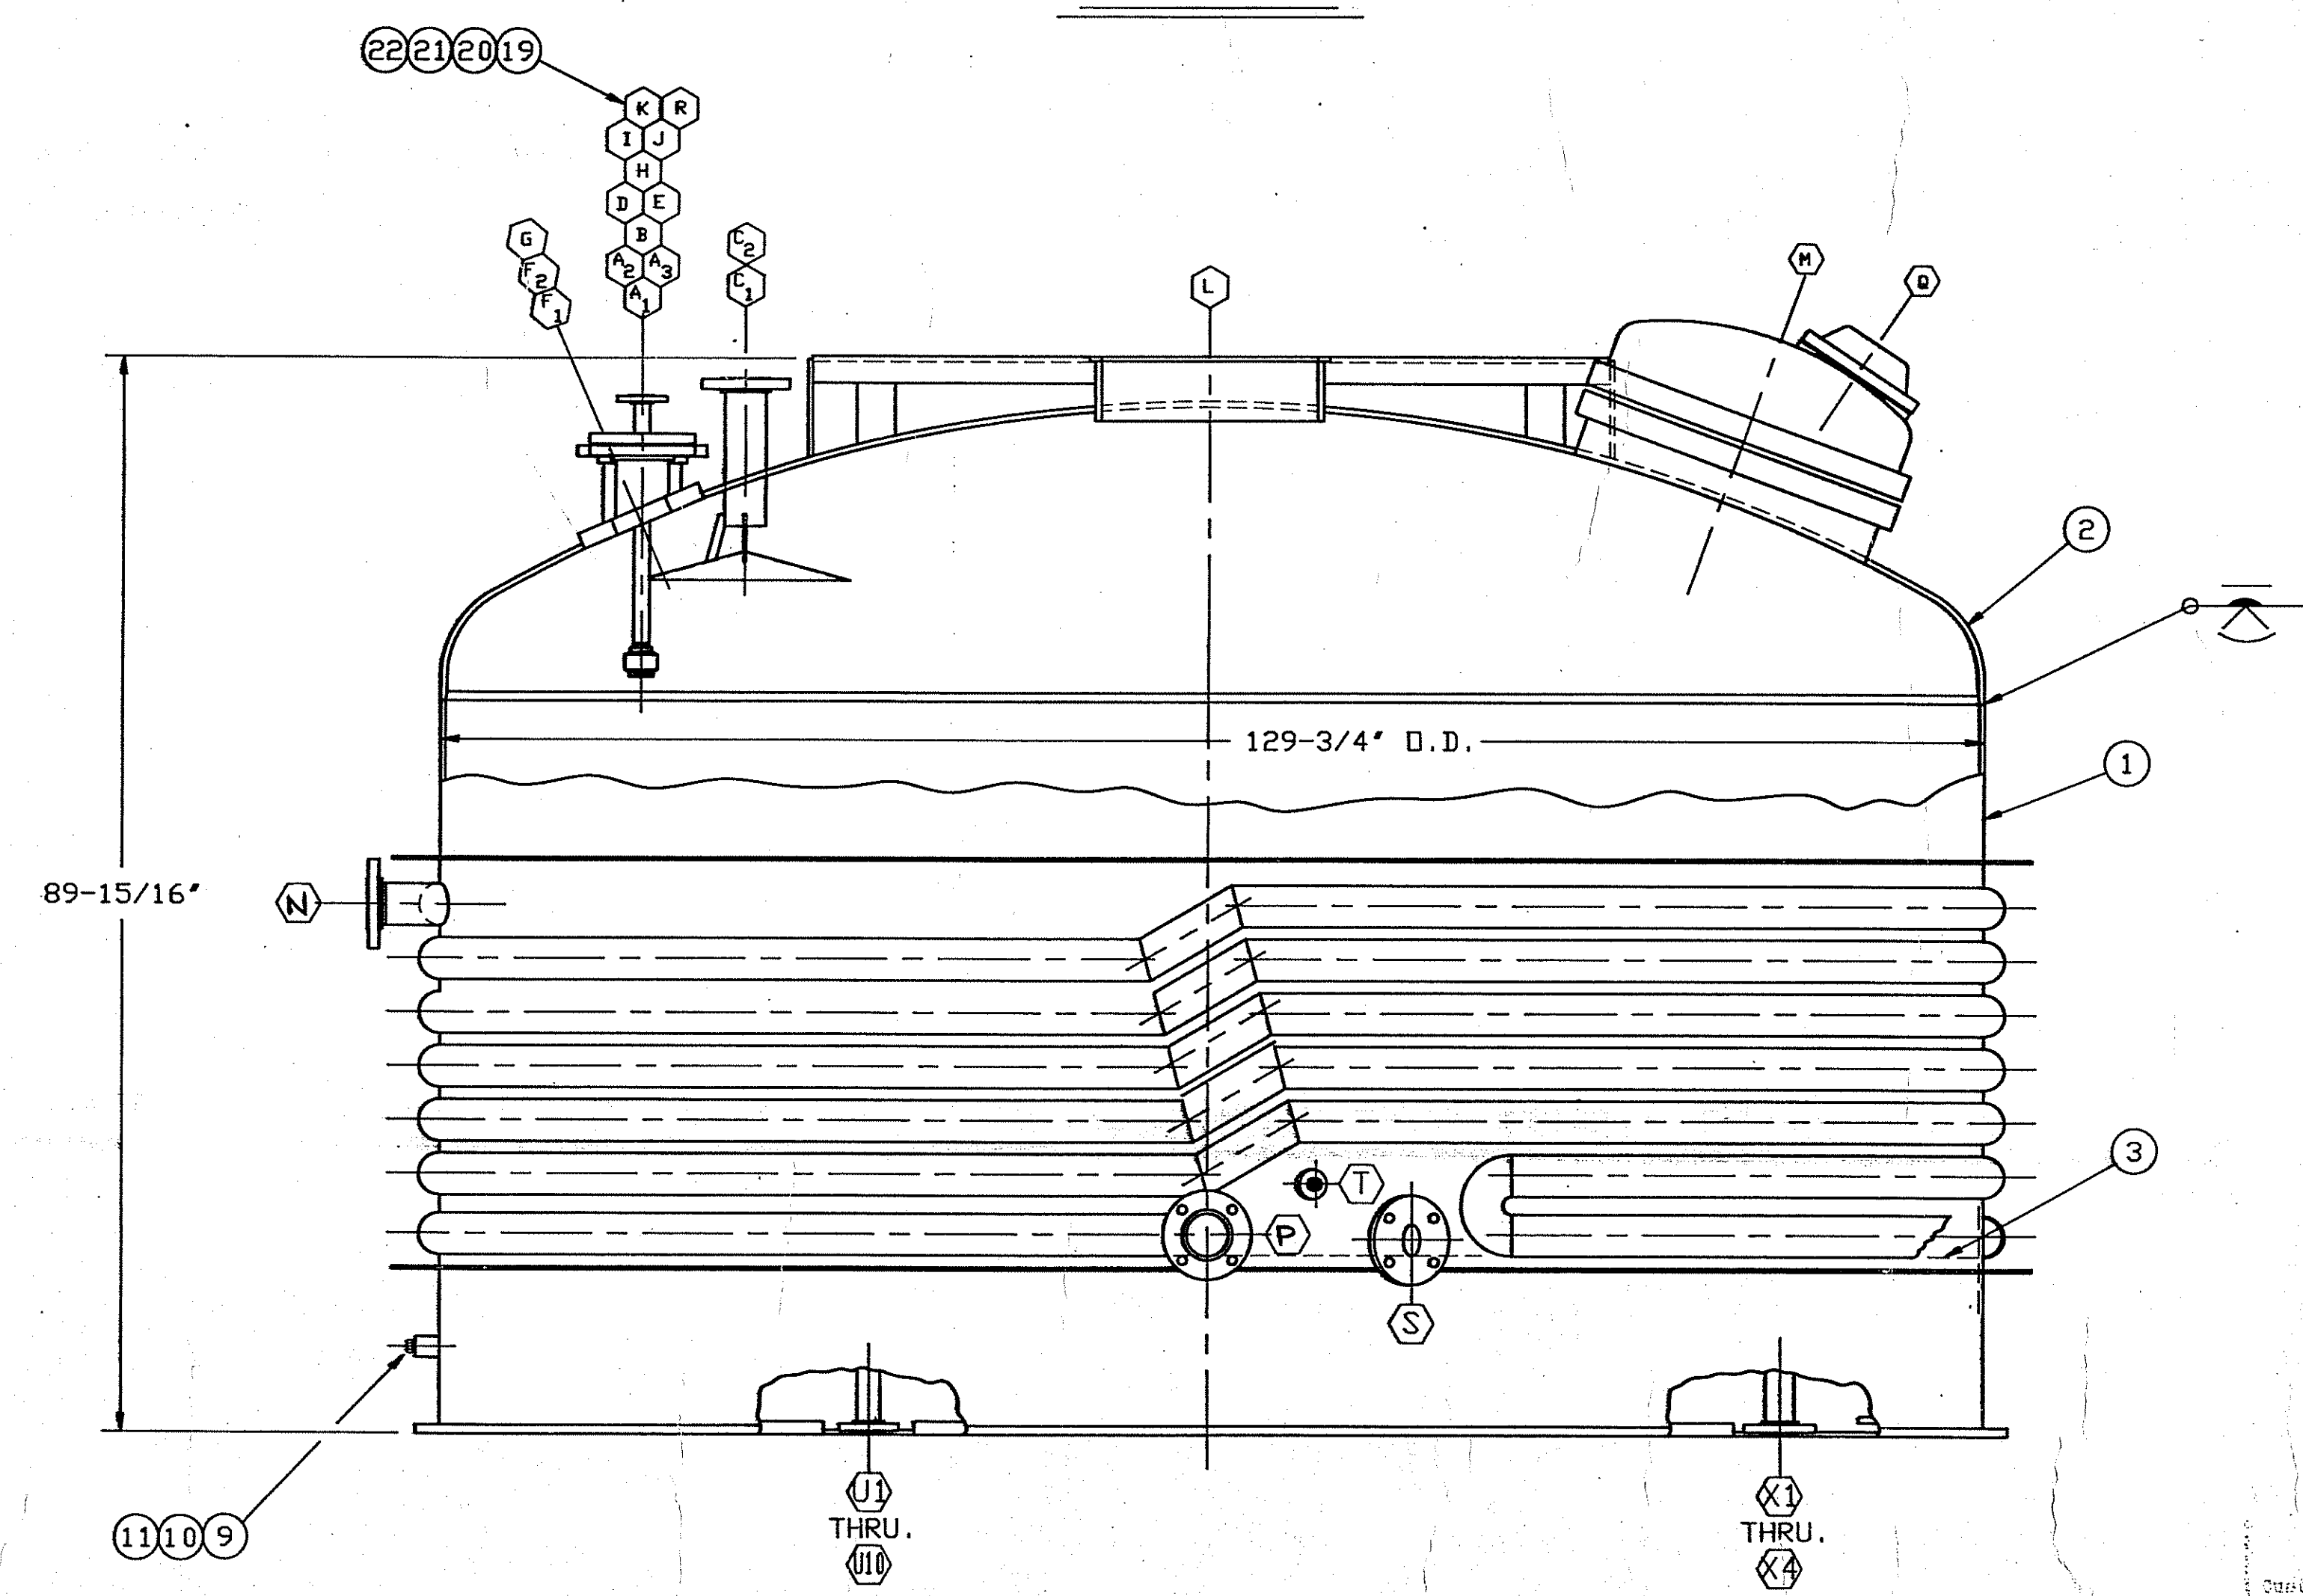

ELEVATION VIEW
SCALE: 1"=1'

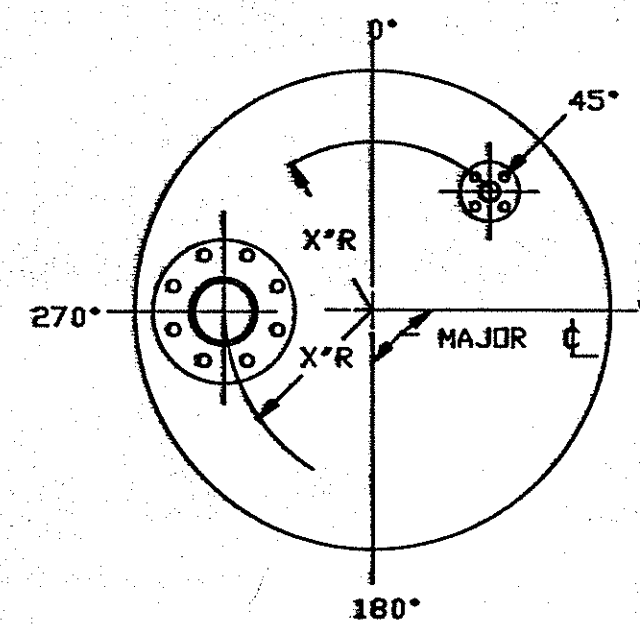

ALL BOLT HOLES STRADDLE MAJOR CENTER LINES UNLESS OTHERWISE SPECIFIED BY NOTE.

ASME CODE SPECIFICATION		TUBESIDE OR JACKET	
DESIGN CONDITIONS:	50 PSIG -20/370 °F	DESIGN CONDITIONS:	150 PSIG -20/370 °F
OPERATING CONDITIONS:	30 in HG -20/370 °F	OPERATING CONDITIONS:	30 in HG -20/370 °F
CORROSION ALLOWANCE:	NONE	CORROSION ALLOWANCE:	NONE
HYDROSTATIC TEST PRESSURE:	75 P.S.I.G.	HYDROSTATIC TEST PRESSURE:	240 P.S.I.G.
RADIOGRAPHY:	SEE NOTE #92 NONE	RADIOGRAPHY:	NONE
POST WELD H.T.:	NONE	POST WELD H.T.:	NONE
JOINT EFF. HEAD:	1.0	JOINT EFF. HEAD:	NONE
SHELL:	0.7	SHELL:	NONE
MATERIALS:		MATERIALS:	
SHELL:	SA-240 304	SHELL:	SA-240 304
HEAD:	SA-240 304	HEAD:	SA-240 304
FLANGES:	SA-182 304	FLANGES:	SA-182 304
BOLTING:	SA-193-B7 (CAD PLATED)	BOLTING:	SA-193-B7 (CAD PLATED)
GASKET:	TEFLON DONUT, VITON/SPM	GASKET:	TEFLON DONUT, VITON/SPM
INTERNAL:	304	INTERNAL:	304
SUPPORT:	SA-36 C.S.	SUPPORT:	SA-36 C.S.
INSULATION:	NONE	INSULATION:	NONE
PAINTING:	SEE NOTE #8	PAINTING:	SEE NOTE #8
SHIPPING WEIGHT:	18000 LBS.	WEIGHT FULL OF WATER:	42,000 LBS.

- TRAVELER No. R3
PARA. UHA-51, USC-66(a), UG-20(a)
CALC. ASSY No. CA-R8-E
- NOTES:
- ALL NOZZLES TO BE COVERED PRIOR TO SHIPPING VESSEL.
 - THIS VESSEL DESIGNED FOR NON LETHAL SERVICE.
 - 1/8 NPT WEEP HOLES TO BE AT LOWEST POINT WHERE INDICATED.
 - FURNISH CUSTOMER WITH 2 SETS OF MILL TEST REPORTS.
 - REMOVE ALL BURRS, WELDS, SLAG, GREASE AND BREAK SHARP EDGES.
 - PROTECT GASKET SURFACES AND POLISHED MATERIAL SURFACES AT ALL TIMES.
 - ALL INTERIOR WELDS BELOW KR AND ABOVE FILTER PLATES TO BE FLUSH.
 - BEAD BLAST ALL EXTERIOR SURFACES AND APPLY (1) COAT OF SHERVIN-WILLIAMS E6544 GRAY POLYLAME PRIMER-SEALER MAX MIL. DFT. AND (2) COAT OF SHERVIN-WILLIAMS POLANE B, No. F63BX-L2270-4373 (ROSENMUND BLUE No.2, MAX MIL. DFT. TO ALL C.S. SURFACES.
 - SPOT X-RAY BOTTOM HEAD E=85, FULL X-RAY TOP HD. E=1.0, SPOT X-RAY TOP HD. TO SHELL JOINT.
 - FABRICATE PER ROSENMUND SPEC. RES-15175 REV. 3
 - SWEEP INFO: MAX. DEV. = .295, CHORD = 20.6%, RADIUS = 64.875
 - DESIGN PER SEISMIC ZONE 2A.
 - THE WANTED RUCKER BAYS CHAMBER IS NOT INCLUDED IN THE CODE STAMPING AND CERTIFICATION.

Paul J. Chitt
REVISED
MAY 2 1991

CERTIFIED PRINT
Charles E. Small
Customer Order No. 90-00001
Shop Order No. 90-BFJ11
ROSENMUND
Charlotte, N.C. 42691

NO.	QTY.	SIZE	RATING	TYPE	SCHD.	SERVICE/DESCRIPTION
X1-X4	4	2"	150#	RFSO	40	BASE HEAT IN/OUT
U1-U10	10	1-1/2"	150#	RFSO	40	FILTRATE OUT
T	1	1-1/2"	—	—	—	THERMOWELL W/PLUG
S	1	3"	150#	PAD	40	SLURRY OUT
R	1	1"	150#	RFSO	40	HEADER VENT
Q	1	6"	150#	WELD-IN	—	SIGHTGLASS
P	1	3"	150#	RFSO	40	JACKET OUT
N	1	3"	150#	RFSO	40	JACKET IN
M	1	26-1/2"	50#	PLATE	.500	MANWAY
L	1	13-3/16"	—	—	—	AGITATOR
K	1	4"	150#	RFSO	40	SPARE W/BLIND
J	1	2"	150#	RFSO	40	STEAM
I	1	2"	150#	RFSO	40	WATER
H	1	3"	150#	RFSO	40	VENT
G	1	6"	150#	WELD-IN	—	SIGHTGLASS
F1-F2	2	2"	150#	PAD	40	LIGHT CONNECTION
E	1	6"	150#	RFSO	40	SAFETY RELIEF
D	1	1"	150#	RFSO	40	PRESSURE GAUGE
C1-C2	2	3"	150#	RFSO	40	PRODUCT INLET
B	1	1"	150#	RFSO	40	PRESSURIZATION
A1-A3	3	3/4"	150#	RFSO	40	WASH-SPRAY BALLS
No.	QTY.	SIZE	RATING	TYPE	SCHD.	SERVICE/DESCRIPTION

NOZZLE SCHEDULE

34	3600609	B-3600609	TEMPLATE-FILTER CLOTH (CENTER)	B/H		1	EA
33	3600608	B-3600608	TEMPLATE-SUPPORTING SCREEN (CENTER)	B/H		1	EA
32	3600607	B-3600607	TEMPLATE-METAL FILTER CLOTH (CENTER)	B/H		2	EA
31	3600606	B-3600606	TEMPLATE-FILTER CLOTH (MIDDLE)	B/H		1	EA
30	3600605	B-3600605	TEMPLATE-SUPPORTING SCREEN (MIDDLE)	B/H		1	EA
29	3600604	B-3600604	TEMPLATE-METAL FILTER CLOTH (MIDDLE)	B/H		2	EA
28	3600603	B-3600603	TEMPLATE-FILTER CLOTH (END)	B/H		1	EA
27	3600602	B-3600602	TEMPLATE-SUPPORTING SCREEN (END)	B/H		1	EA
26	3600601	B-3600601	TEMPLATE-METAL FILTER CLOTH (END)	B/H		2	EA
25			TEMPLATES 8m2 P/N 9126248				
24							
23			NAMEPLATE, ROSENMUND (FURN. BY ROSENMUND)				1
22	9115372		NUT, HEX 5/8-NC (CDA, PLATED)	SA-194-2H	CS	16	EA
21	9106282		STUD, THRD 5/8-NC X 5-1/2 LG. (CAD, PLATED)	SA-193-B7	CS	8	EA
20	9103494		GASKET, 1/8 THK. X 4-1/2 ID X 6-7/8 OD	TEF.		2	EA
19	0100460		FLANGE, BLIND 6 150# ANSI	SA-182	304	1	EA
18	9125085		PAINT, SHERVIN-WILLIAMS #F63BX-C2277-4373			1	GAL.
17	9125084		PAINT, SHERVIN-WILLIAMS #E6544			1	GAL.
16	7825410		NAMEPLATE, WARNING		304	1	EA
15	7825410		BRACKET, NAMEPLATE		304	1	EA
14	7005261		NAMEPLATE, G.C.D.M.C. FAB. DIV.		304	1	EA
13	7005273		NAMEPLATE, ASME		304	1	EA
12	1604046		BRACKET, NAMEPLATE		304	3	EA
11	6605912		WASHER PLAIN FLAT 1/2"		304	1	EA
10	6605937		WASHER, LOCK 1/2"		304	1	EA
9	6605077		BOLT, HEX 1/2"-13 NC X 1" LG.		304	1	EA
8							
7							
6							
5							
4	9126248		TEMPLATES 8m2	B/H		1	EA
3	3600593	E-3600593	FILTER PLATE ASSEMBLY 8m2	B/H		1	EA
2	3600591	E-3600591	HEAD ASSEMBLY 8m2	B/H		1	EA
1	3600590	E-3600590	BASE & SHELL ASSEMBLY 8m2	B/H		1	EA

REV.	PART NO.	DRAWING NO.	MATERIAL OR DESCRIPTION	MATERIAL SPEC	QTY/PER UM
		3600589	* CUT LENGTH ON THIS B.O.M. FOR REFERENCE ONLY		
G					
F					
E					
D					
C					
B			INTERCHANGE LETTERS N/P	4-18-91	1.0m
A			CUSTOMER CHANGES, ROTATED AGITATOR PLATE AND CHANGED NOZZ C1 & C2	2/25/91 G.M.	1.0m
REV.			DESCRIPTION	DATE	BY
					CHECKED
					APPROVED

GASTON COUNTY FABRICATION
A DIVISION OF GASTON COUNTY DYING MACHINE COMPANY
STANLEY, NORTH CAROLINA 28154-4765

CUSTOMER	ROSENMUND INC., CHARLOTTE, N.C.
TITLE	FINAL ASSEMBLY 8m2
CUSTOMER P.O. NO.	747
CUSTOMER ITEM NO.	5100
DRAWN BY	G.H.
CHECKED BY	DATE
DATE	2/25/91
DATE	12/91
SHEET	1
NO. REQUIRED	1
SCALE	1"=12"
NO.	E-3600589

CAD REFERENCE NO.
RD00152A

FABRICATION DIVISION NAMEPLATE
Serial No. F-80816A-191-1
Size 8m2
Material SA-240 304
P.O. No. 1747
Customer
Item No. C-5100