




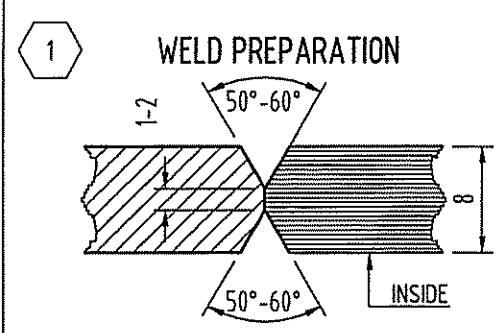


DETAIL LONG & CIRC. WELD CONE L.W. CW

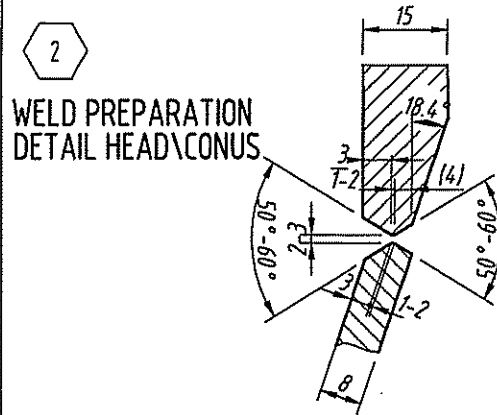


DETAIL HEAD/CONUS

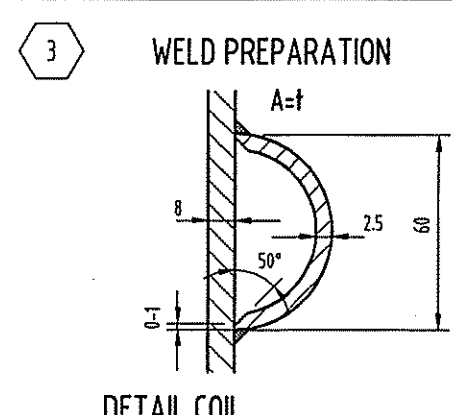


DETAIL COIL

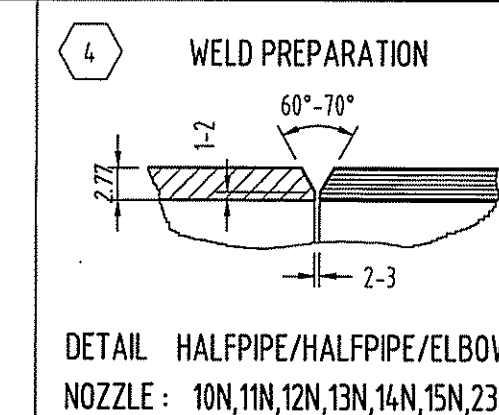


DETAIL HALFPIPE/HALFPIPE/ELBOW

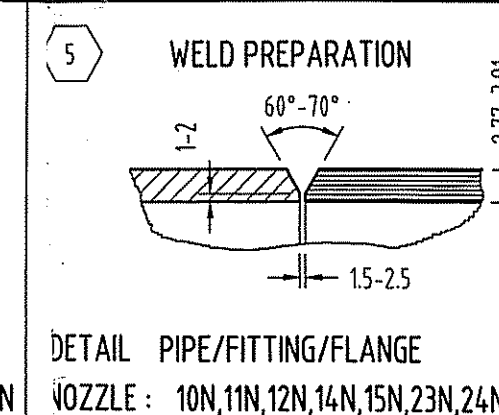


DETAIL PIPE/FITTING/FLANGE

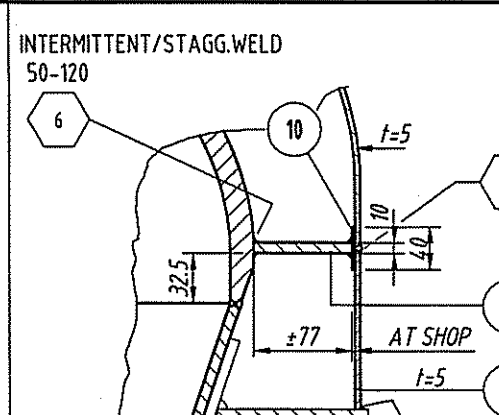


INTERMITTENT/STAGG WELD

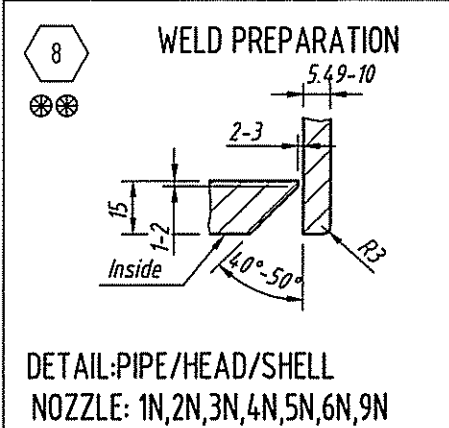


DETAIL PIPE/HEAD/SHELL

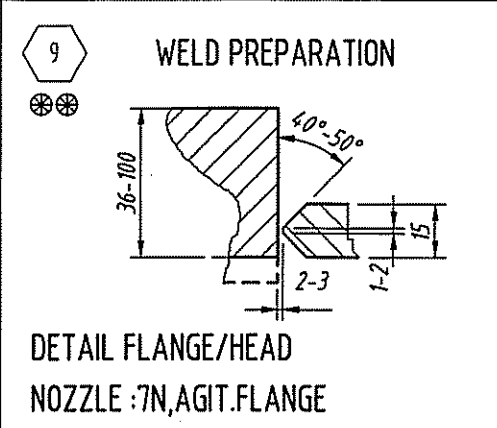


DETAIL FLANGE/HEAD

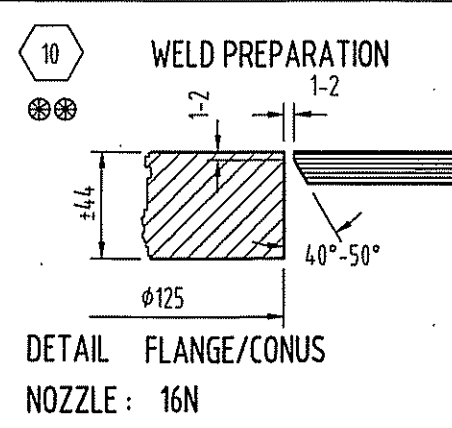


DETAIL FLANGE/CONUS

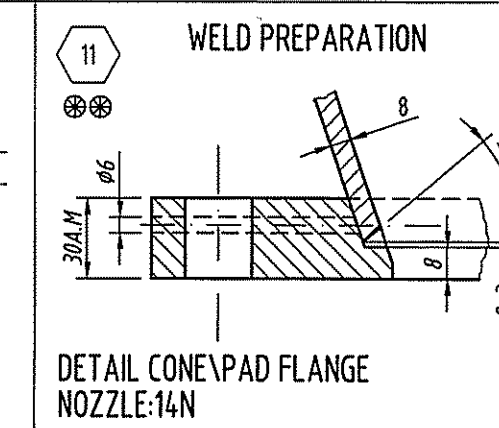

DETAIL CONE/PAD FLANGE

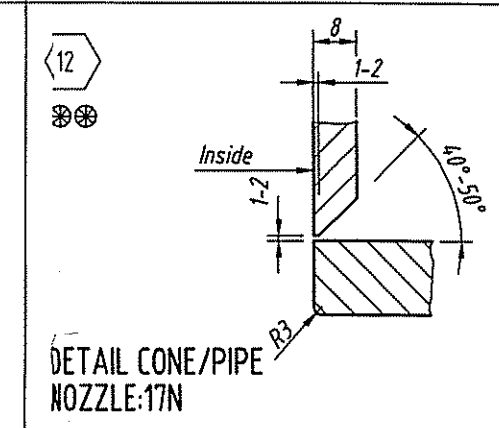


DETAIL CONE/PIPE

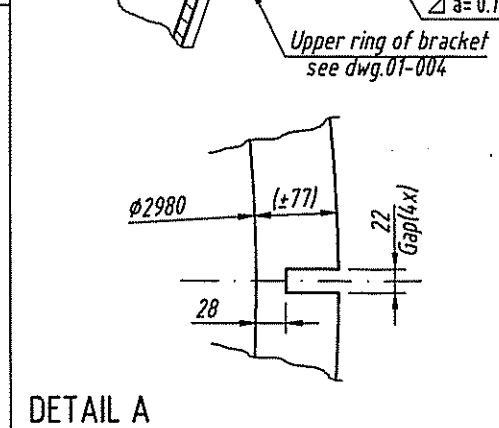


DETAIL A


TOPVIEW IS RULING FOR NOZZLE ORIENTATION
DRIVE FLANGE MUST BE $\odot 10$ TO CENTRELINE VESSEL.

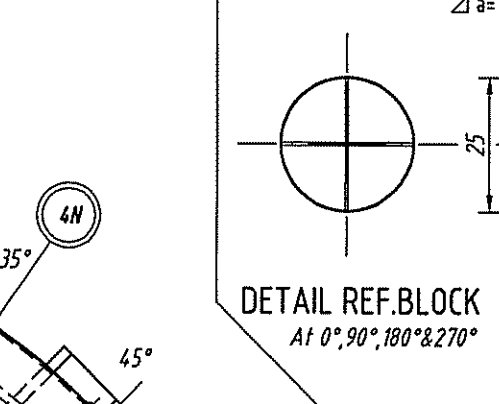



DETAIL REF. BLOCK

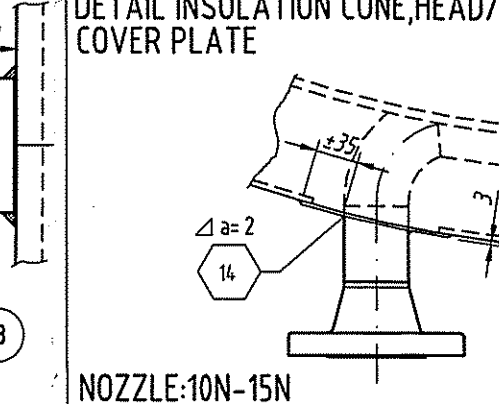










DETAIL INSULATION CONE/HEAD/COVER PLATE

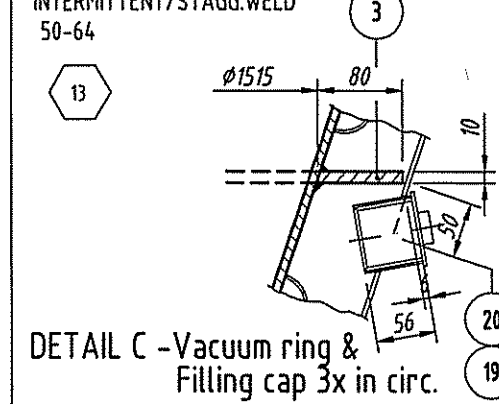

DETAIL C - Vacuum ring & Filling cap 3x in circ.

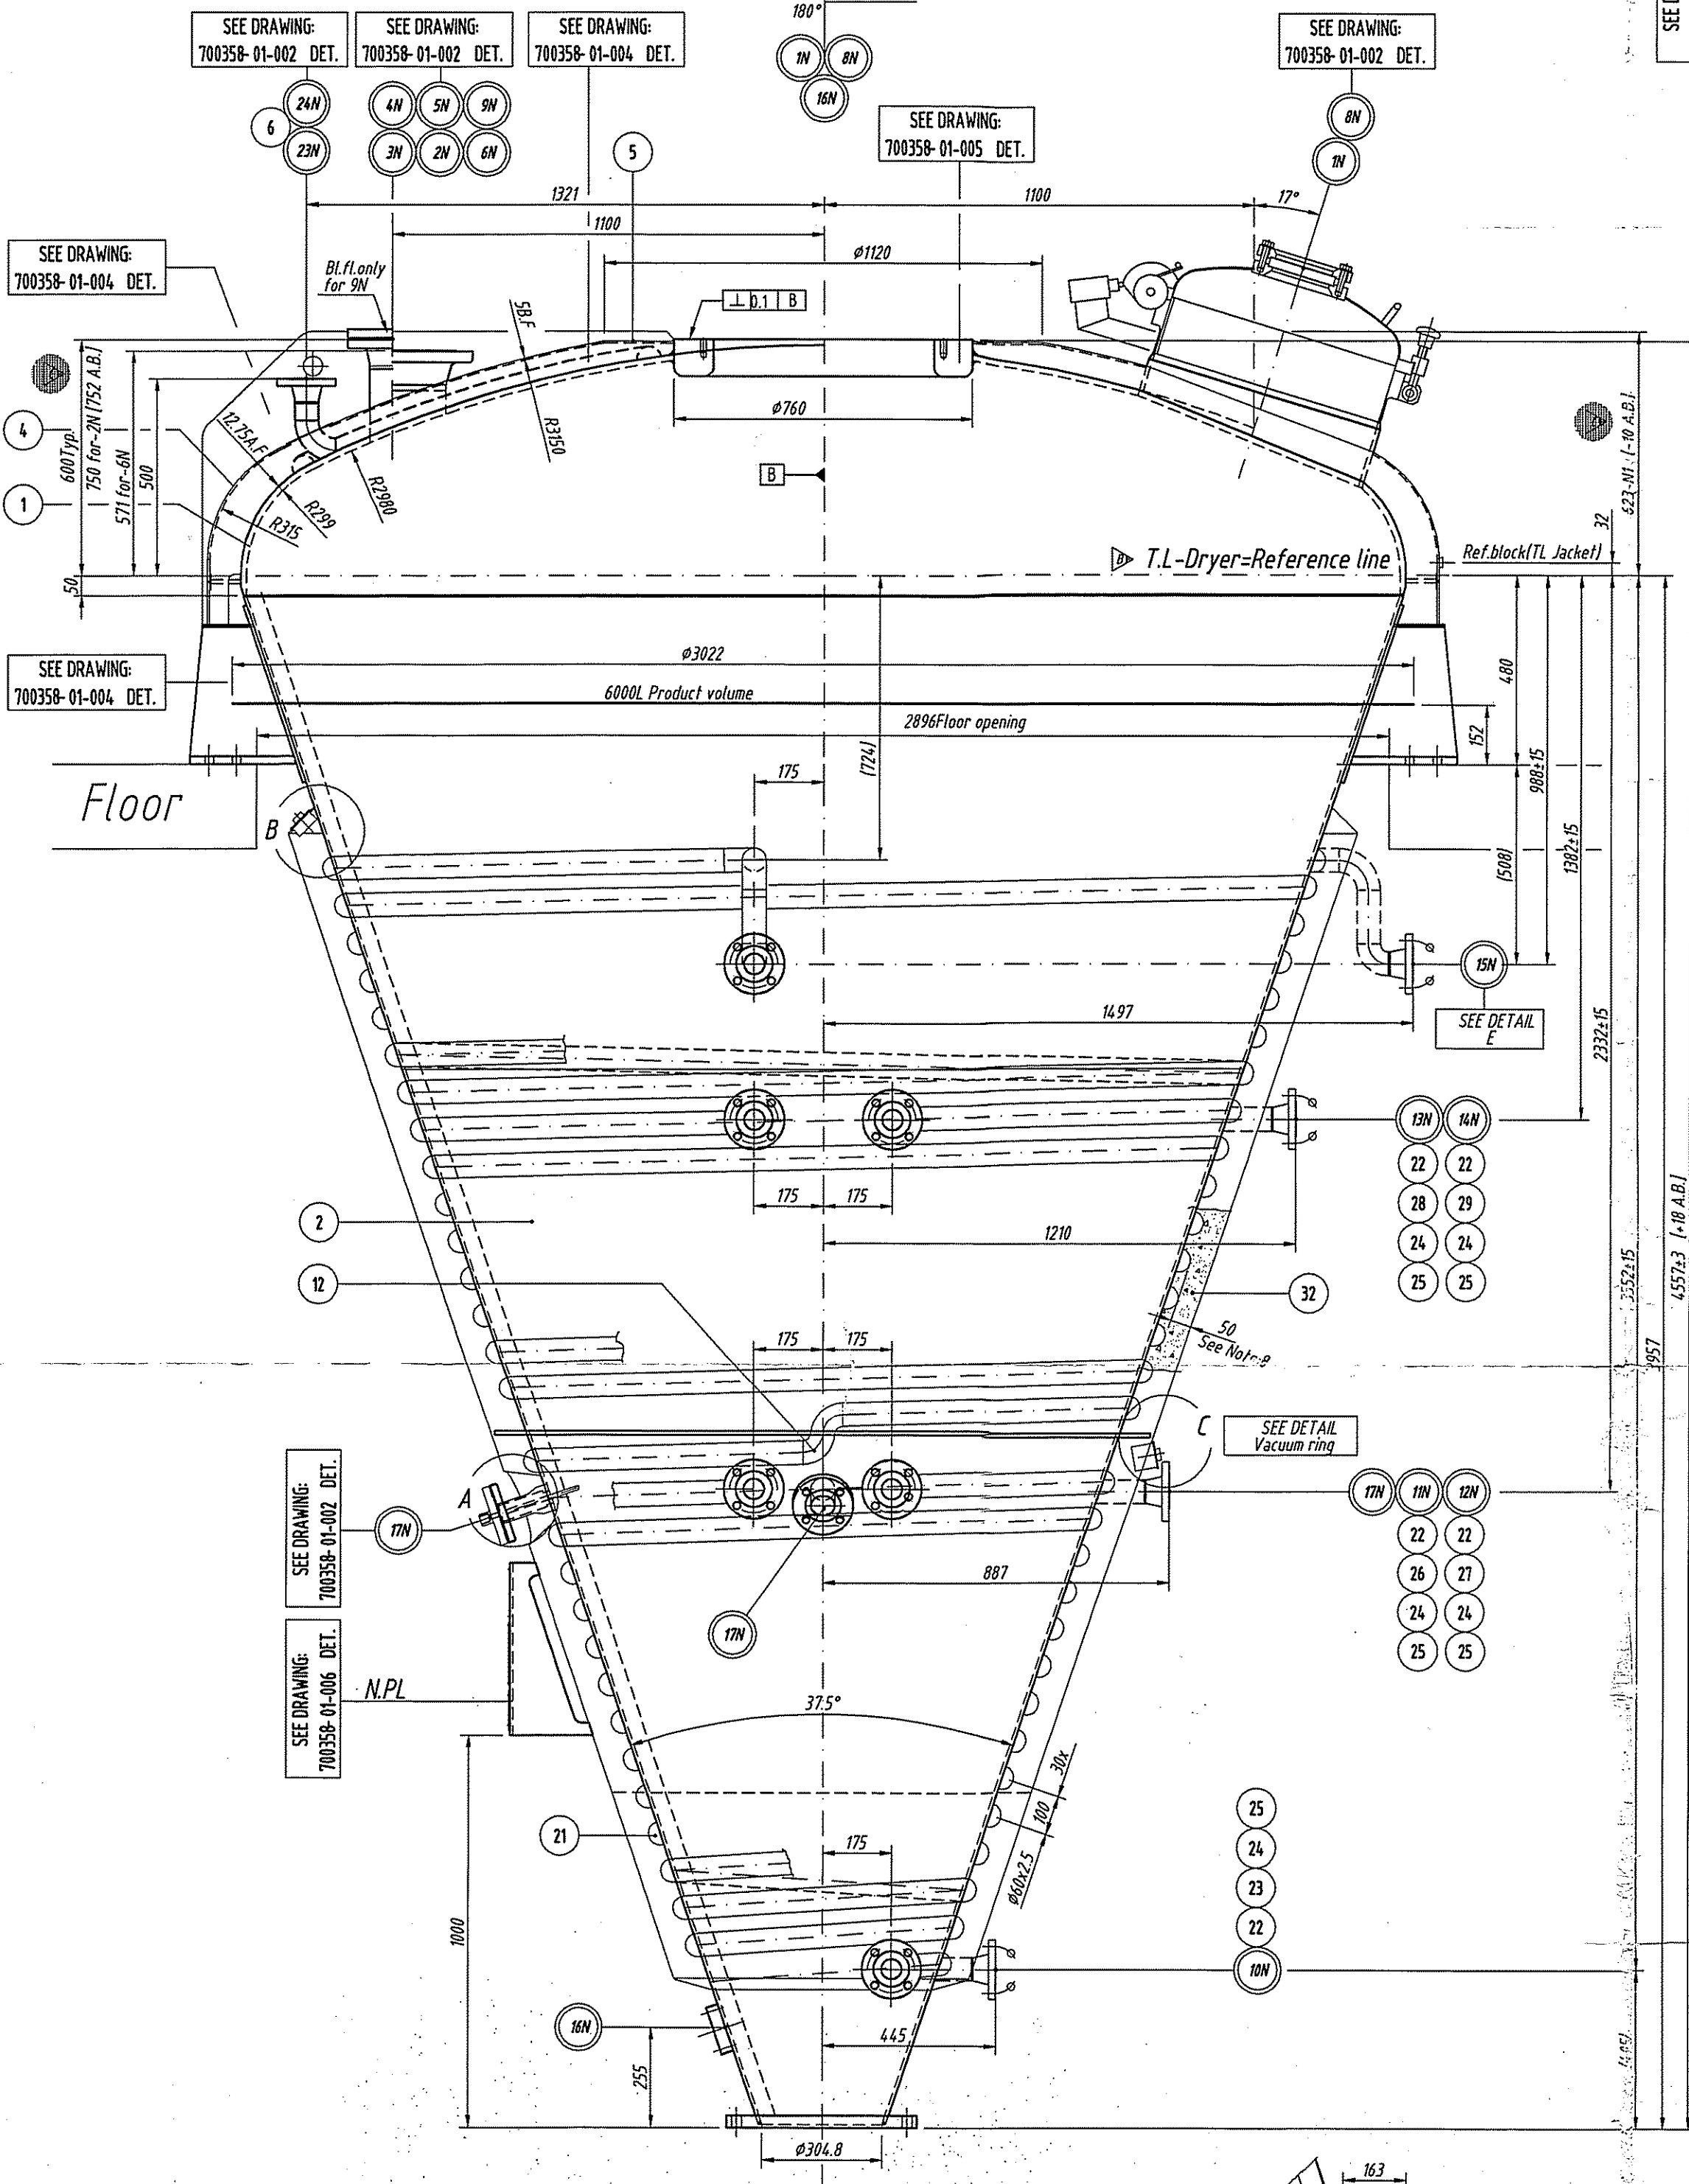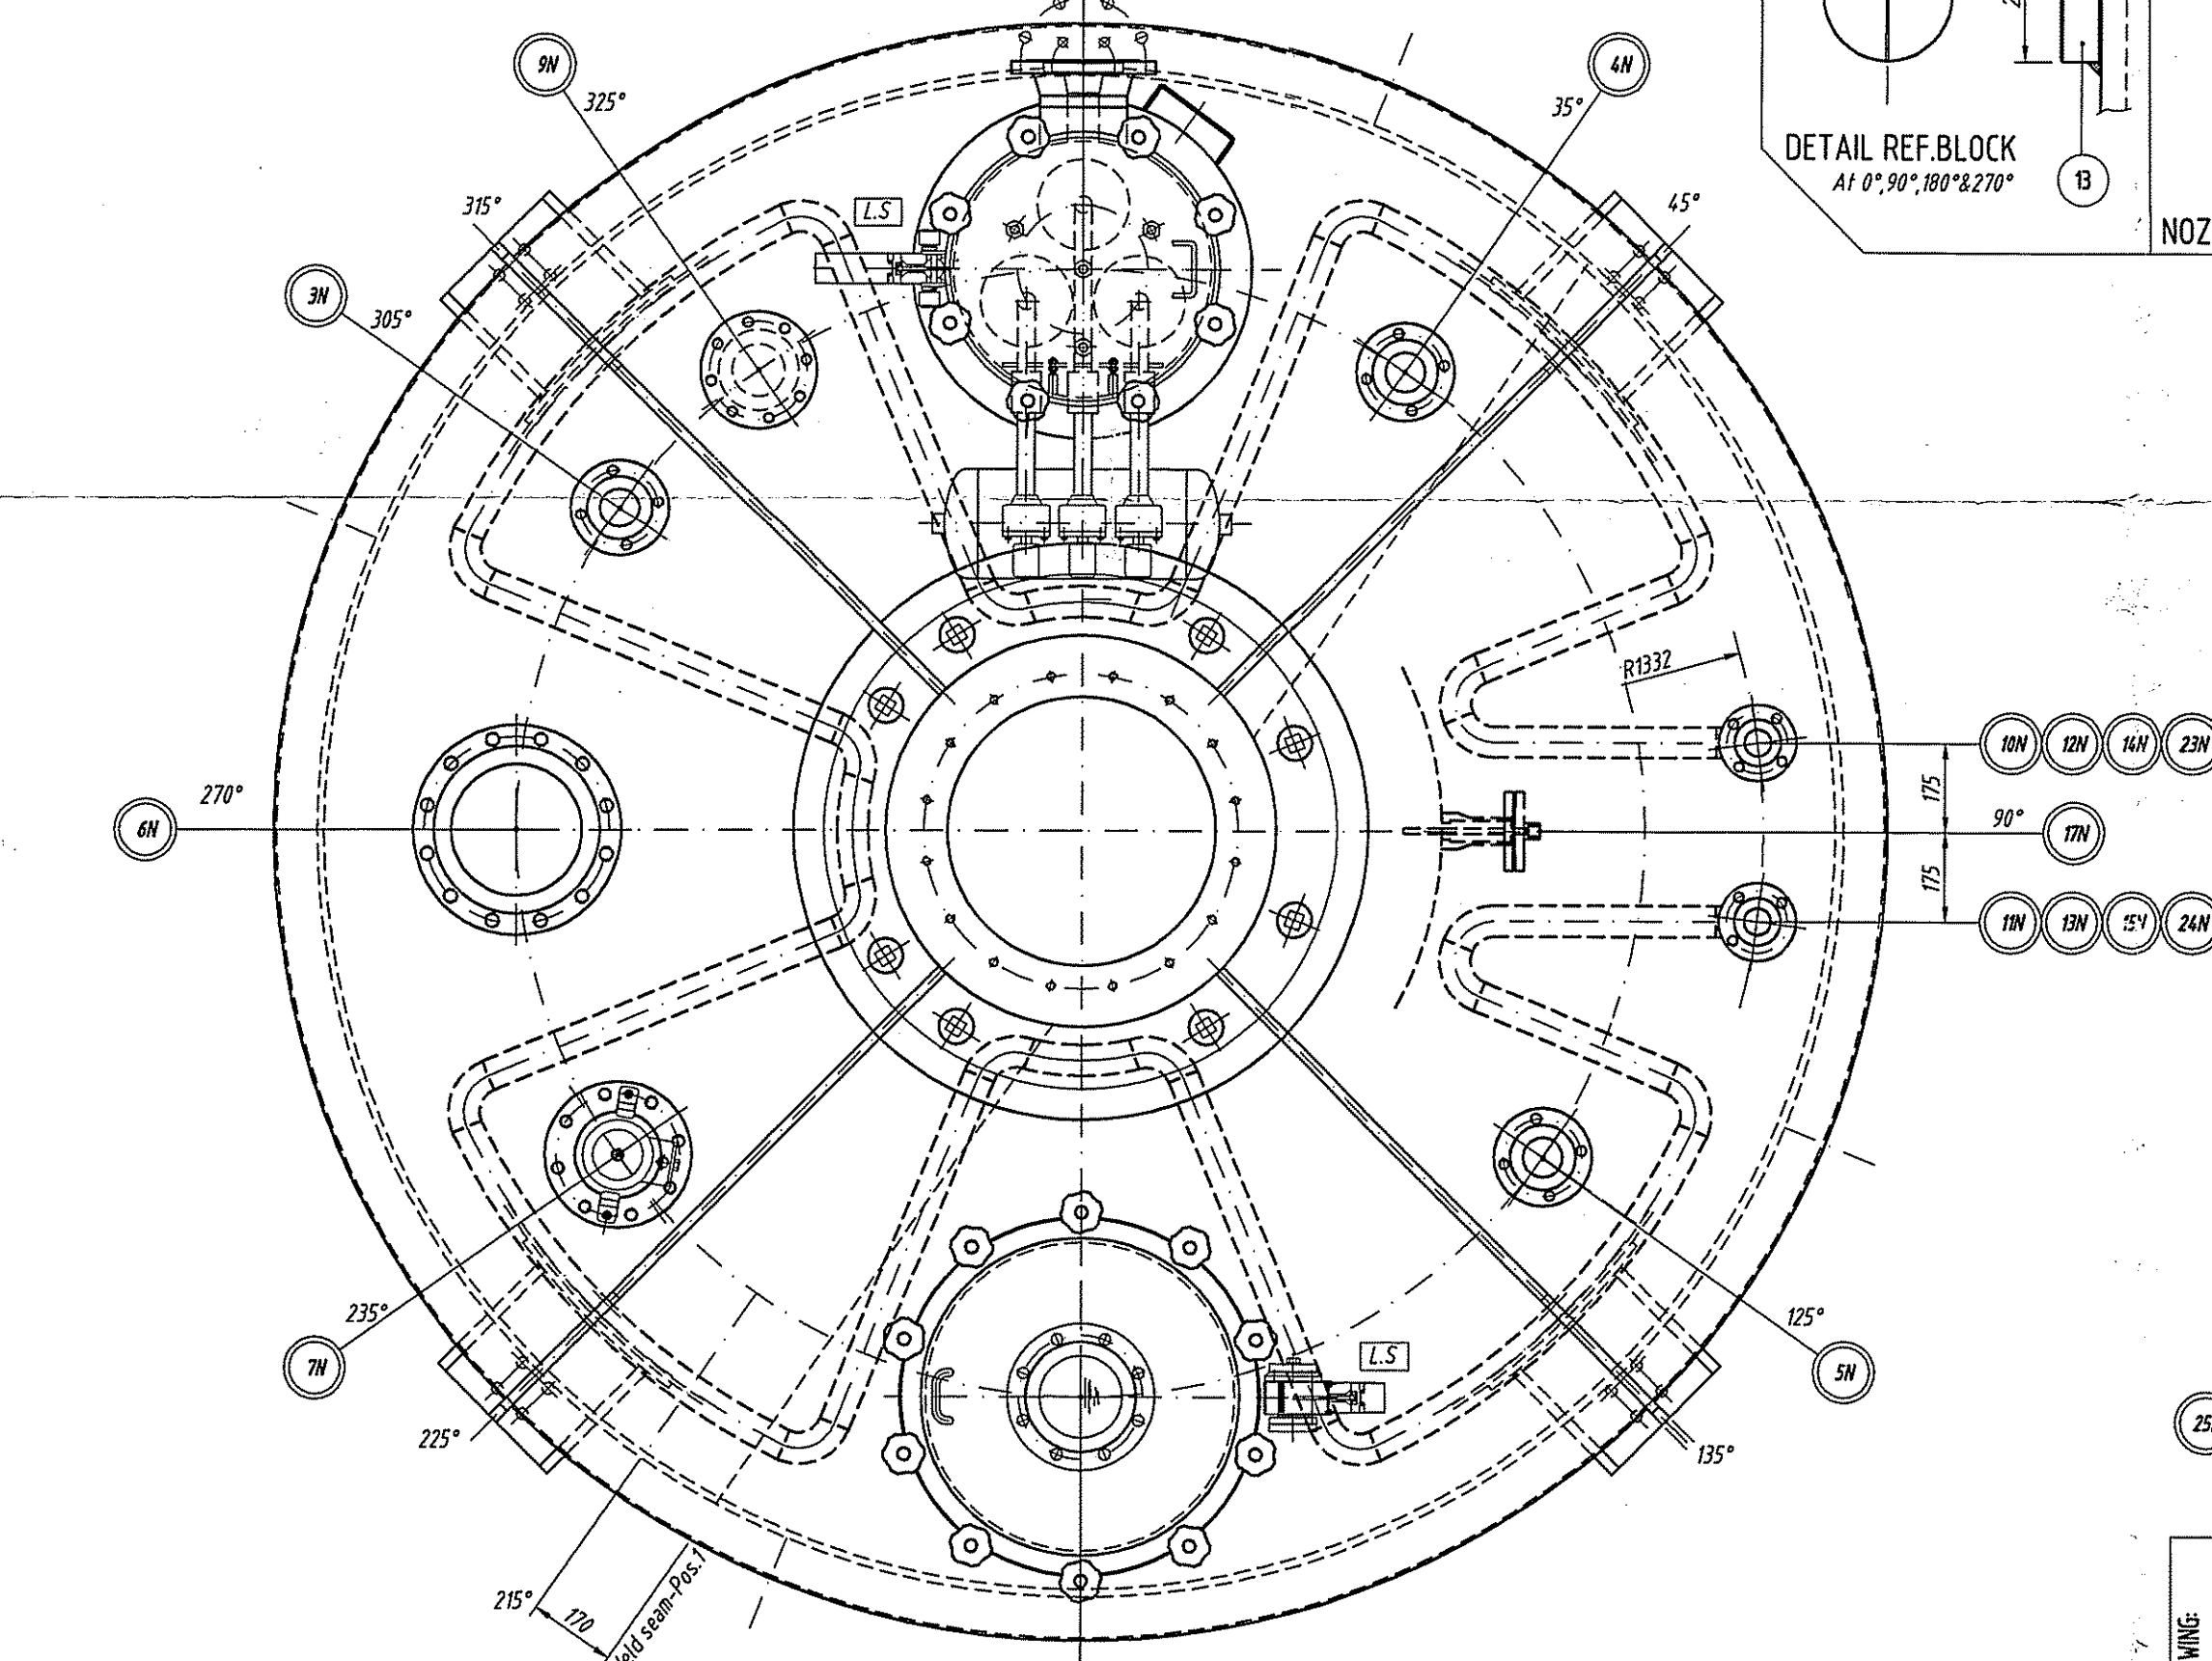

Unless otherwise stated tolerances according to ISO-2768 m for machined parts			Unless otherwise stated tolerances for vessel parts		
from	to	tol.	from	to	tol.
0.5	3	0.1	30	120	4
3	6	0.1	120	315	5
6	30	0.2	315	1000	6
30	120	0.3	1000	4000	6
120	400	0.5	4000	8000	8
400	1000	0.8			
1000	2000	1.2			
2000	4000	2			

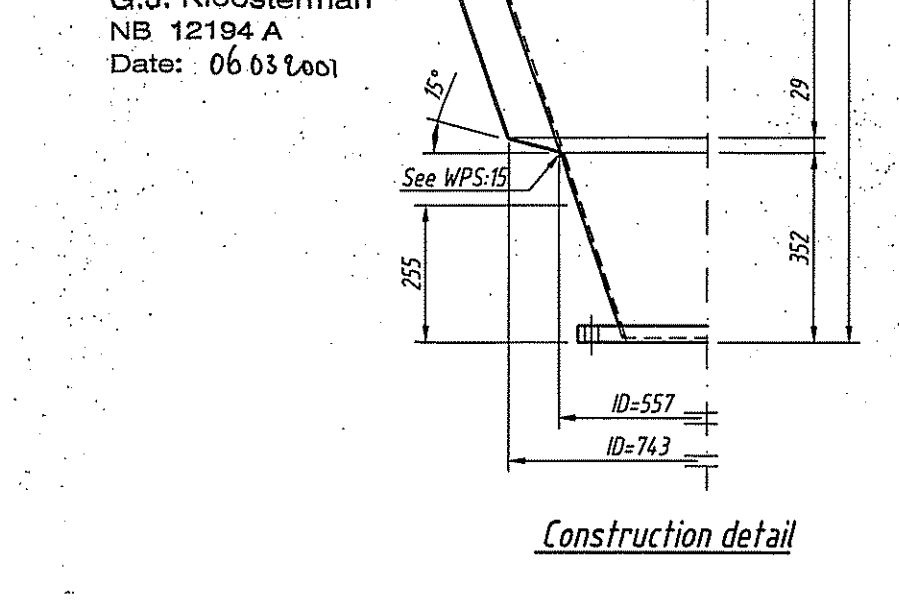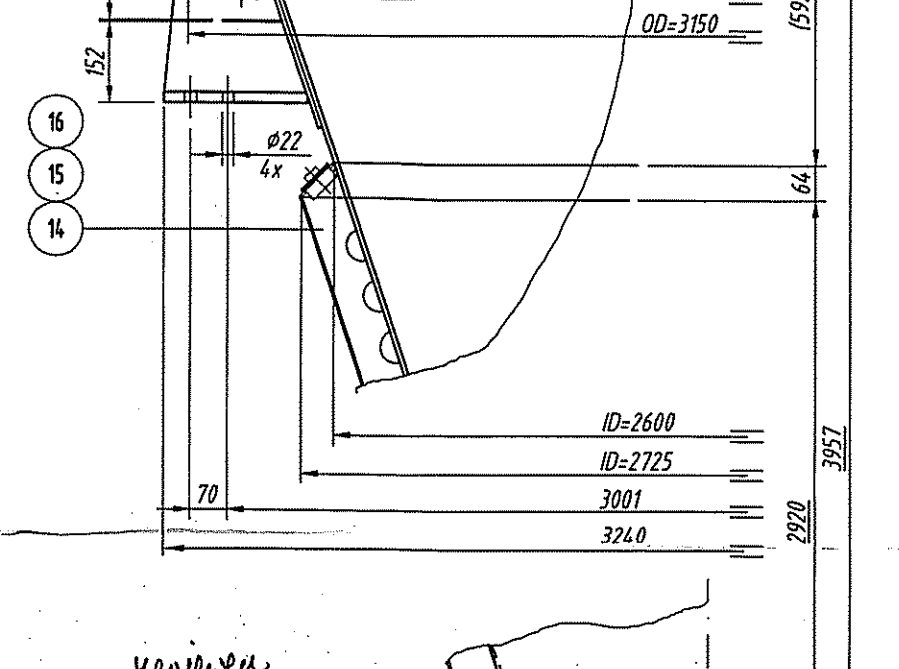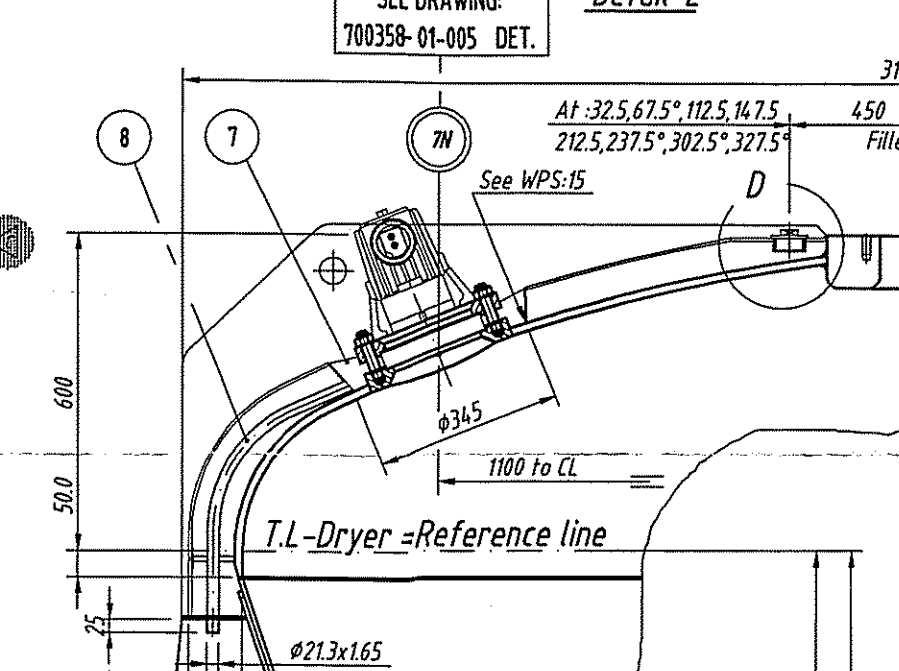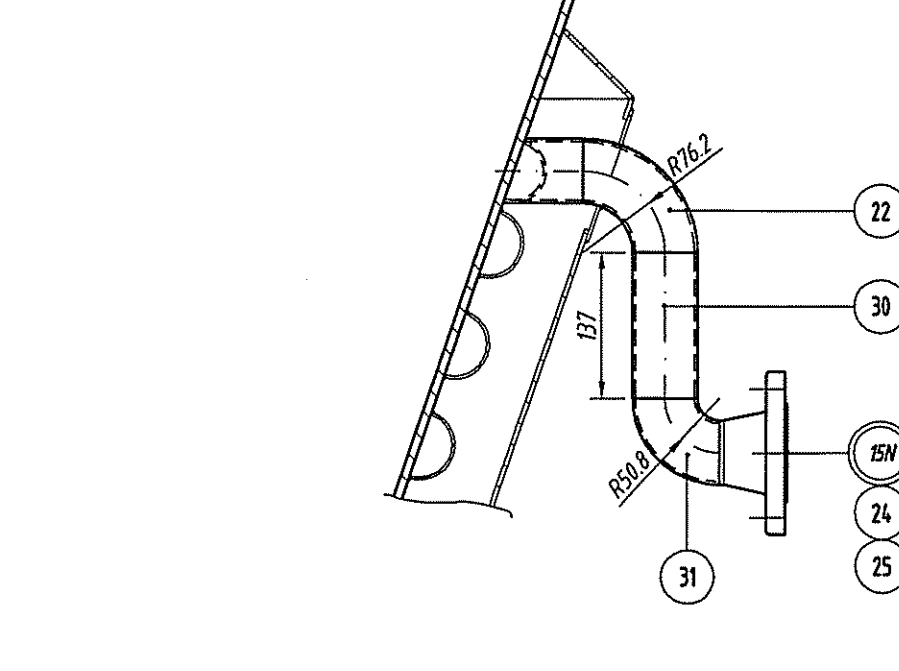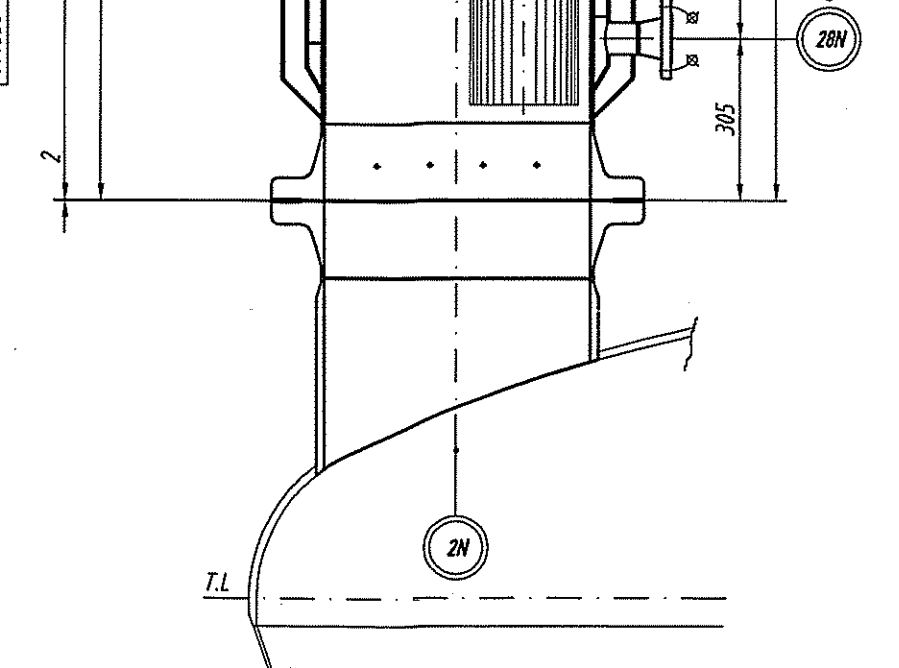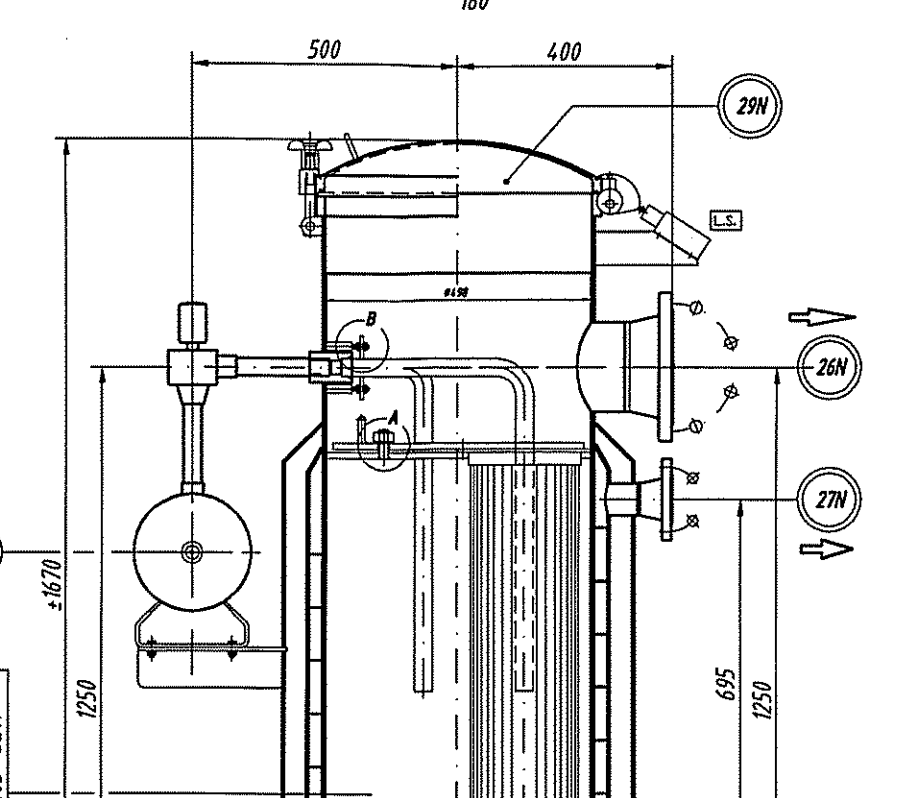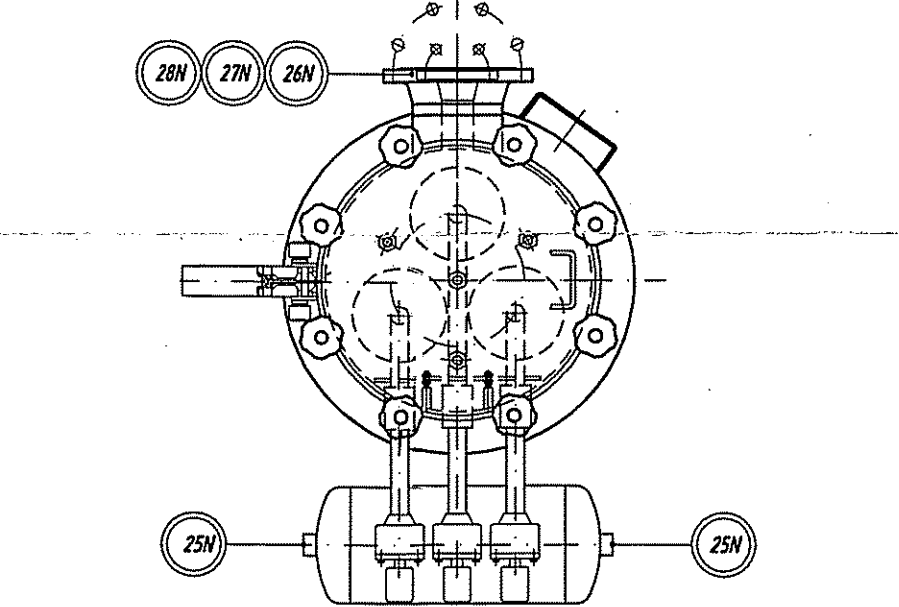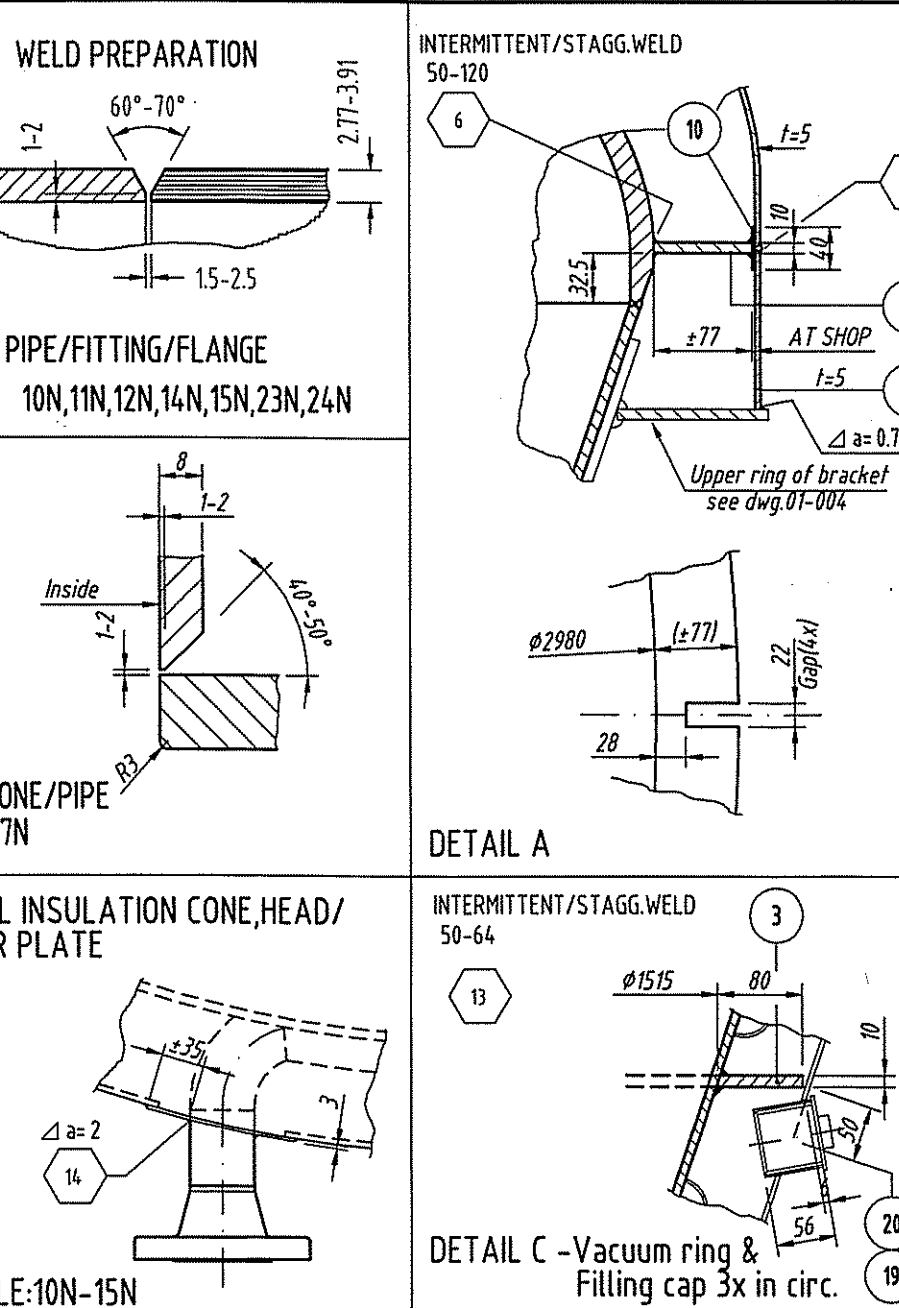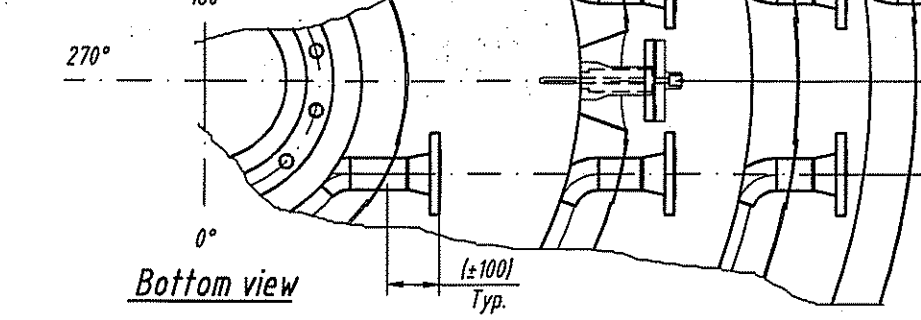

Mechanical data			
Design code	ASME sect. VIII - 198 Edition - 99 Addenda (U-STAMP)	Vessel	See note 1
Inspection	Lloyds / FIB	Design pressure	-14.5/75 Psi (-1/3 Barg)
Design temperature	300 °F (148.9 °C)	Operating pressure	-14.5/75 Psi (-1/3 Barg)
Operating temperature	300 °F (148.9 °C)	Test pressure	57.2 Psi (3.9 Barg)
Test pressure	57.2 Psi (3.9 Barg)	Volume	6 m³
Corrosion allowance	0	Corrosion rate	0 mm
Joint efficiency	See note 2	Design class	See note 3
X-ray	See note 4	Weight empty	17300 kg
Weight full of water	See note 5	Weighting method	See WPS
Surface treatment	SS	Surface treatment	All product/contracting parts Ra-10 mu
Tolerances according	FIB Tol.001	Flange gasket contact face finish	See note 6
Flange gasket contact face finish	See note 7	Flange gasket contact face finish	See note 8
Flange gasket contact face finish	See note 9	Flange gasket contact face finish	See note 10

Reference document list			
Document no.	Document name	Client document no.	
700358-01-200	Strength calculation	-	-
700358-01-250	WPS&PDR	-	-
700358-01-002	Nozzle details	-	-
700358-01-003	Filterhouse	-	-
700358-01-004	Detail Bracket, Lifting lugs, Dished cover	-	-
700358-01-005	Detail Agitator flange, Nozzle: 10N, 11N, 17N	-	-
700358-01-006	Nameplate	-	-

GENERAL NOTES			
1	This data applies for: Jacket on cone		
2	: Dished on the dished head		
3	: Jacket on filterhouse		
4	100% Wetted parts & 10% Non Wetted parts.		
5	Non lethal service		
6	Weight of machine: ca. 6500 kg weight of screw ca. 500 kg, Operation weight: 10820 kg		
7	Max. out of roundness acc. to UG-80		
8	Exempted from impact testing as per UHA-51(d)		
9	Insulation mineral: Perlite (By FIB)		
10	Clearance Mixer to cone: 8-12mm		

32	1	Peillets-H3 Ca2m3		Perilite No.2	
31	1	Elbow D=60.33x2.77 90G SR ASME B16.9		SA440WP-304L	3
29	1	Pipe welded D=60.33x2.77 L=107		SA312TP304L	3
29	1	Pipe welded D=60.33x2.77 L=Ca68		SA312TP304L	3
29	1	Pipe welded D=60.33x2.77 L=Ca68		SA312TP304L	3
29	1	Pipe welded D=60.33x2.77 L=Ca80		SA312TP304L	3
26	1	Pipe welded D=60.33x2.77 L=Ca80		SA312TP304L	3
25	6	Plate 3 D=150		SA240-304L	3
24	6	WORF Flange 2" 150N ASME B16.5 Rat.3-12.5mu s=2.77		SA182Y304L	3
23	1	Pipe welded D=60.33x2.77 L=Ca108		SA312TP304L	3
22	7	Elbow D=60.33x2.77 90G LR ASME B16.9		SA440L-WP304L	3
21	1	Plate 25 89x144.362		SA240-304L	3
20	3	Socket 2"BSP Male Avesta TypeB-201		AS1316	3
19	15	Plug 2"BSP Male Avesta TypeB-237		AS1316	3
18	12	Half Socket 2"BSP Male Avesta TypeB-203		AS1316	3
17	1	Plate 4 (Cone D=275x120 H=95)		SA240-304L	3
16	1	Plate 5 (Cone D=74.3x120-557 H=25)		SA240-304L	3
15	1	Plate 44 (Cone D=275x120 H=74.3 H=290)		SA240-304L	3
14	1	Plate 4 (Cone D=275x120-1600 H=62)		SA240-304L	3
13	4	Bar D=25 L=8		SA240-304	3
12	7	Half Elbow D=60.33x2.77 90G LR		SA440-WP304L	3
11	1	Plate 5 s=108x980		SA240-304L	3
10	1	Flxbar 40x13 L=9874		SA240-304L	3
9	1	Flxbar s=88x1 L=9619		SA240-304L	3
8	1	Pipe Welded D=73.3x1.65 L=690		SA312TP304L	3
7	1	Plate 4 (Cone D=649x120-354 H=70)		SA240-304L	3
6	2	Plate 3 D=150		SA240-304L	3
5	1	Plate 5 D=1120x1260		SA 240-304L	3
4	1	Head Isoperical D=350 r=0.87 L=0 L=1.58 H=4.5 ACCUGMWH		SA 240-304L	3
3	1	Flxbar 80x10 L=5011		SA240-304L	3
2	1	Plate 8 (Cone D=260x520-322 H=3893)		SA 240-304L	3
1	1	Head Isoperical D=2950 r=0.87 L=0 L=12.754 H=101.455 ACCUG-81		SA 240-304L	3
NEW/REVISION		DESCRIPTION / DIMENSION			MATERIAL
AS BUILT STATUS		AS BUILT STATUS CLIENT			AS BUILT STATUS NISP AUTHORITY
AS BUILT STATUS FIB					
Q	A	B	C	D	E
SCALE 1:50 DATE 02-10-2000					
DRAWN SAH/Handt					
CHECKED 1. deWit					
PROJECT Sature Mixers and Dryers,SPS Group					
SOFI CORP. P.O No:P00-0523					
SUBJECT Conical Dryer DF-600-VD2; Item:C7200					
General Arrangement					
FORM A0					
RECAL					
DRAWING 200359					
SHEET 01					