
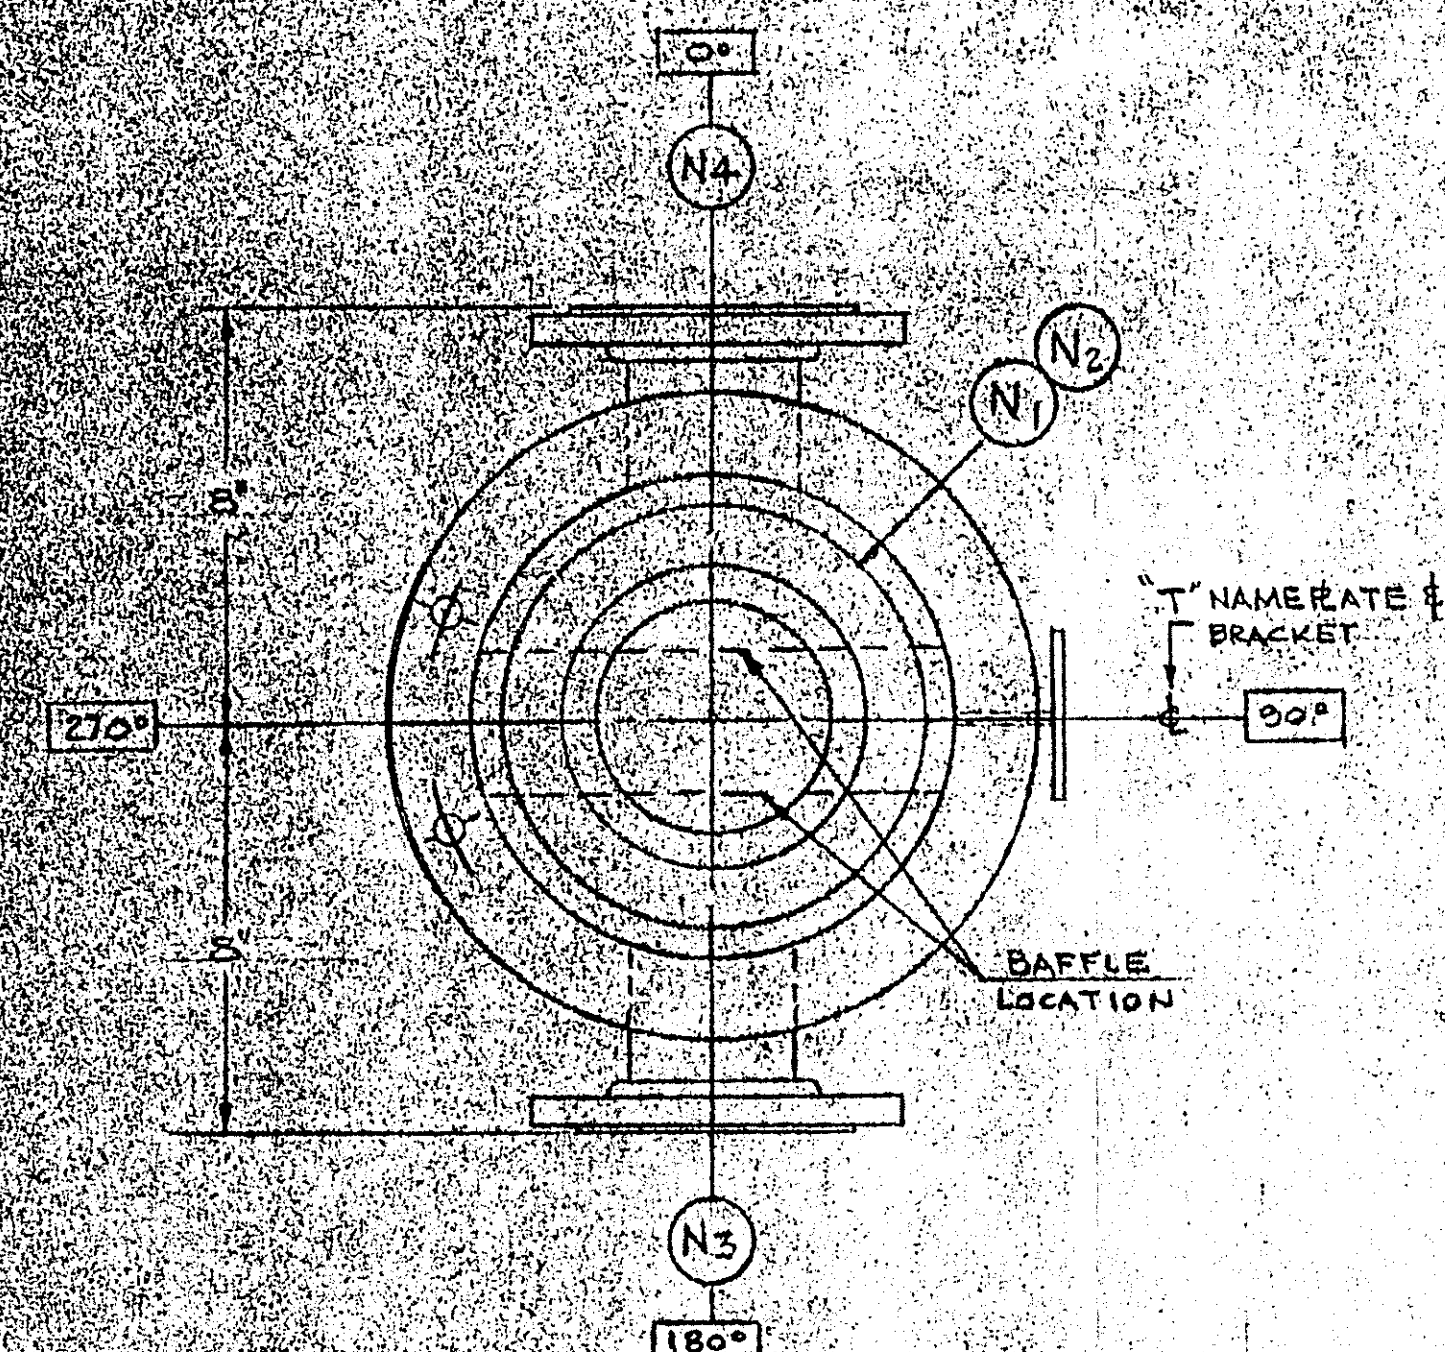


PERRY

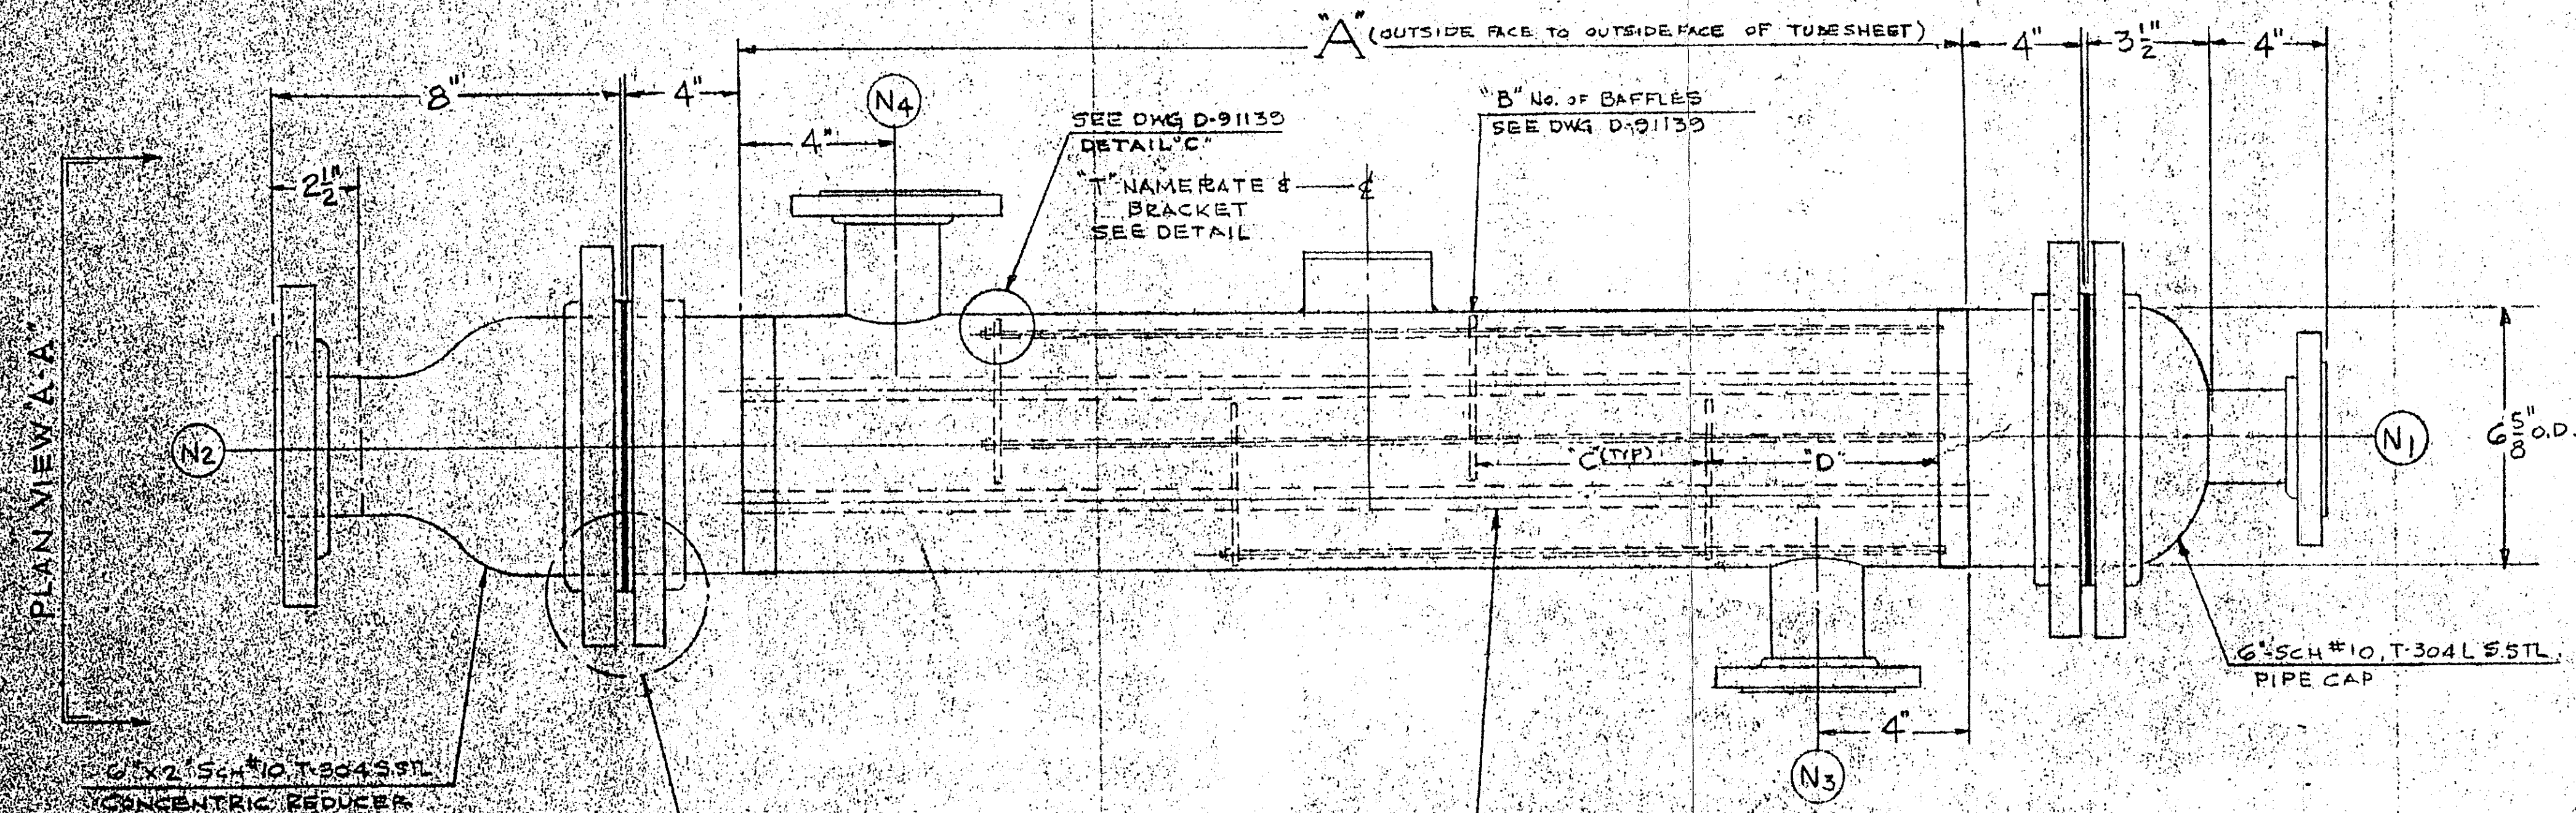

HEAT EXCHANGER SIZE				
SQ. FT.	"A"	"B"	"C"	"D"
22	4 1/16"	6	8 5/16"	8 3/16"

CENTER TO CENTER OF BAFFLES

FROM INSIDE FACE OF TUBESHEET

SOFIX CORPORATION
Chattanooga, TN 37406


APPROVAL DRAWINGS

- Not Acceptable. Not released for production. Revise and resubmit.
- Subject to revision as indicated. Released for production, submit Certified drawings.
- No exception taken. Released for production, submit Certified drawing.

CERTIFIED DRAWINGS

- Subject to revision as indicated. Released for production. Resubmit Certified drawings.
- Certified drawings accepted. Released for production, submit AS BUILT drawing.

By *[Signature]* Date *2/3/91*

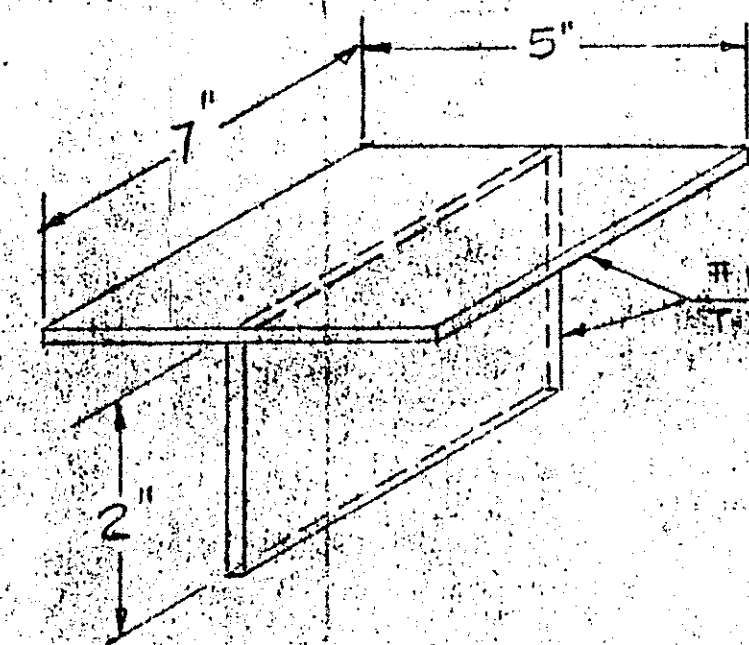

NAMEPLATE PLATE DETAIL

APPROVAL DRAWINGS

These drawings are sent to you for your approval or modification. NO CONSTRUCTION ON YOUR UNITS CAN BE STARTED UNTIL THESE DRAWINGS ARE APPROVED AND RETURNED TO US. PLEASE EXAMINE THEM CAREFULLY. NOTE ANY CHANGES IF NEEDED. INITIAL AND RETURN PROMPTLY.

NAME

COMPANY

DATE

SIMONS-EASTERN CONSULTANTS, INC.

P-5262A 001 OF 001

D-91133

SHIMIZU AMERICA CORP.

SOFIX CORPORATION

RECEIVED 25 JUN 91

EQ 31-00024

EQUIP # 10-3061

REVIEWED

FOR GENERAL COMPLIANCE WITH THE DESIGN CONCEPT OF THE PROJECT AND CONTRACT DOCUMENTS.

NO RESPONSIBILITY IS ASSUMED FOR CORRECTNESS OF THE DRAWINGS OR FOR THE RESULTS OF THE CONSTRUCTION.

BY *[Signature]* DATE *7/15/91*

NOT ACCEPTABLE. NOT RELEASED FOR PRODUCTION. REVISE AND RESUBMIT.

SUBJECT TO REVISION AS INDICATED. RELEASED FOR PRODUCTION. SUBMIT CERTIFIED DRAWINGS.

NO EXCEPTION TAKEN. RELEASED FOR PRODUCTION. SUBMIT CERTIFIED DRAWING.

CERTIFIED DRAWING ACCEPTED. RELEASED FOR PRODUCTION.

NOT RECORDED BY BRANCH FOR ENGINEERING DESIGN.

FITTING SCHEDULE				
MARK	SIZE	SCH.	RATING	DESCRIPTION
N-1	1"	10	150°	FLG. CONN. SEE DWG. D-ND-71, DETAIL 7-7
N-2	2"			D-ND-71
N-3	1"			
N-4	1"			

REFERENCE DWG'S

RETURN TO VENDOR

D-91133 HEAT EXCHANGER DETAILS

D-ND-71 NOZZLE DETAILS

CUSTOMER: SOFIX CORPORATION

TAG NO. C-9081

PERRY PRODUCTS CORPORATION

MOUNT LAUREL ROAD • HAINESPORT, NEW JERSEY 08036

DRN. *[Signature]*
DATE *6/10/91*
CHKD. *[Signature]*

SER. NO. B-4623

JOB NO. 13969

DWG. NO. D-91133

NO.	DATE	BY	REVISIONS
1			

THIS DRAWING IS THE PROPERTY OF PERRY PRODUCTS CORP. AND IS NOT TO BE REPRODUCED, COPIED, OR IN ANY MANNER. ANY INFORMATION SHOWN HEREON IS TO BE KEPT IN CONFIDENCE WITHOUT DISCLOSURE TO ANY OTHER PARTY.

114491