

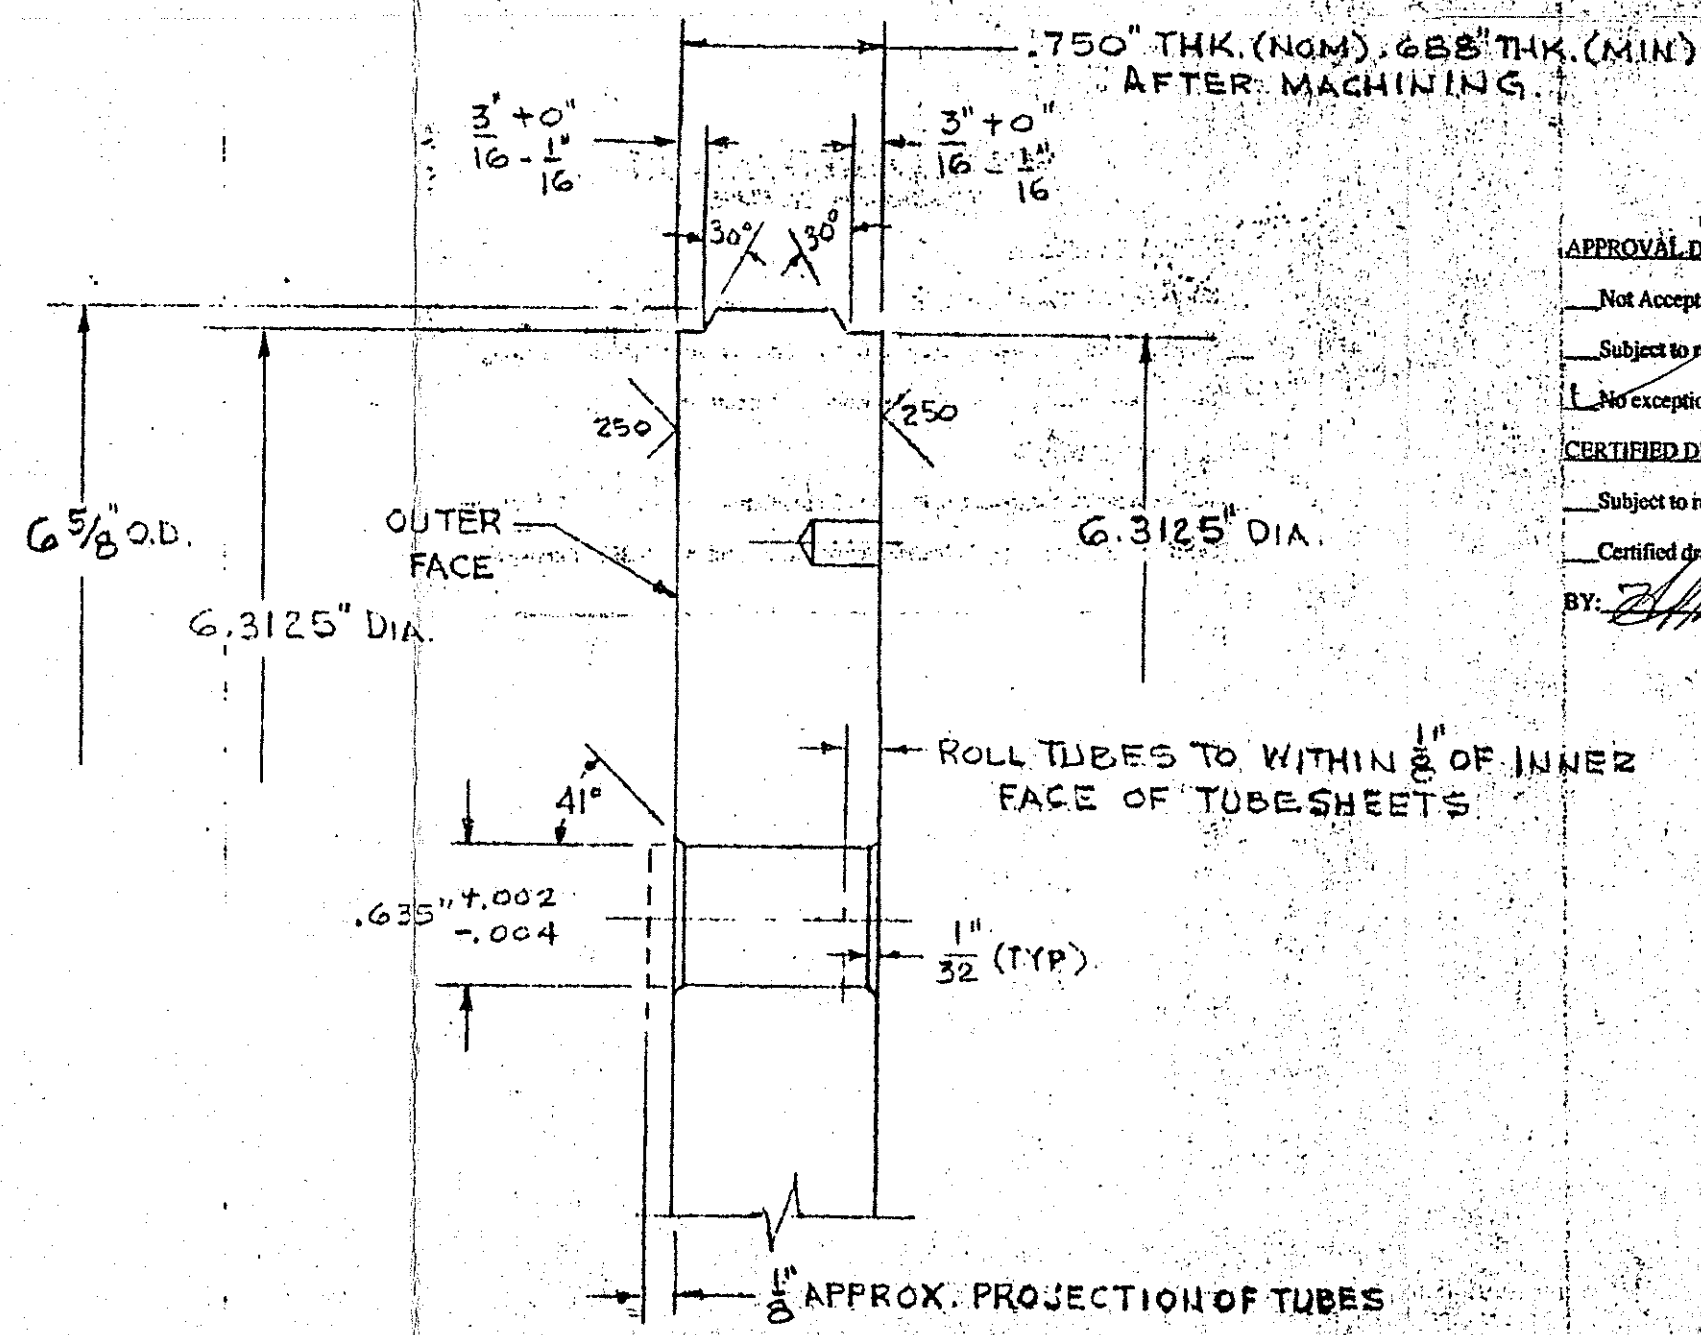
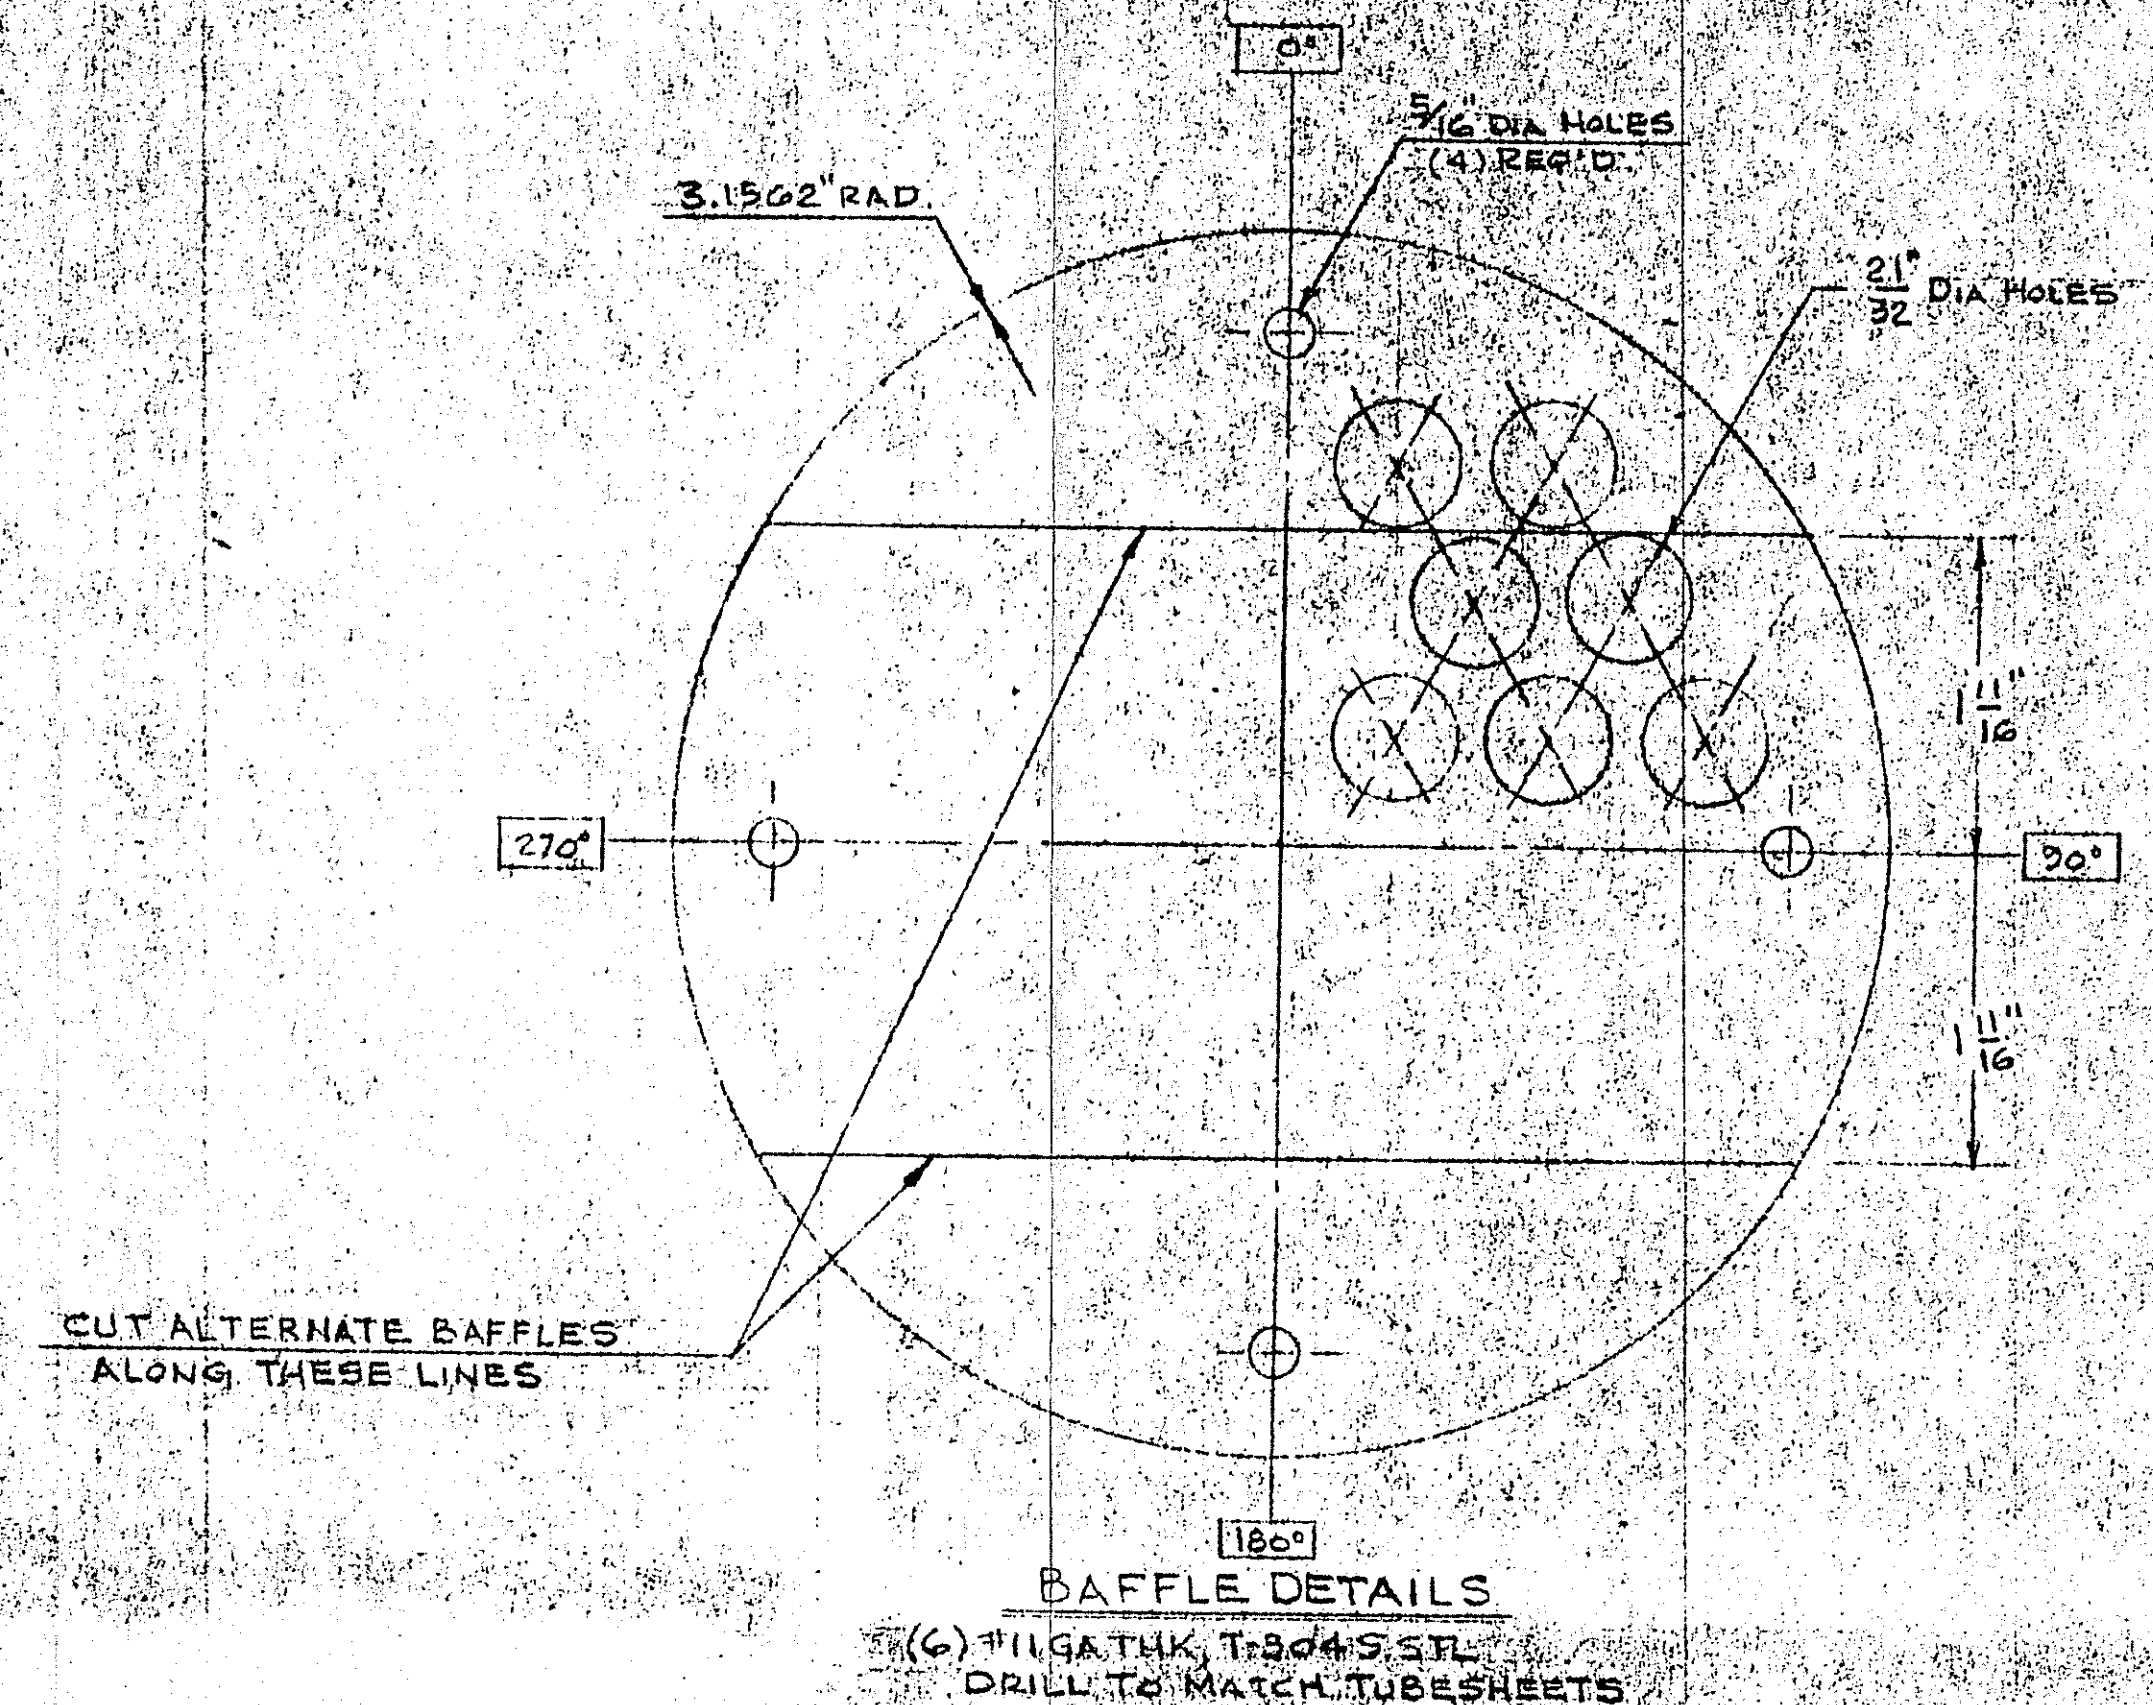
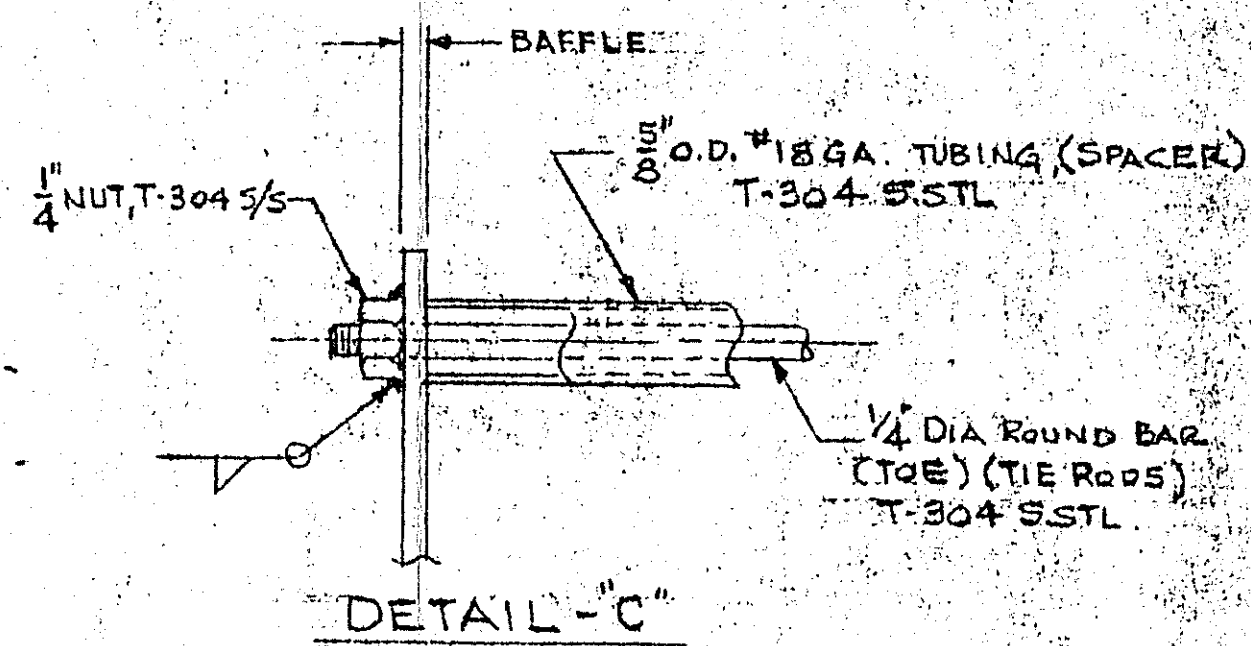
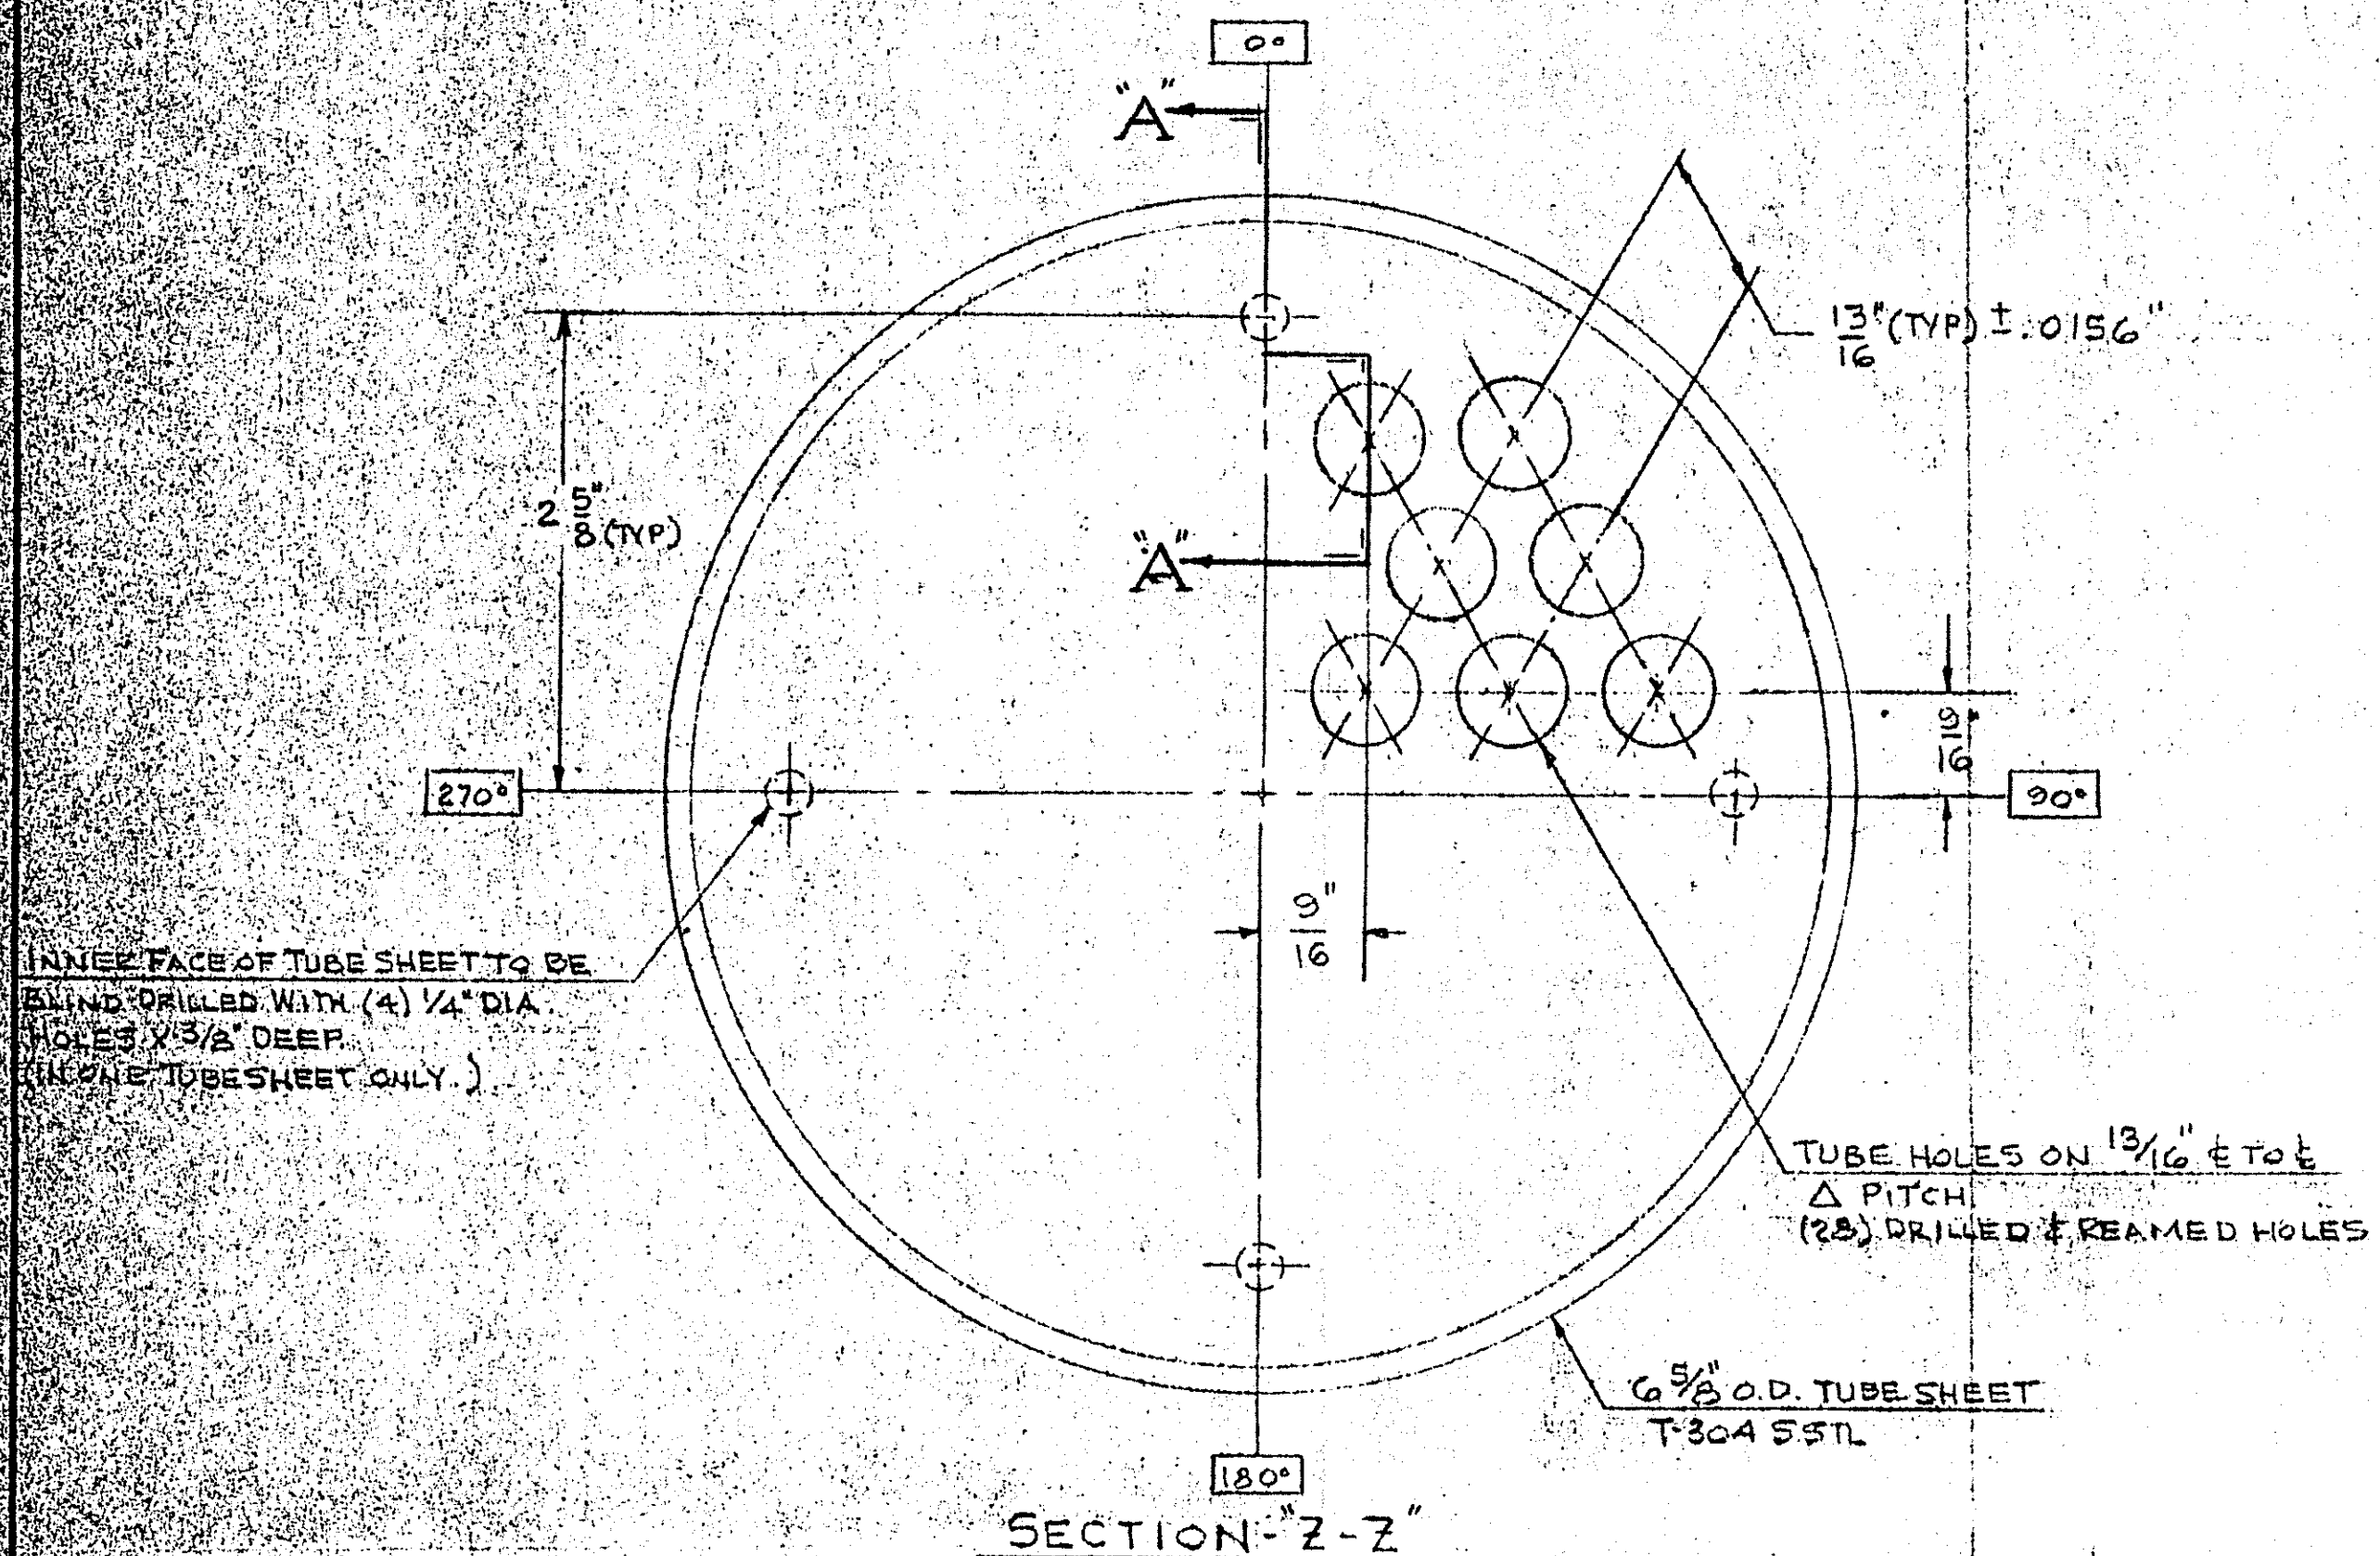


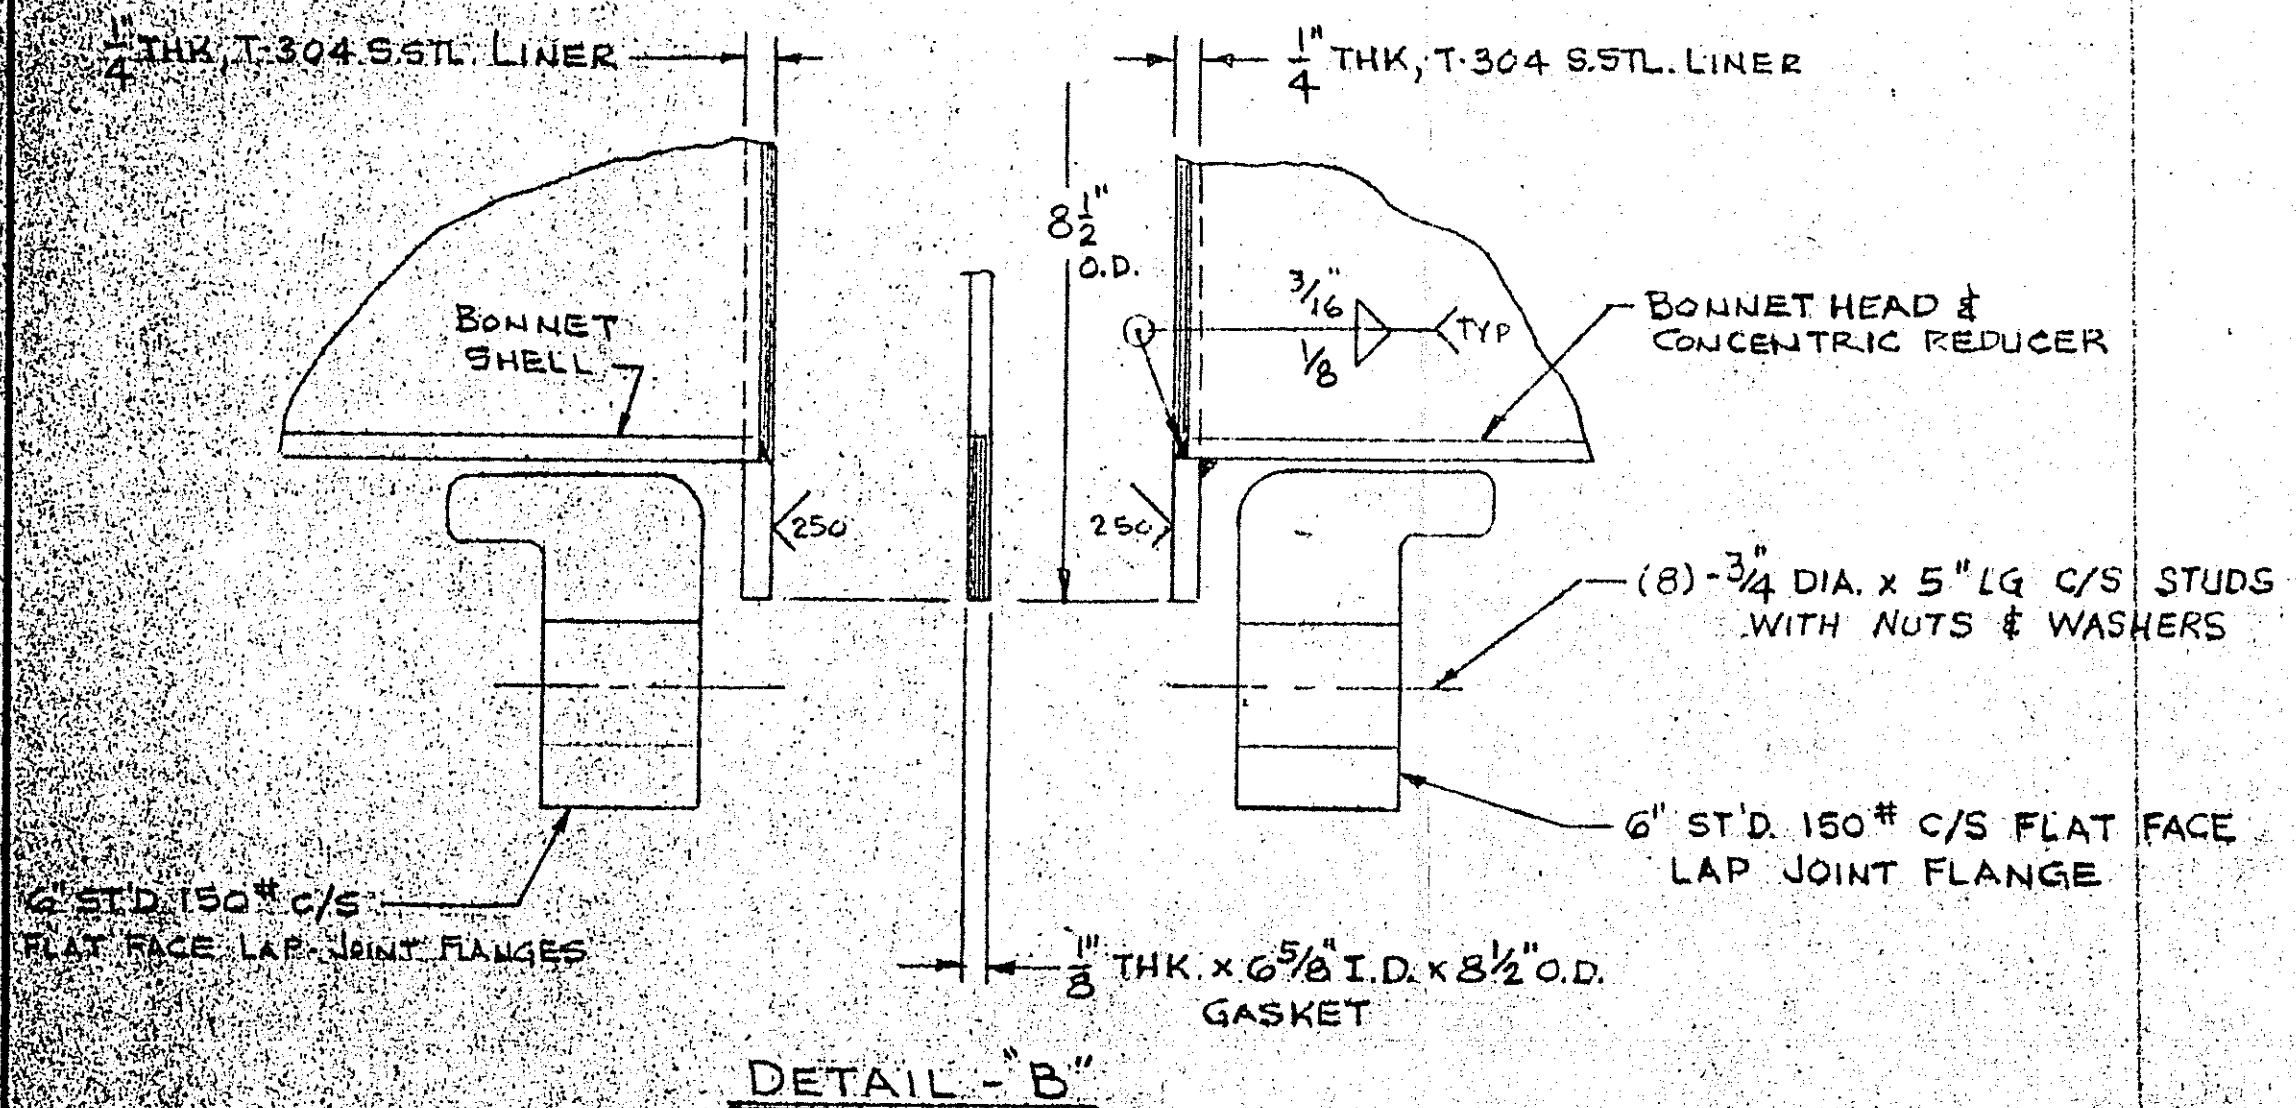

SOFIX CORPORATION
Chattanooga, TN 37406

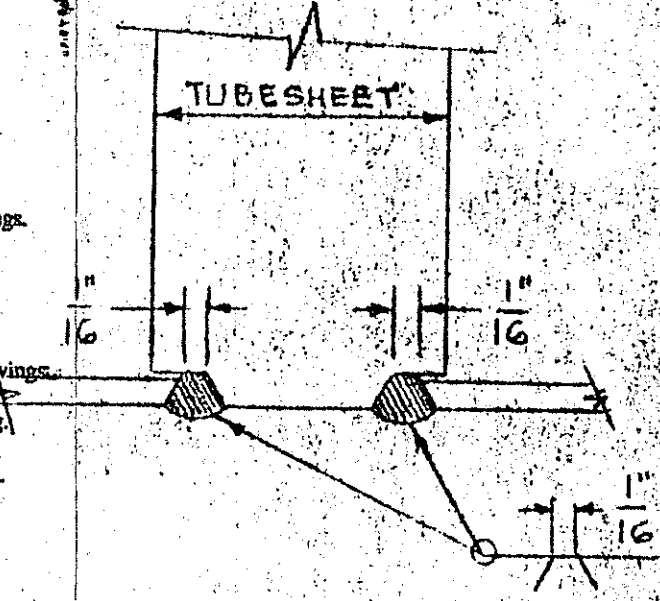

SHIMIZU AMERICA CORP.
This review involves General Confidentiality with the OGC's Classification and
Protect and with information given in the Contract. It is not to be shown
the submitted by SHIMIZU is not to be interpreted as a denial of investigation
of information provided in the submitted or as approval of the information
requirements of the Contract Documents.

☒ APPROVED AS SUBMITTED
☐ APPROVED AS INDICATED
☐ REVISE AND RESUBMIT
☒ REJECTED, RESUBMIT

DATE _____
BY _____

[illegible]

RETURN TO VENDOR

PERRY PRODUCTS CORPORATION

MOUNT LAUREL ROAD • HAINESPORT, NEW JERSEY 08036

DRN. <u>143</u>	6" TUBESHEET LAYOUT WITH DETAILS		
DATE <u>6/10/51</u>	5/8" TUBES ON A 3/4" Δ PITCH		
CHKD. <u>MMH</u>			
SER. NO. <u>B-4623</u>	JOB NO. <u>543</u>	DWG. NO. <u>D-5113-9</u>	

THIS DRAWING IS THE PROPERTY
OF PERAY PRODUCTS CORP. AND
IS NOT TO BE DUPLICATED. ANY
INFORMATION SHOWN HEREIN IS
NOT TO BE DISCLOSED WITHOUT
WRITTEN PERMISSION.